

THIS MAP WAS PREPARED FOR
ASSESSMENT PURPOSE ONLY

NW1/4 NE1/4 SECTION 19 T.09S. R.40E. W.M. BAKER COUNTY


Gr-17251

1" = 100'



SEE MAP 09S 40E 18

09S 40E

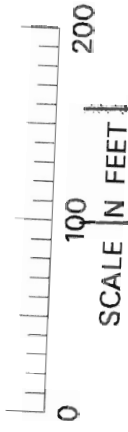

1/4 COR.

1/16 COR.

CAN
300
400

ALPINE

LANE

100
4.54 AC.

7

101
4.54 AC.

8

102
4.54 AC.

9

103
4.54 AC.

10

ALPINE

ESTATES

5-32

PHASE 2

NORTHWEST

GAS

CHEVRON OIL PIPELINE EASE.
(SALT LAKE LINE)

SEE MAP 09S 40E 19BA

SEE MAP 09S 40E 19AA

ST. ESTES (VAC.) STREET STREET STREET STREET STREET

HAZEL STREET (VAC.)

MAY STREET (VAC.)

JOSEPHINE STREET (VAC.)

EMILY STREET (VAC.)

25	200	24	25	500	24	25	600	24	25
26	4.21 AC.	23	26	4.74 AC.	23	26	8.65 AC.	23	26
27		22	27		22	27		22	27
28		21	28		21	28		21	28
29		20	29		20	29		20	29
30		19	30		19	30		19	30
31		18	31		18	31		18	31
32		17	32		17	32		17	32
33		16	33		16	33		16	33
34		15	34		15	34		15	34
35		14	35		14	35		14	35
36		13	36		13	36		13	36
37		12	37		12	37		12	37
38		11	38		11	38		11	38
39		10	39		10	39		10	39
40		9	40	SEE CS 9-40-	9	40		9	40
41		8	41		8	41		8	41
42		7	42		7	42		7	42
43		6	43		6	43		6	43
44		5	44		5	44		5	44
45		4	45		4	45		4	45
46		3	46		3	46		3	46
47		2	47		2	47		2	47
48		1	48		1	48		1	48

LACKMERS

5

4

EASEMENT

DR.

GREENRIDGE

DR.

GRACE STREET

Well #1 (BAKE 50139) located:
1190' S & 1155' E fr. N 1/4 corner Sect. 19

SEE MAP 09S 40E 19AC

RECEIVED

AUG 05 2009

WATER RESOURCES DEPT
SALEM, OREGON

PRINTED
01/25/09

09S 40E 19