

SECTION PLAT

Section 16, 21, 22, 23

Township 23 S.


Range 33 E

County of HARNEY

State of ORE.

● - wells

NORTH

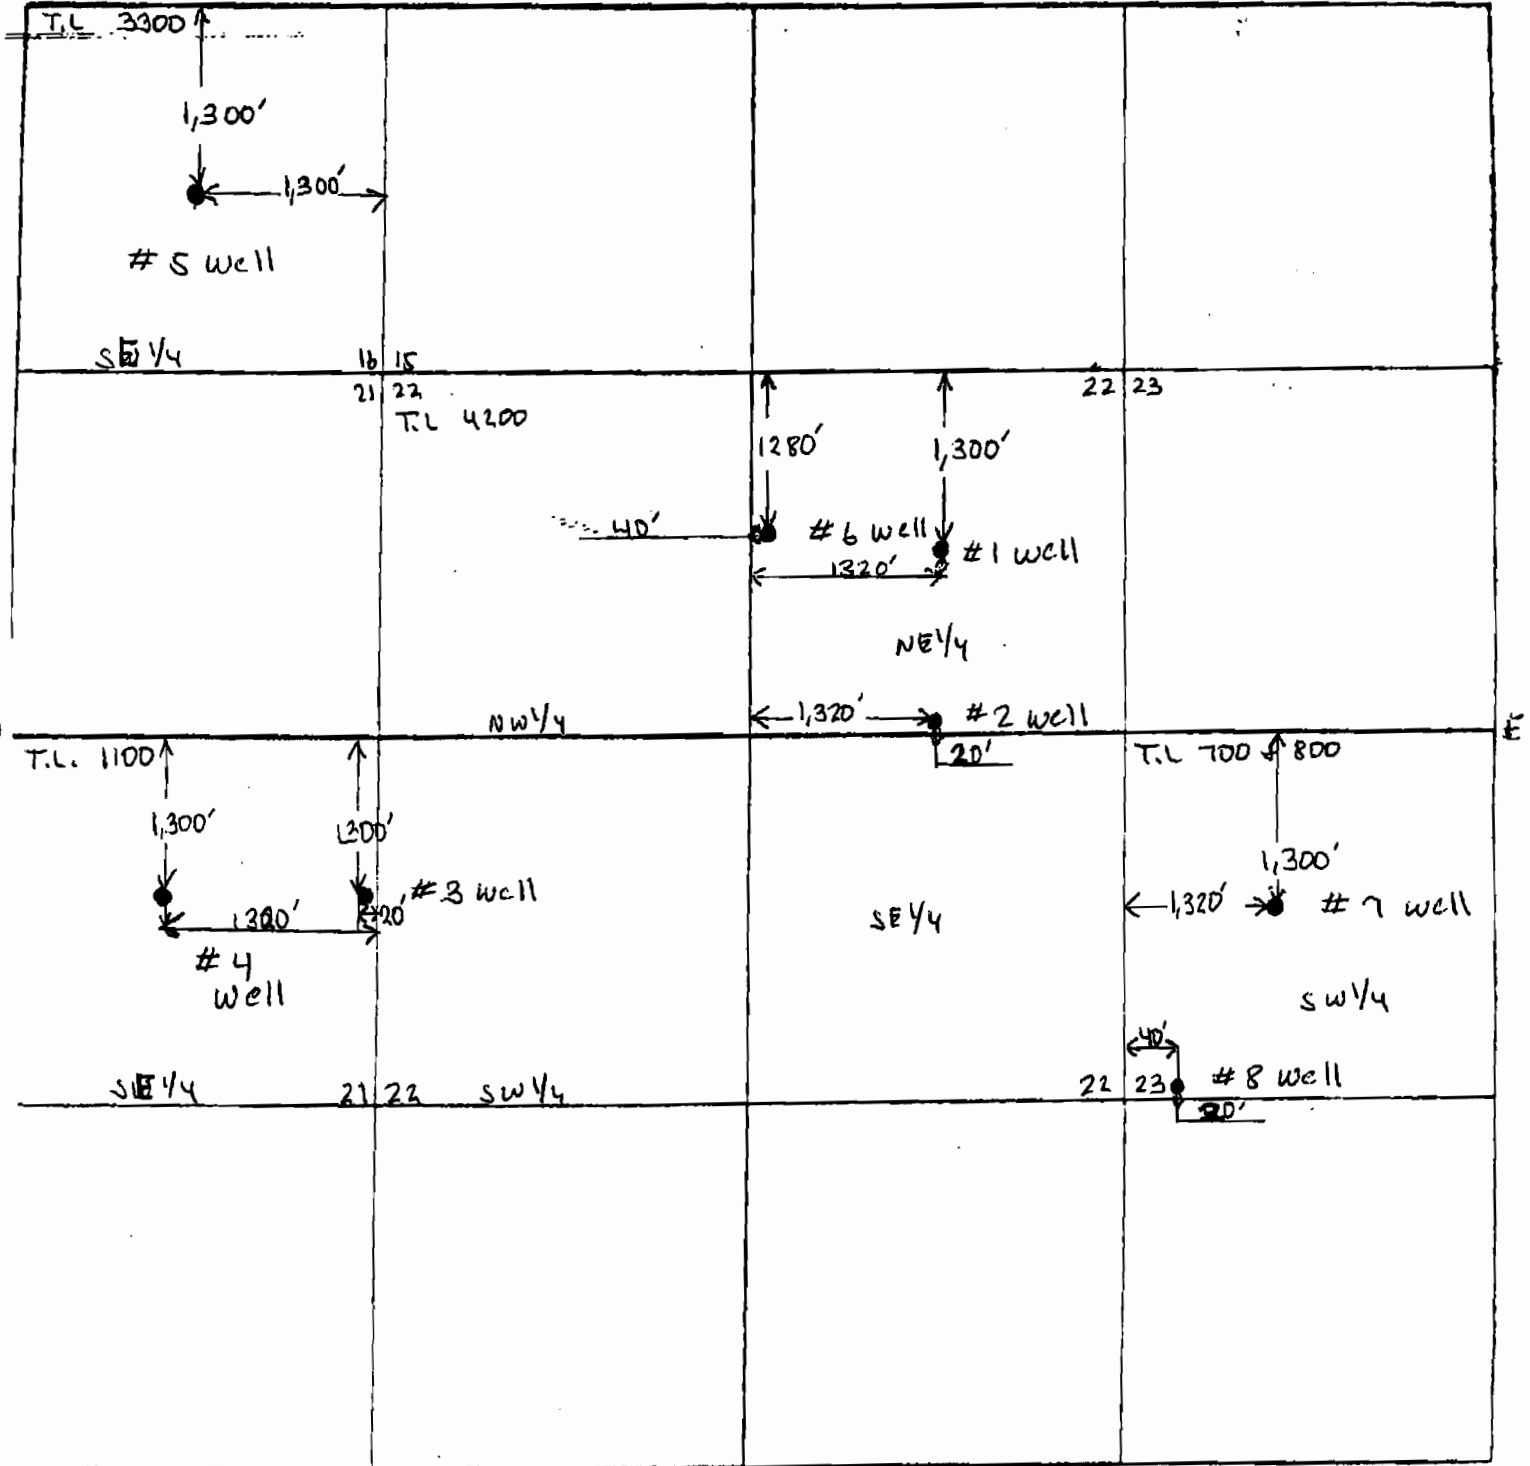

RECEIVED

AUG 06 2009

WATER RESOURCES DEPT
SALEM, OREGON

SECTION PLAI

947249

Section 16, 21, 22, 23


Township 23-5

Range 33-E

County of Harney

State of OR

NORTH

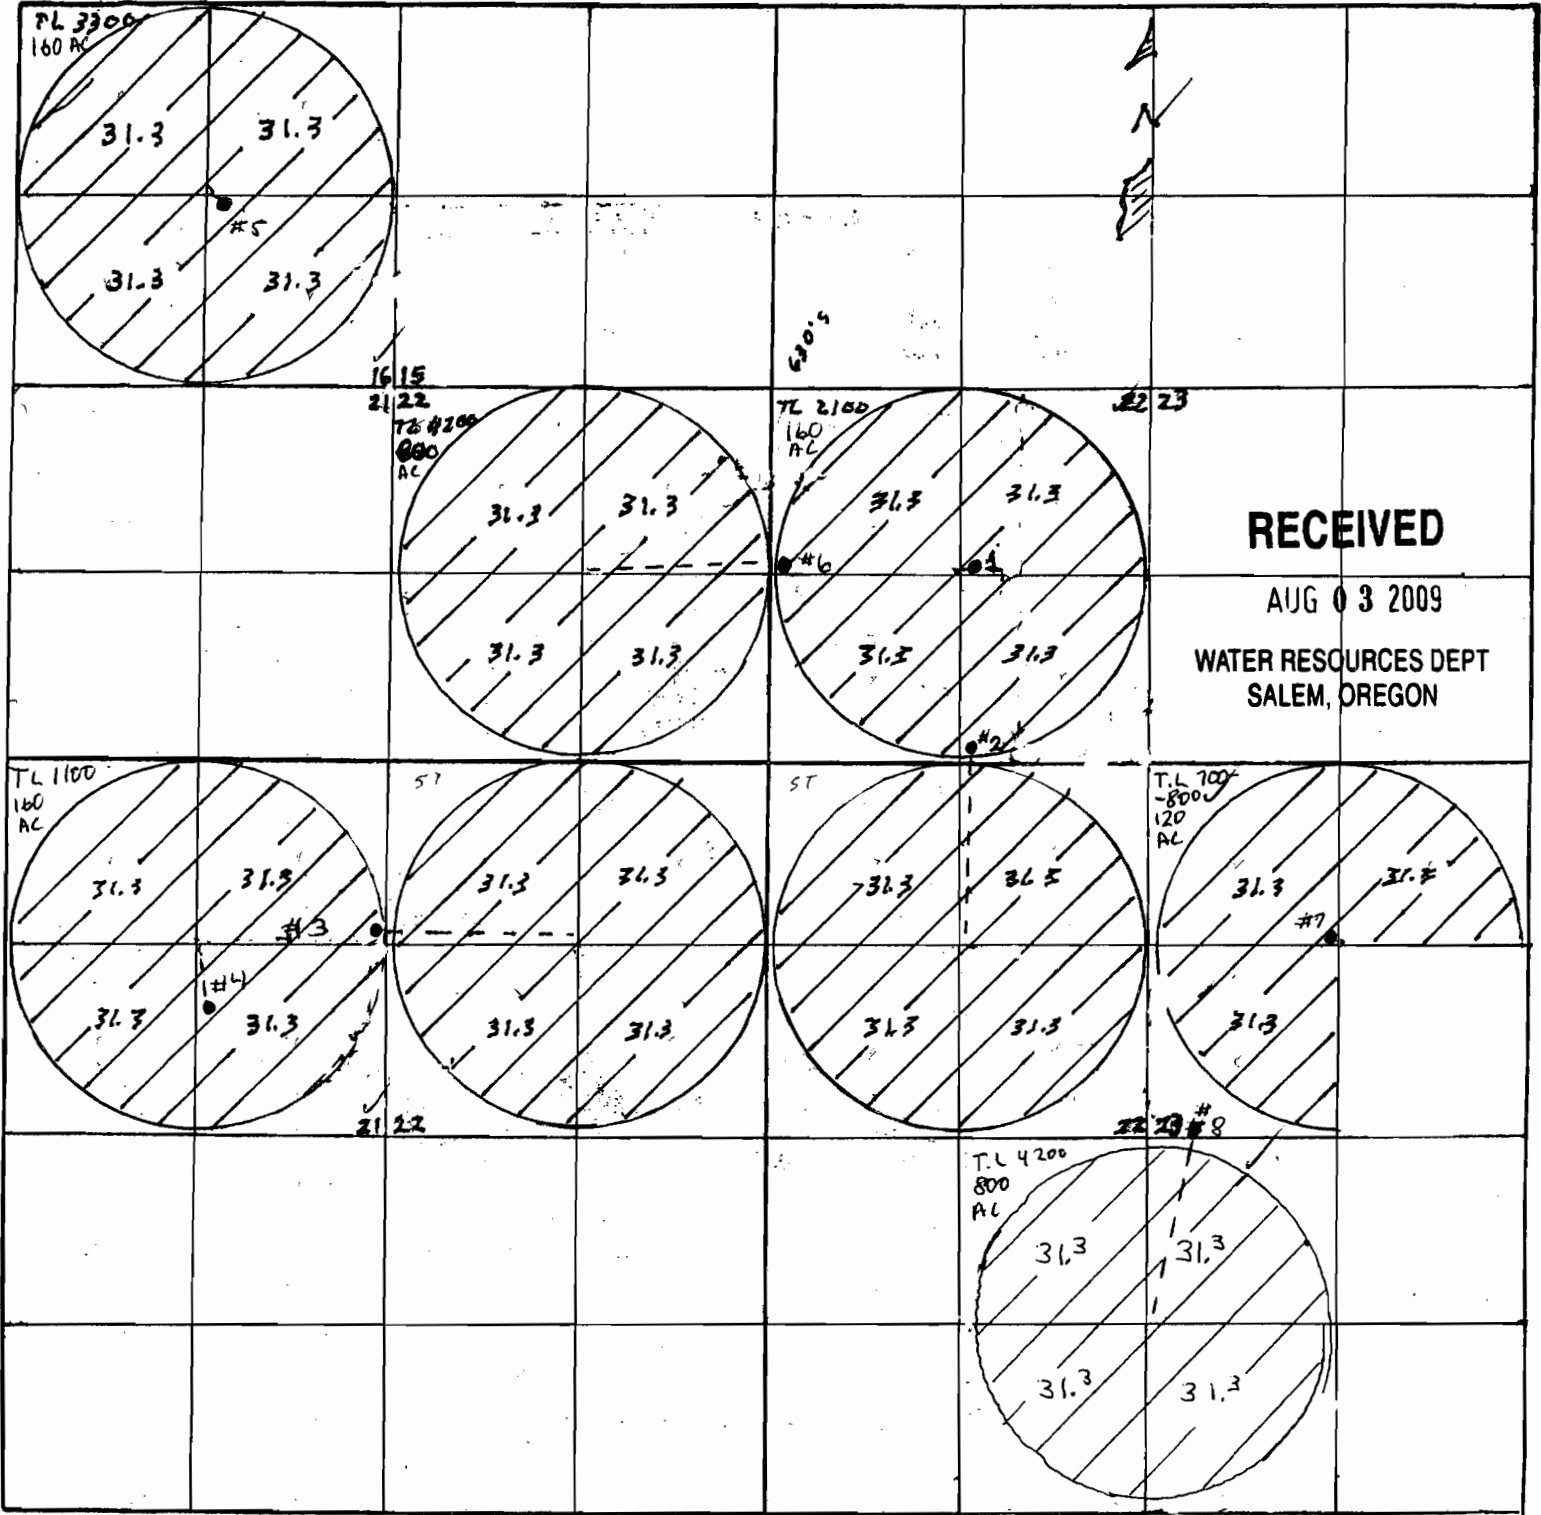

RECEIVED

AUG 03 2009


WATER RESOURCES DEPT
SALEM, OREGON

Remarks scale 4" = 1 mile - 600' - TL 4200 (640 Acres) Leased State Lands

SECTION PLAT

Section Sec. 16 Township 23 S Range 33 E.
County of HARNEY State of Oregon

NORTH

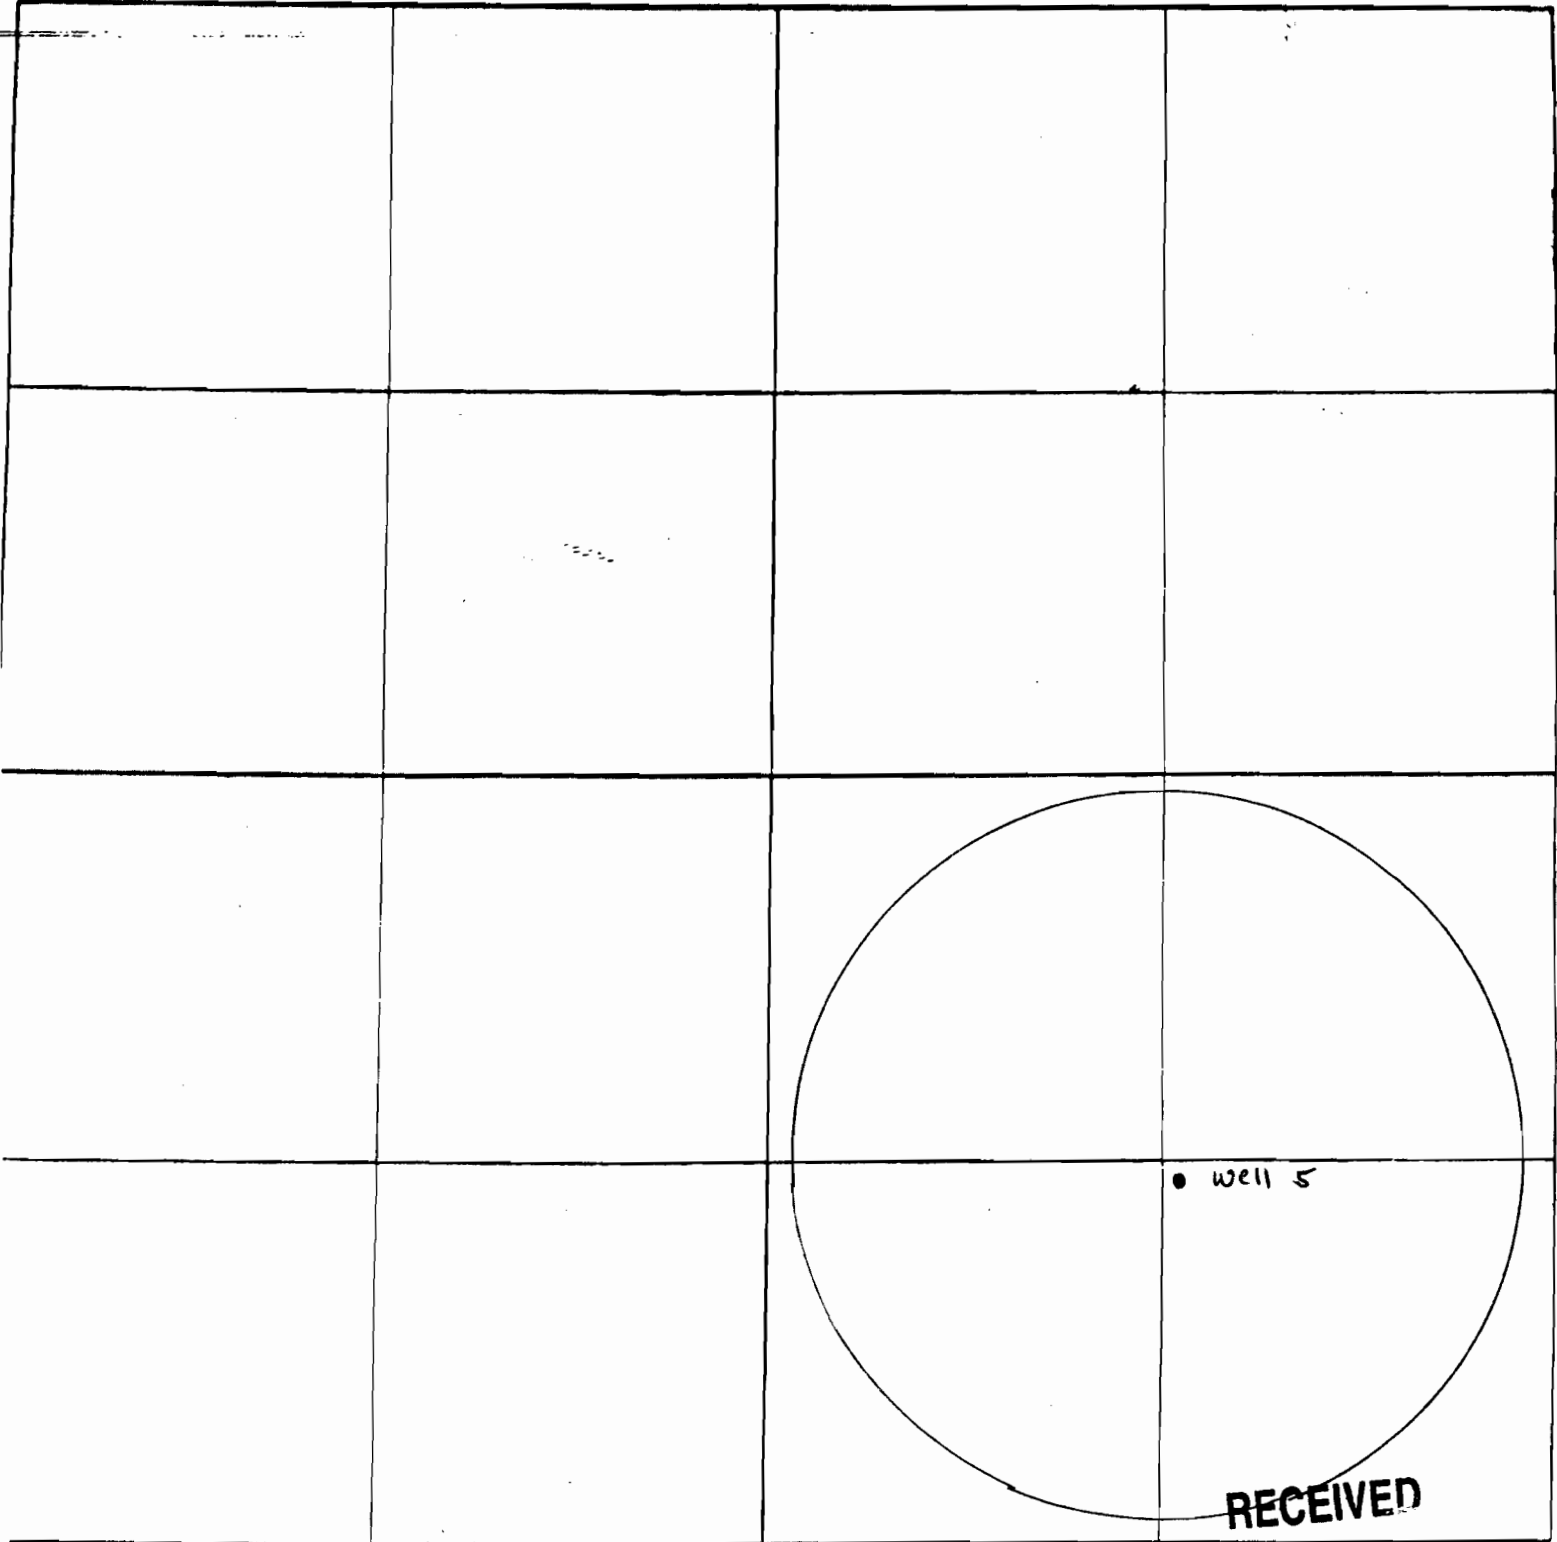

RECEIVED


AUG 03 2009
WATER RESOURCES DEPT
SALEM, OREGON

SECTION PLAT

Section 21 Township 23 S Range 33 E

County of HARNEY State of Oregon

NORTH

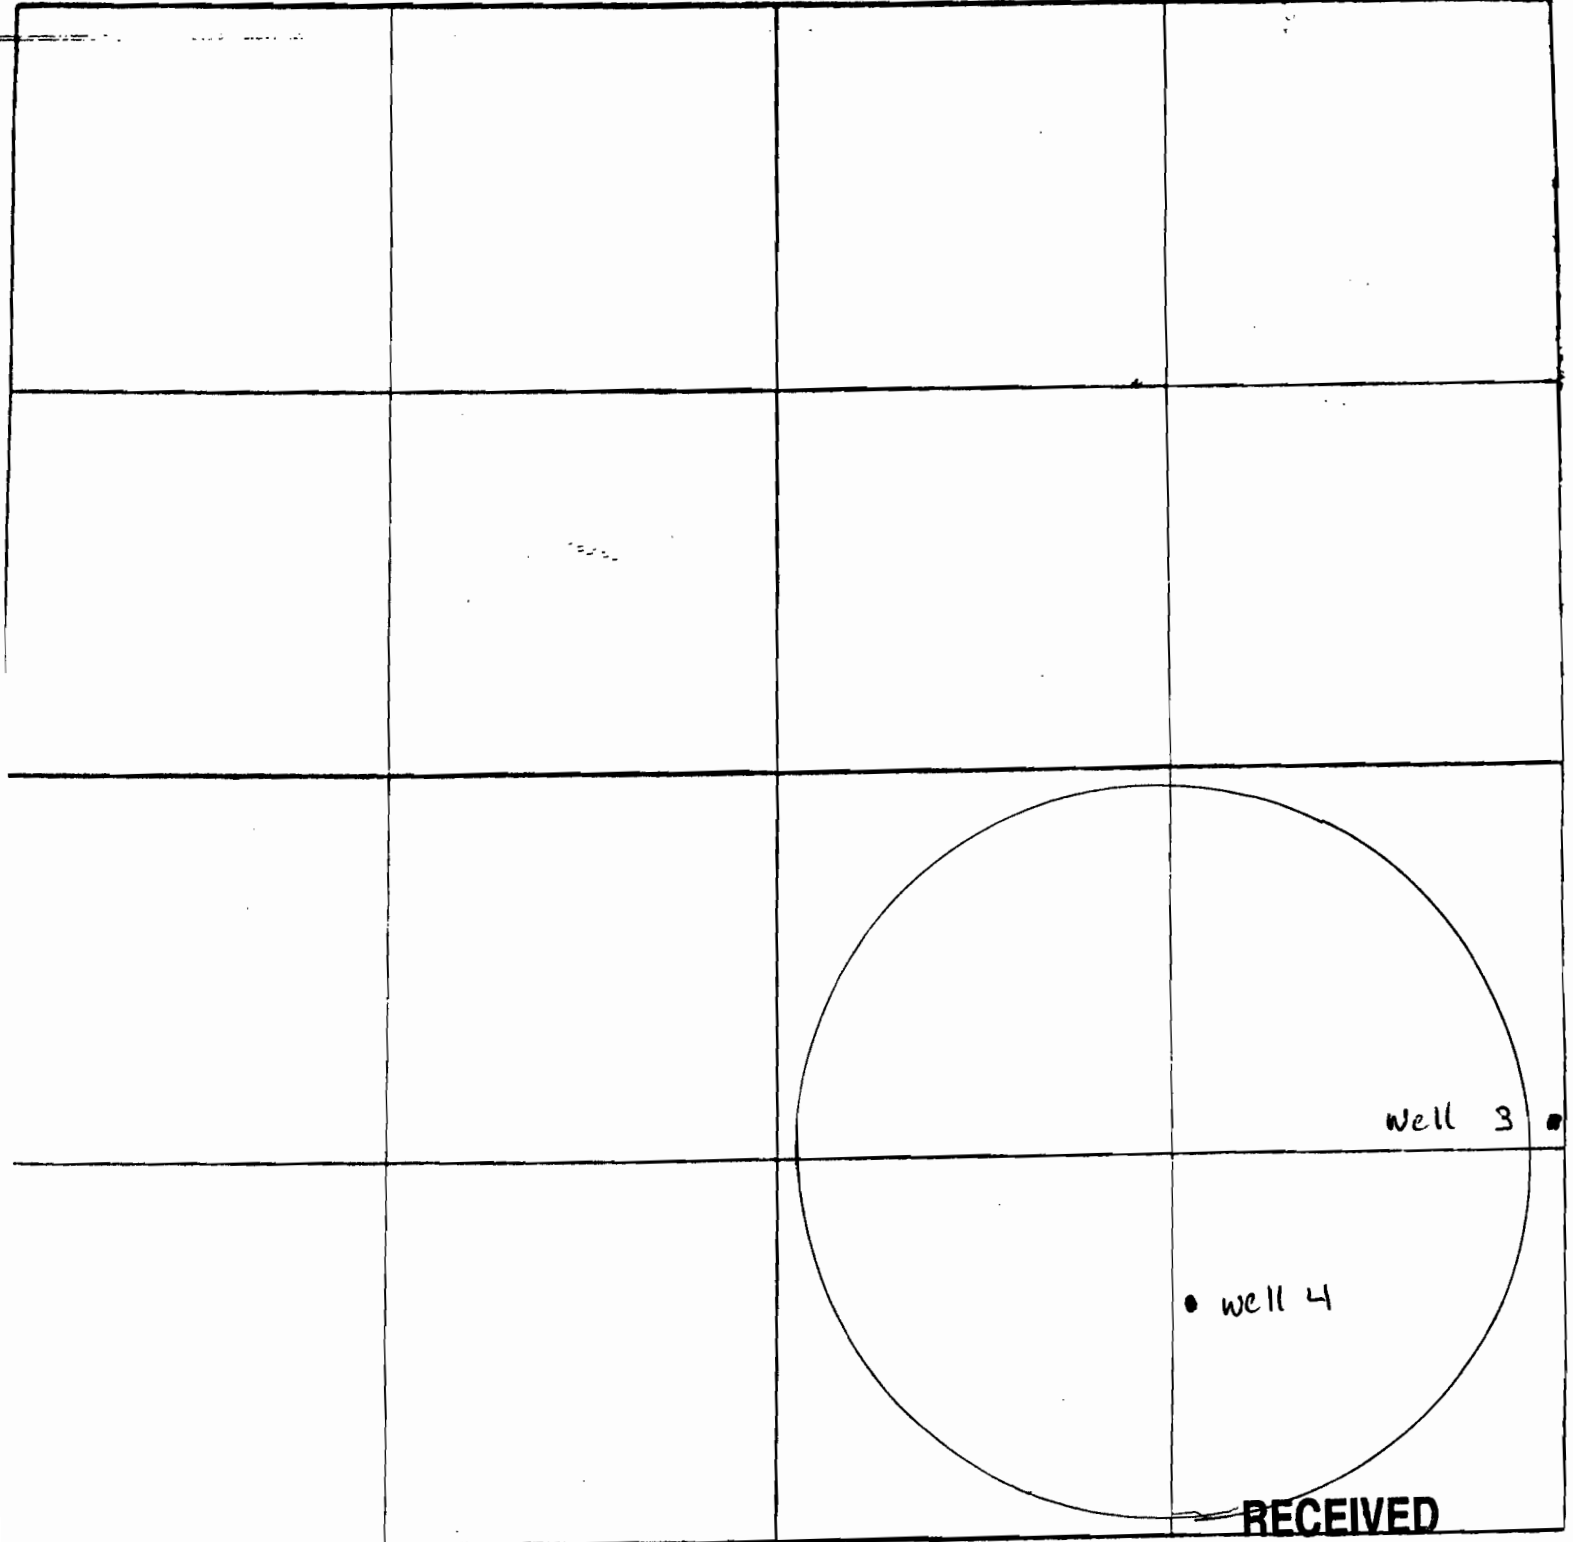

RECEIVED

AUG 03 2009


WATER RESOURCES DEPT
SALEM, OREGON

SECTION PLAT

Section 22 Township 23 S. Range 33 E.

County of HARNEY State of Oregon

NORTH

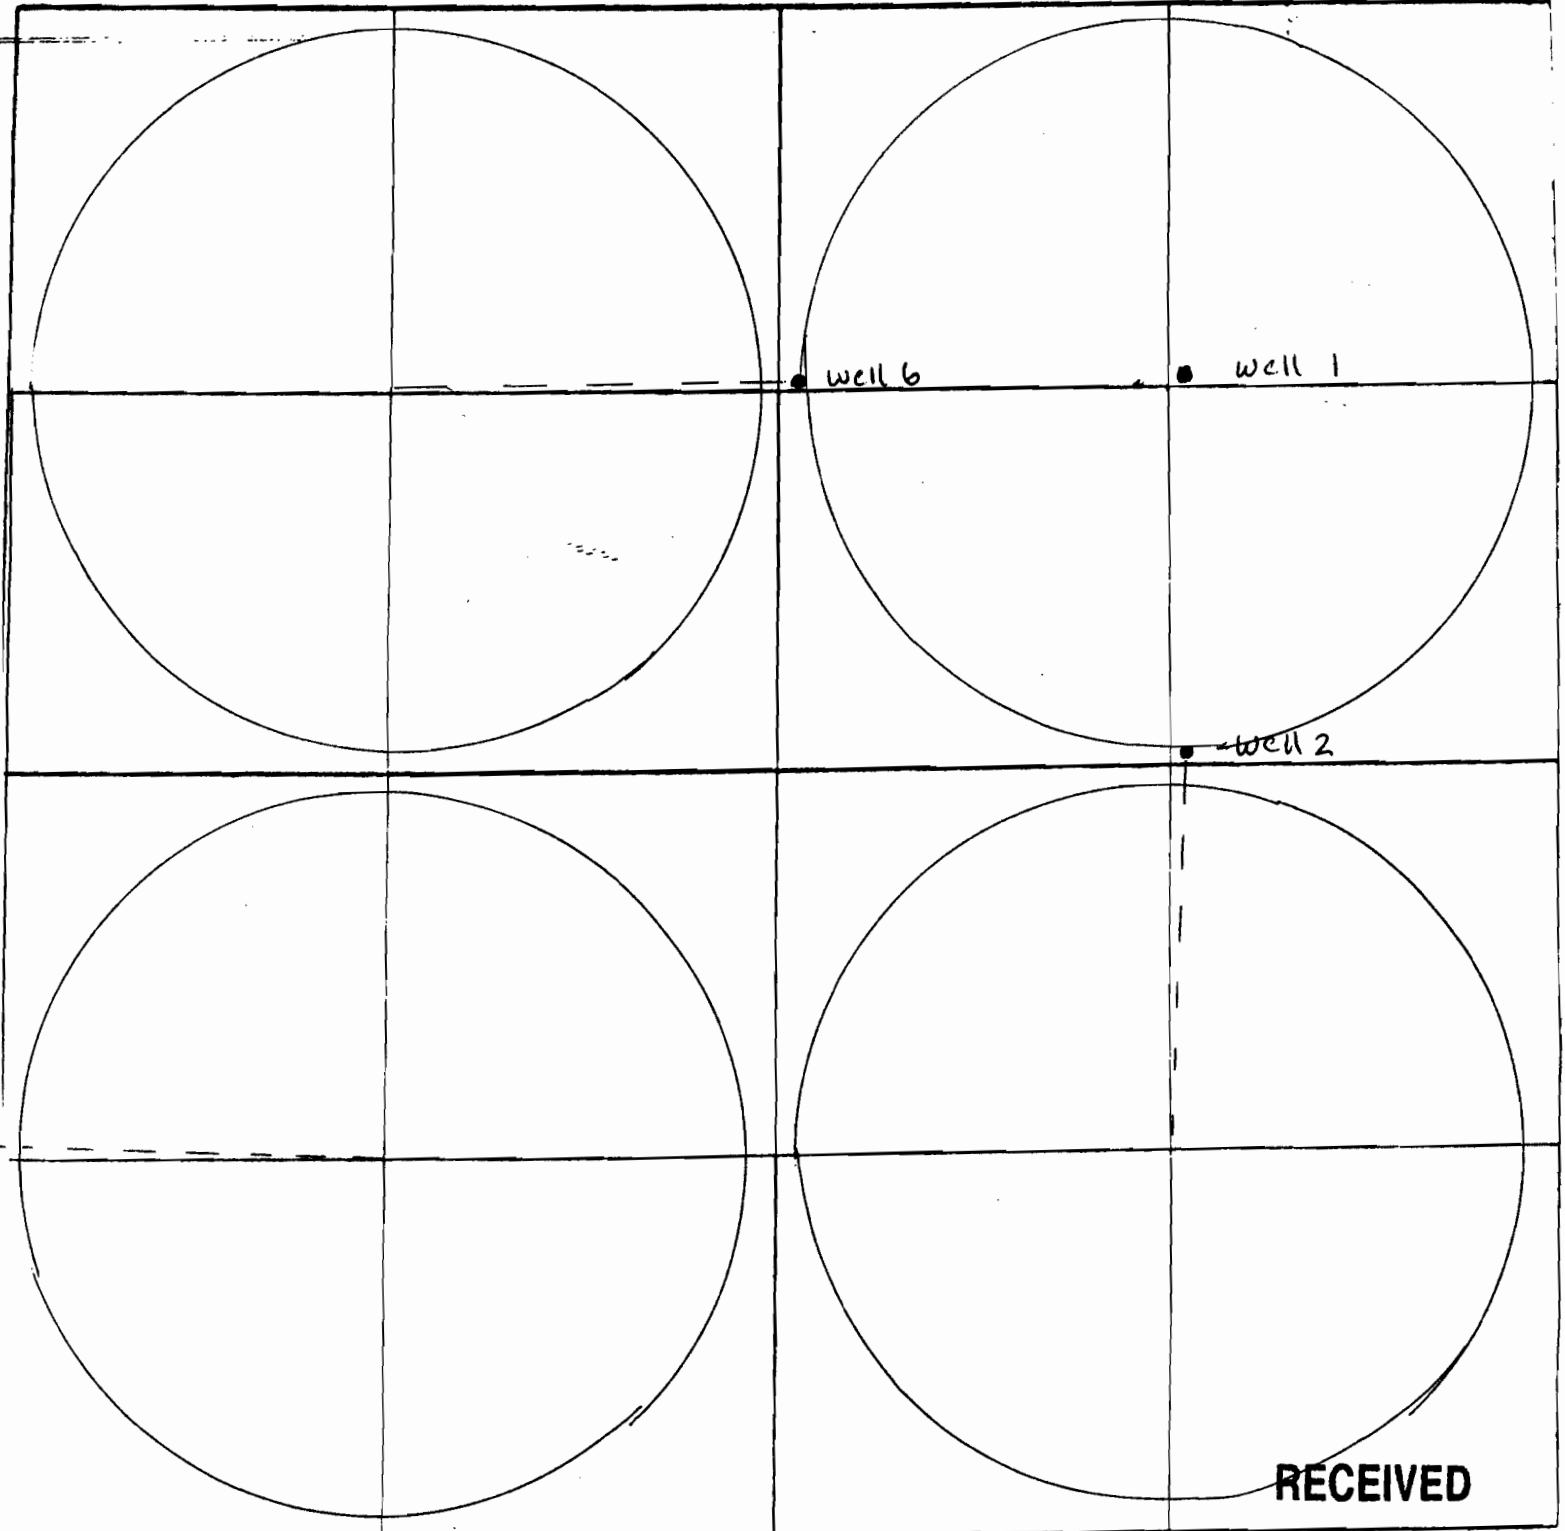

RECEIVED

AUG 03 2009


WATER RESOURCES DEPT
SALEM, OREGON

SECTION PLAT

Section 23 Township 23 S Range 33 E

County of HARNEY State of Oregon

NORTH

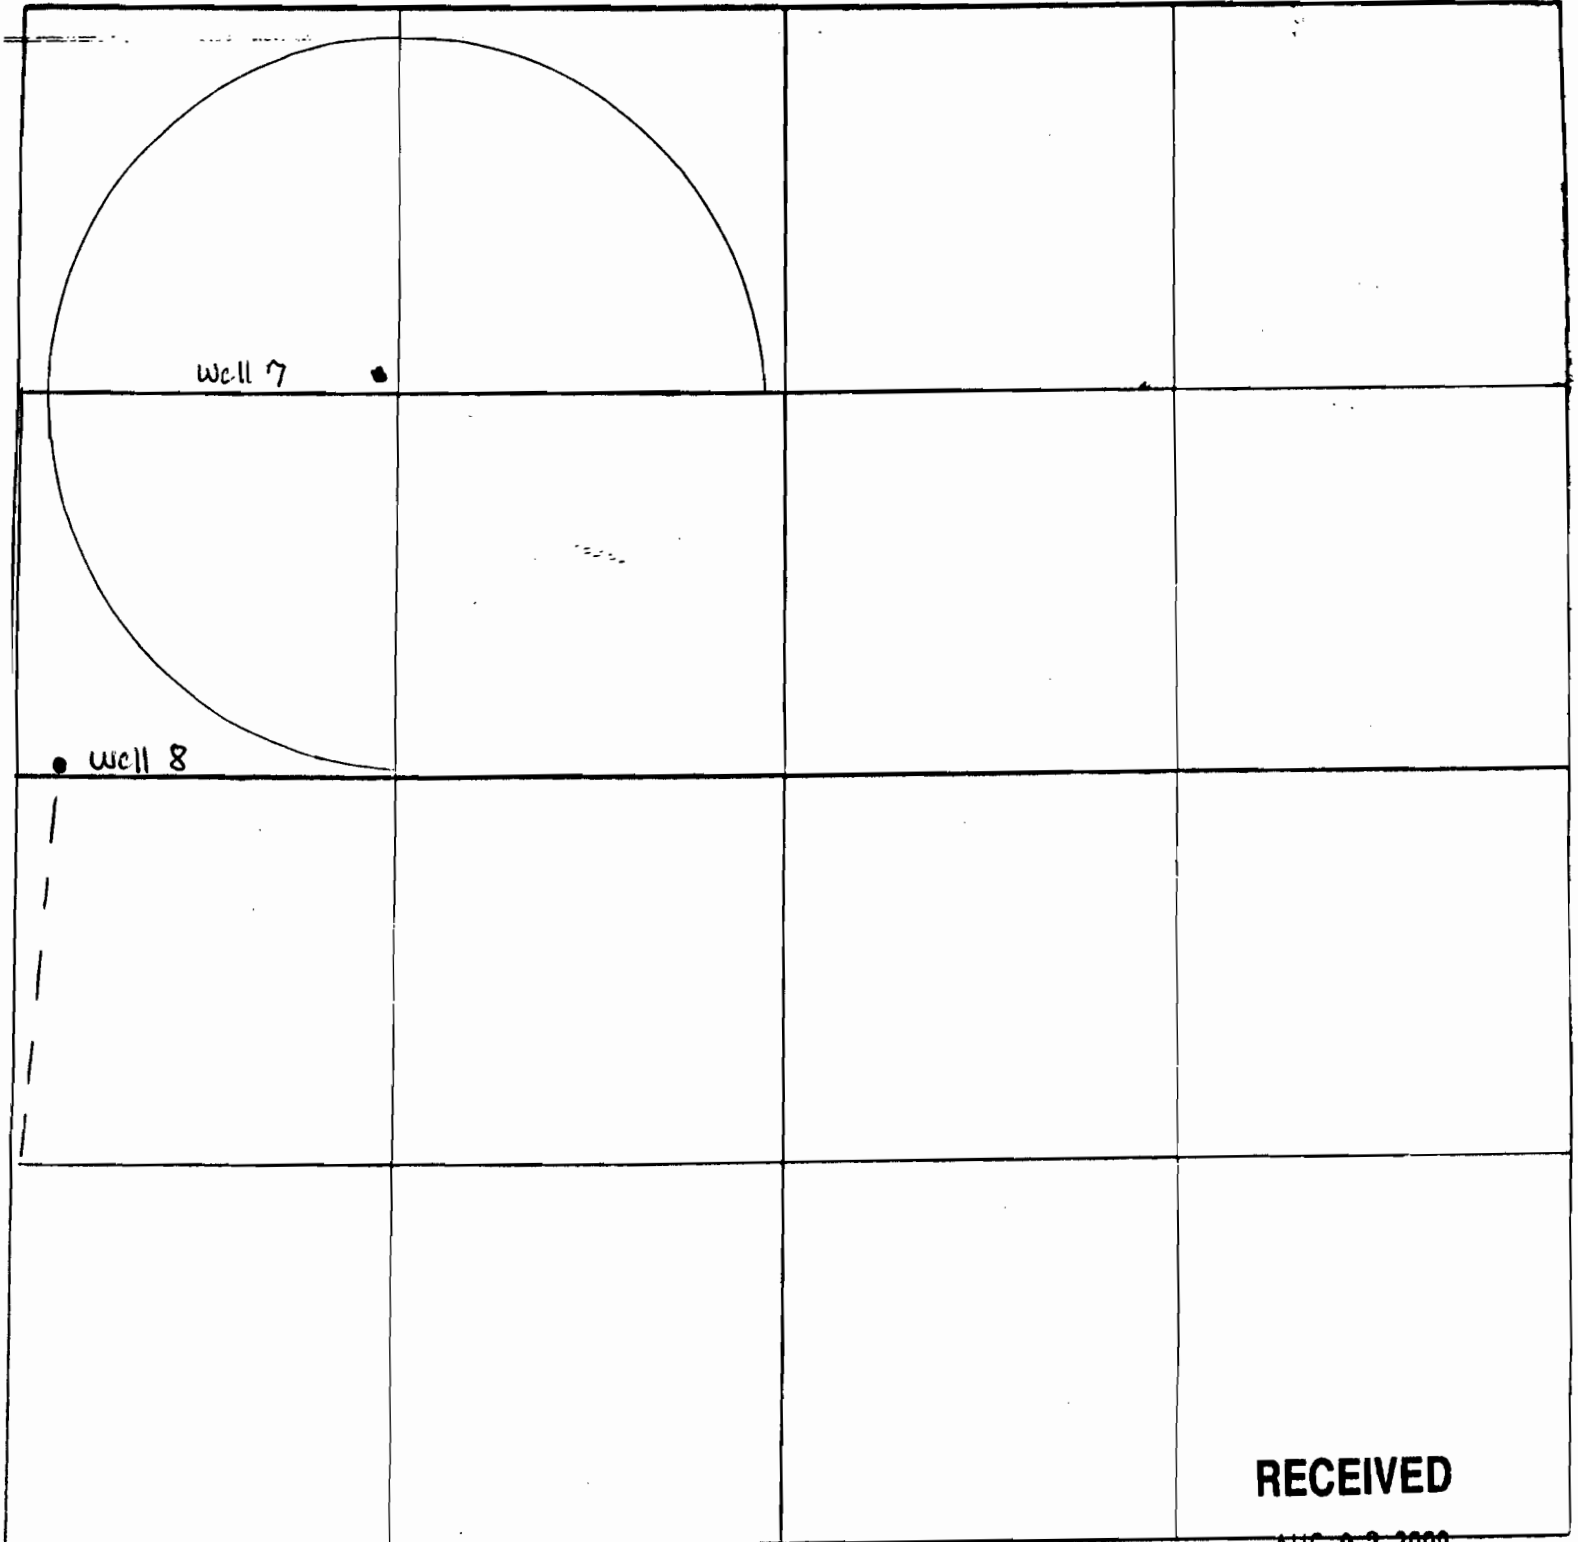

RECEIVED

AUG 03 2009


WATER RESOURCES DEPT
SALEM, OREGON

SECTION PLAT

Section ~~26~~ 26 Township 23 S Range 33 E.

County of HARNEY State of Oregon

NORTH

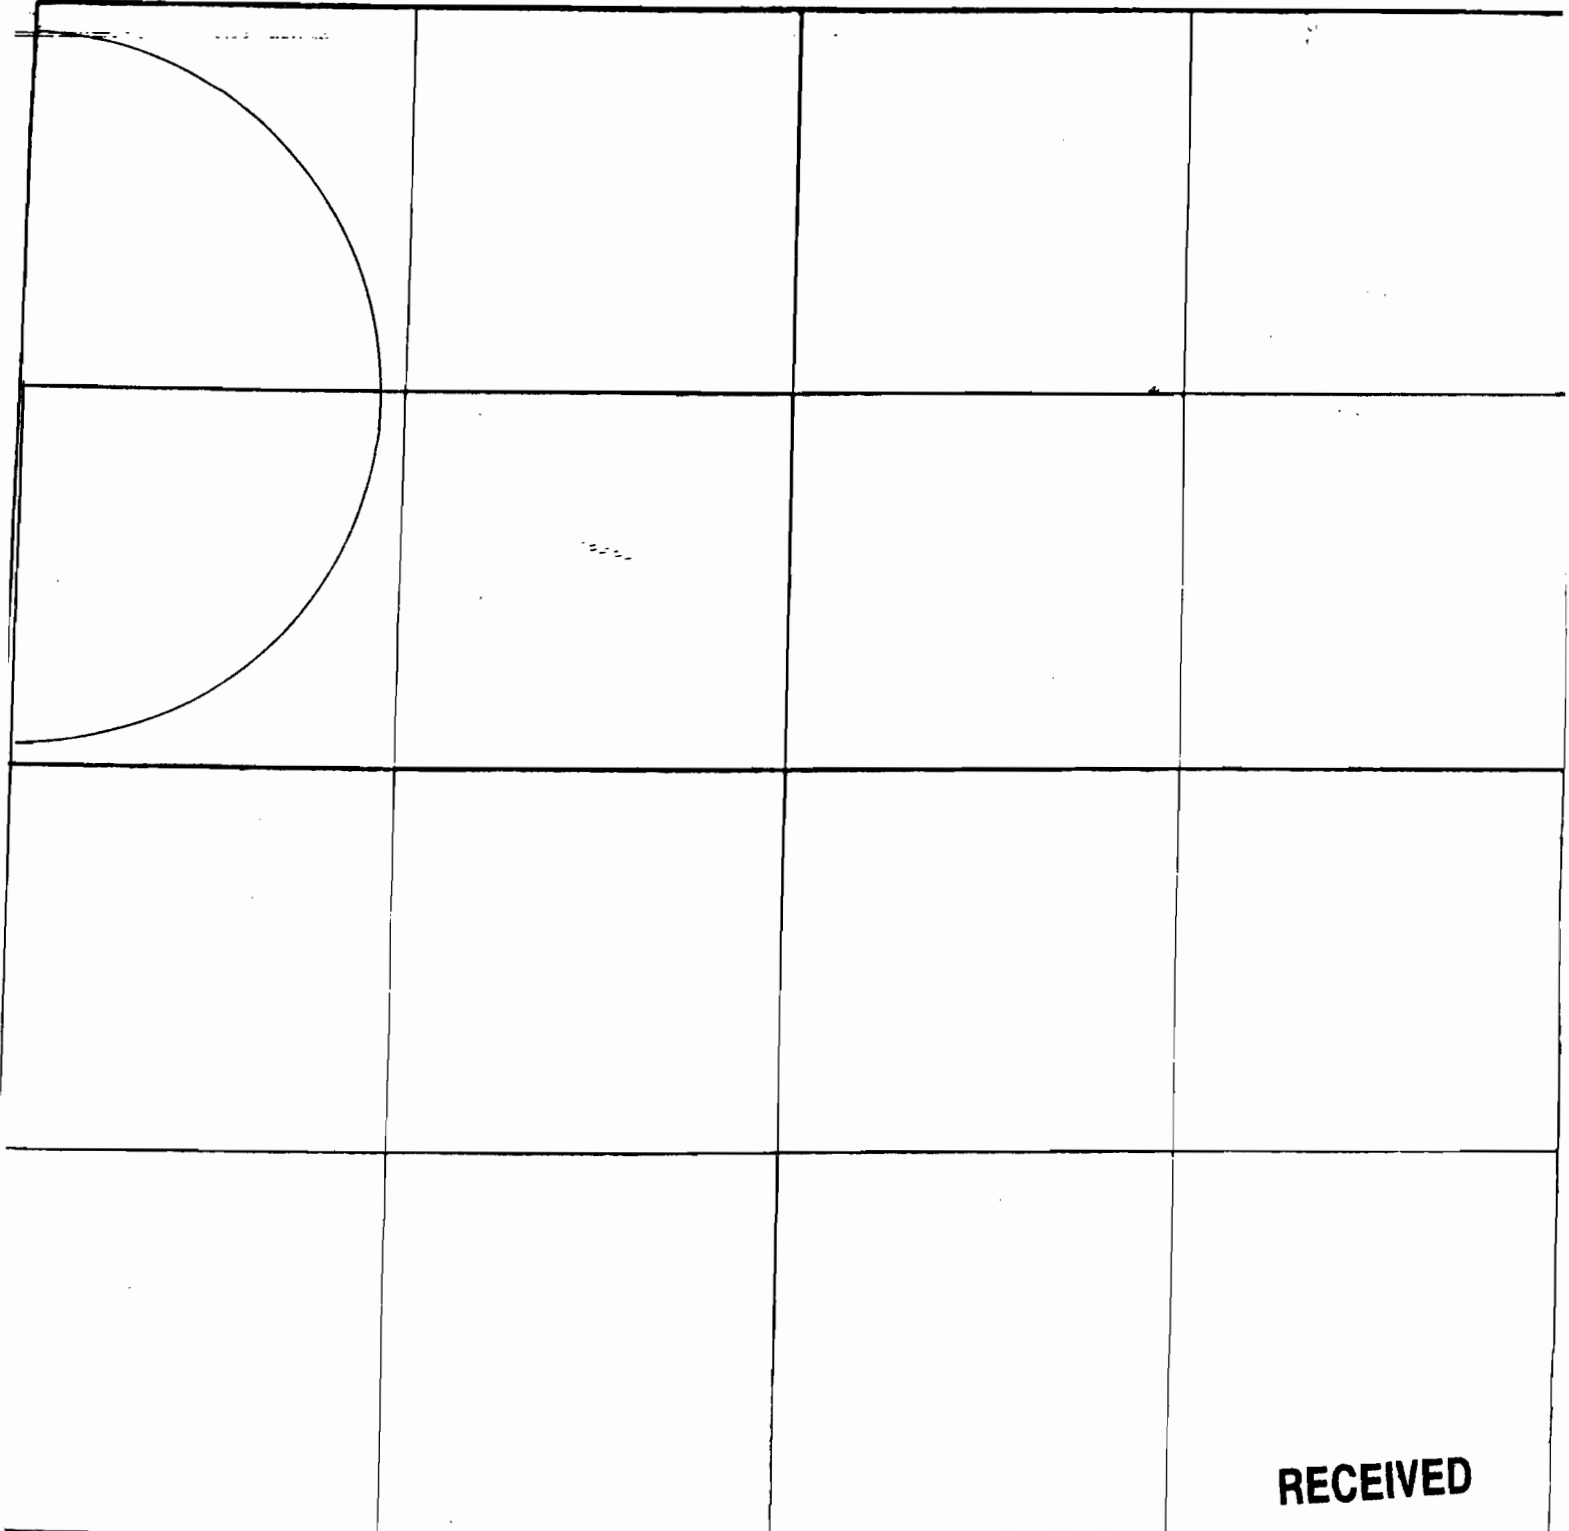

RECEIVED

AUG 03 2009


WATER RESOURCES DEPT
SALEM, OREGON

SECTION PLAT

Section 27 Township 23 S Range 33 E.

County of HARNEY State of Oregon

NORTH

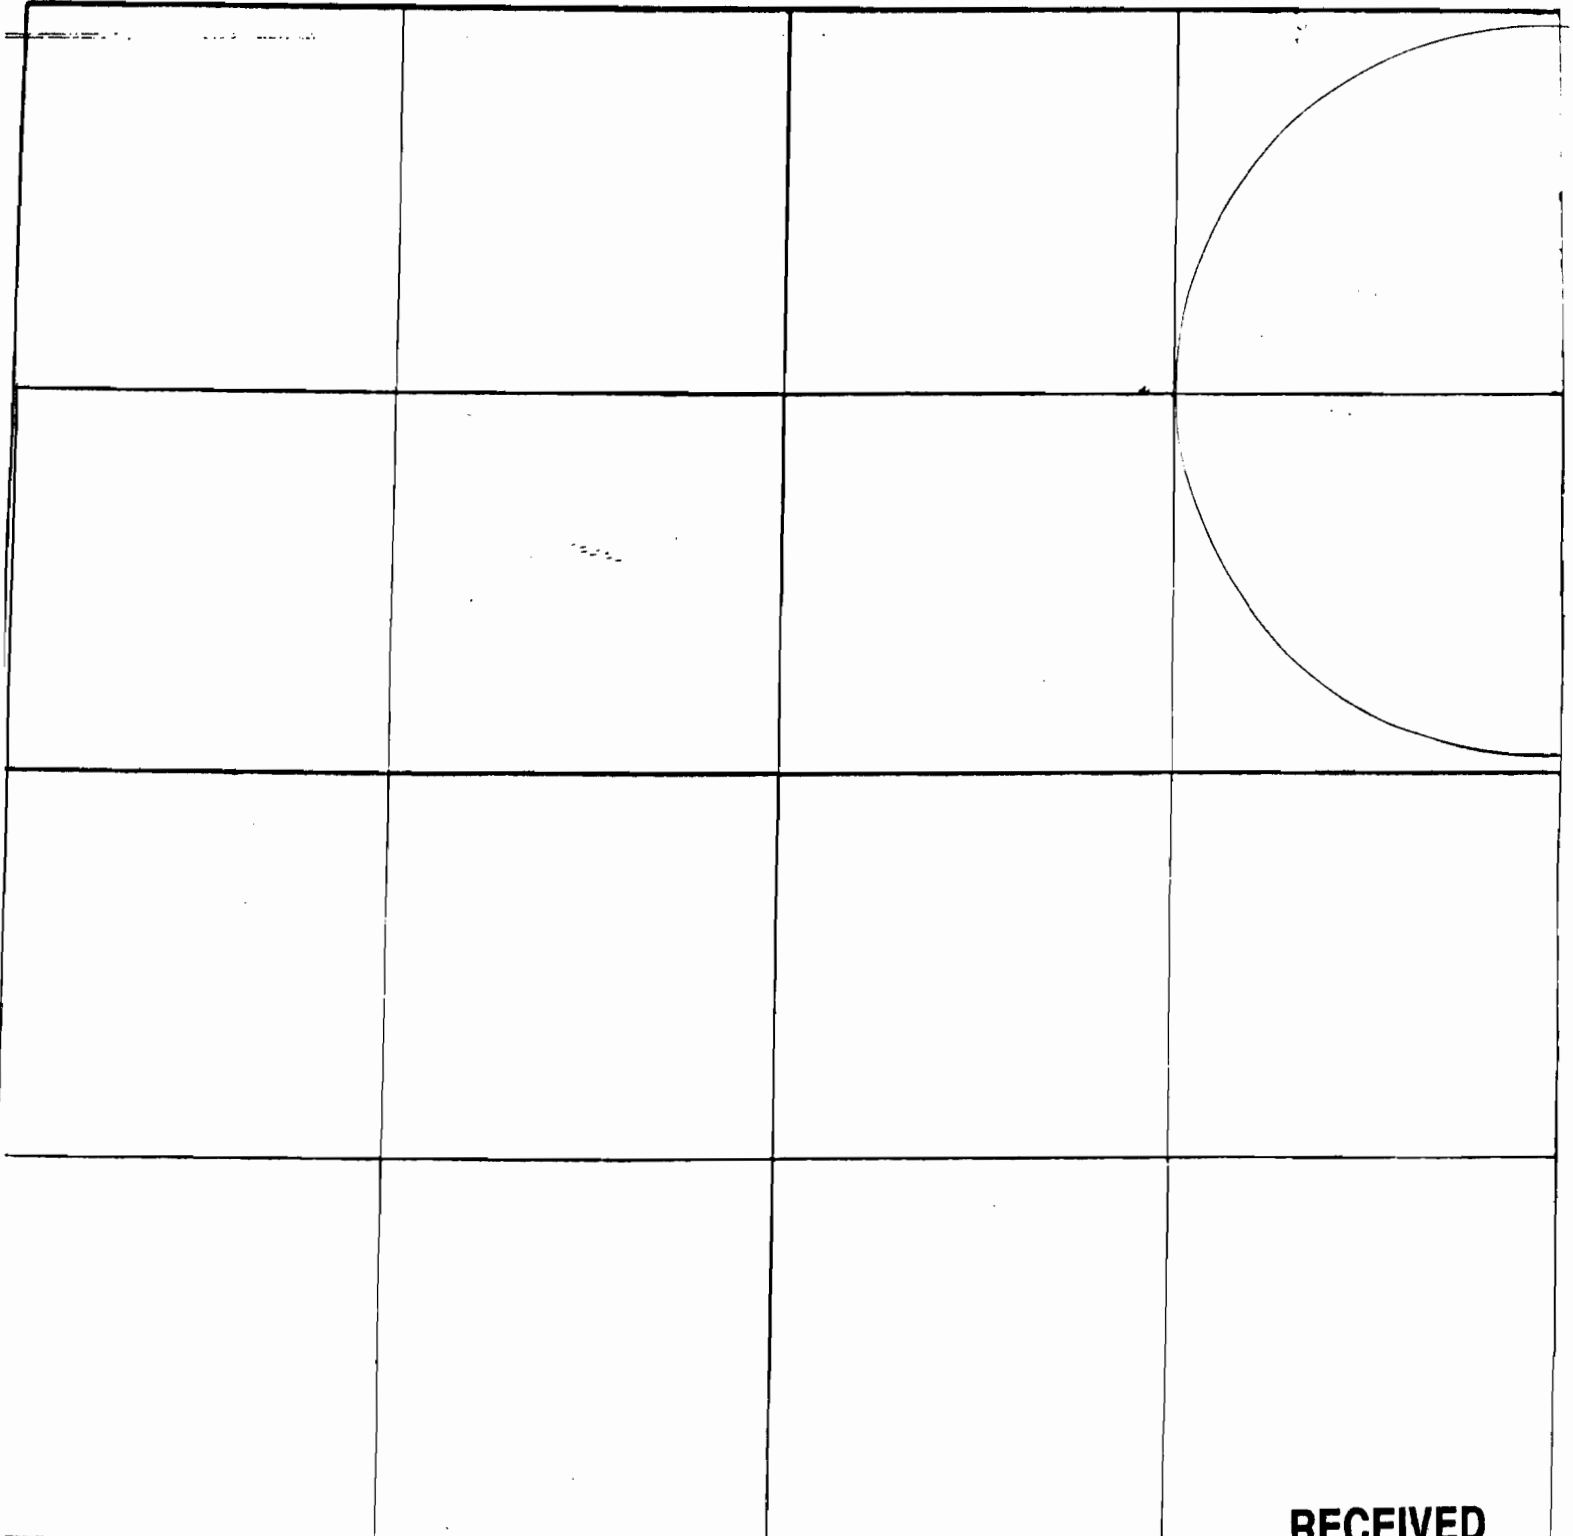

RECEIVED

AUG 03 2009

WATER RESOURCES DEPT
SALEM, OREGON

THIS MAP WAS PREPARED FOR
ASSESSMENT PURPOSE ONLY

SECTION 23 T.23S. R.33E. W.M.
HARNEY COUNTY
1"=400'

23 33 23



WATER RESOURCES DEPT
SALEM, OREGON

RECEIVED
AUG 03 2009

642749

REVISED: GW
10/16/00

23 33 23

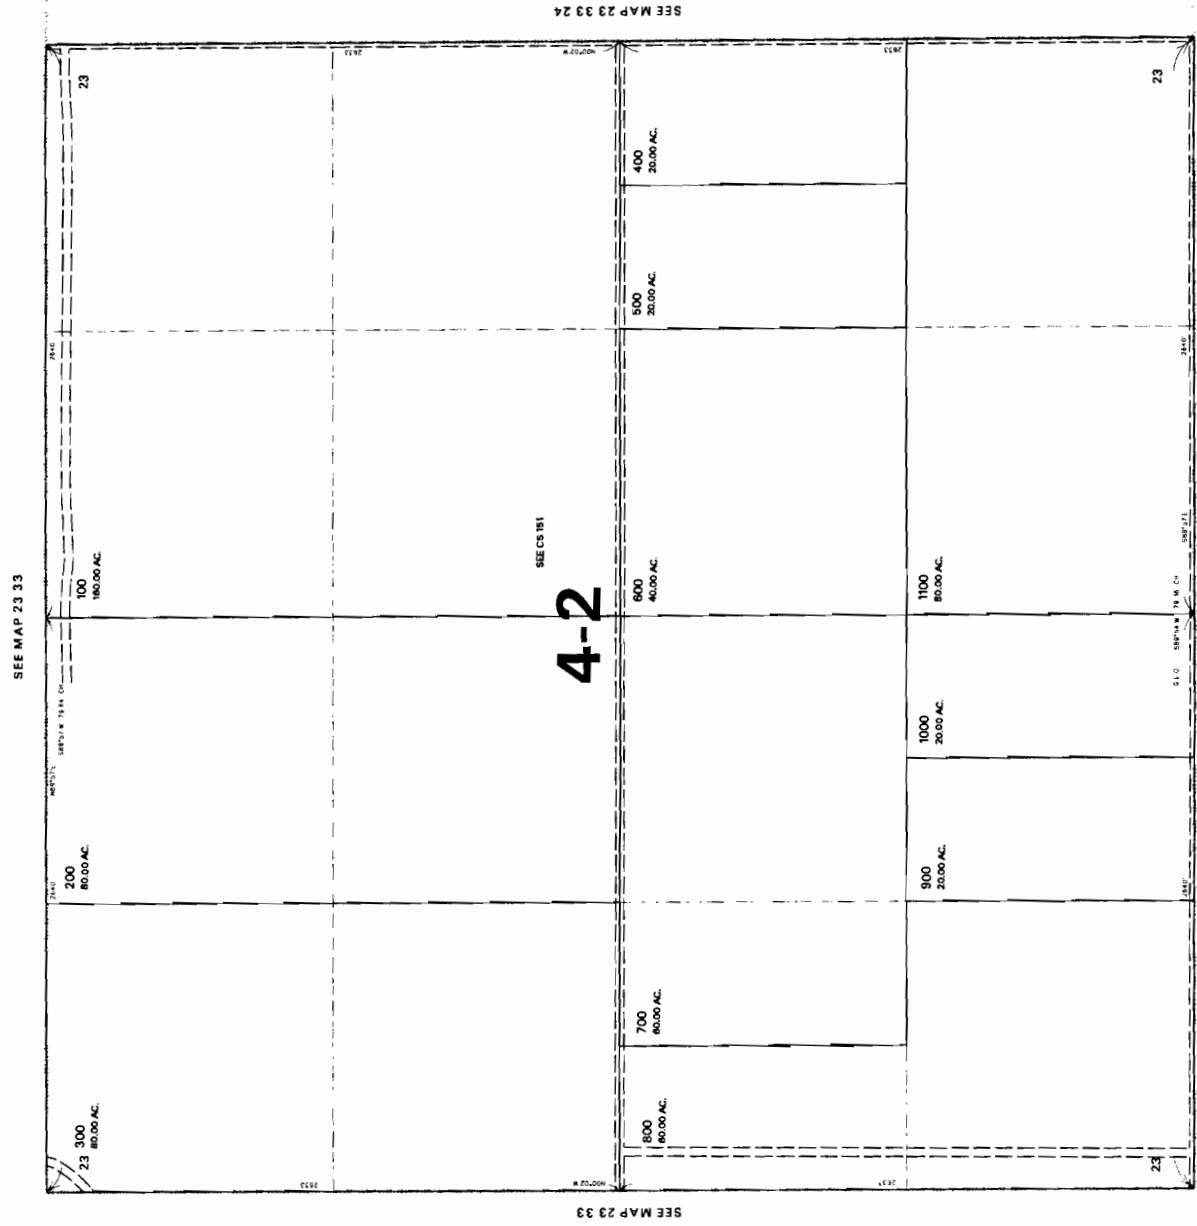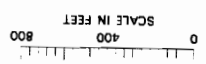

SEE MAP 23 33 24


SEE MAP 23 33 26

T.23S. R.33E. W.M.
HARNEY COUNTY

1" = 2000'

SCALE IN FEET
0 2,000 4,000

THIS MAP WAS PREPARED FOR
ASSESSMENT PURPOSE ONLY

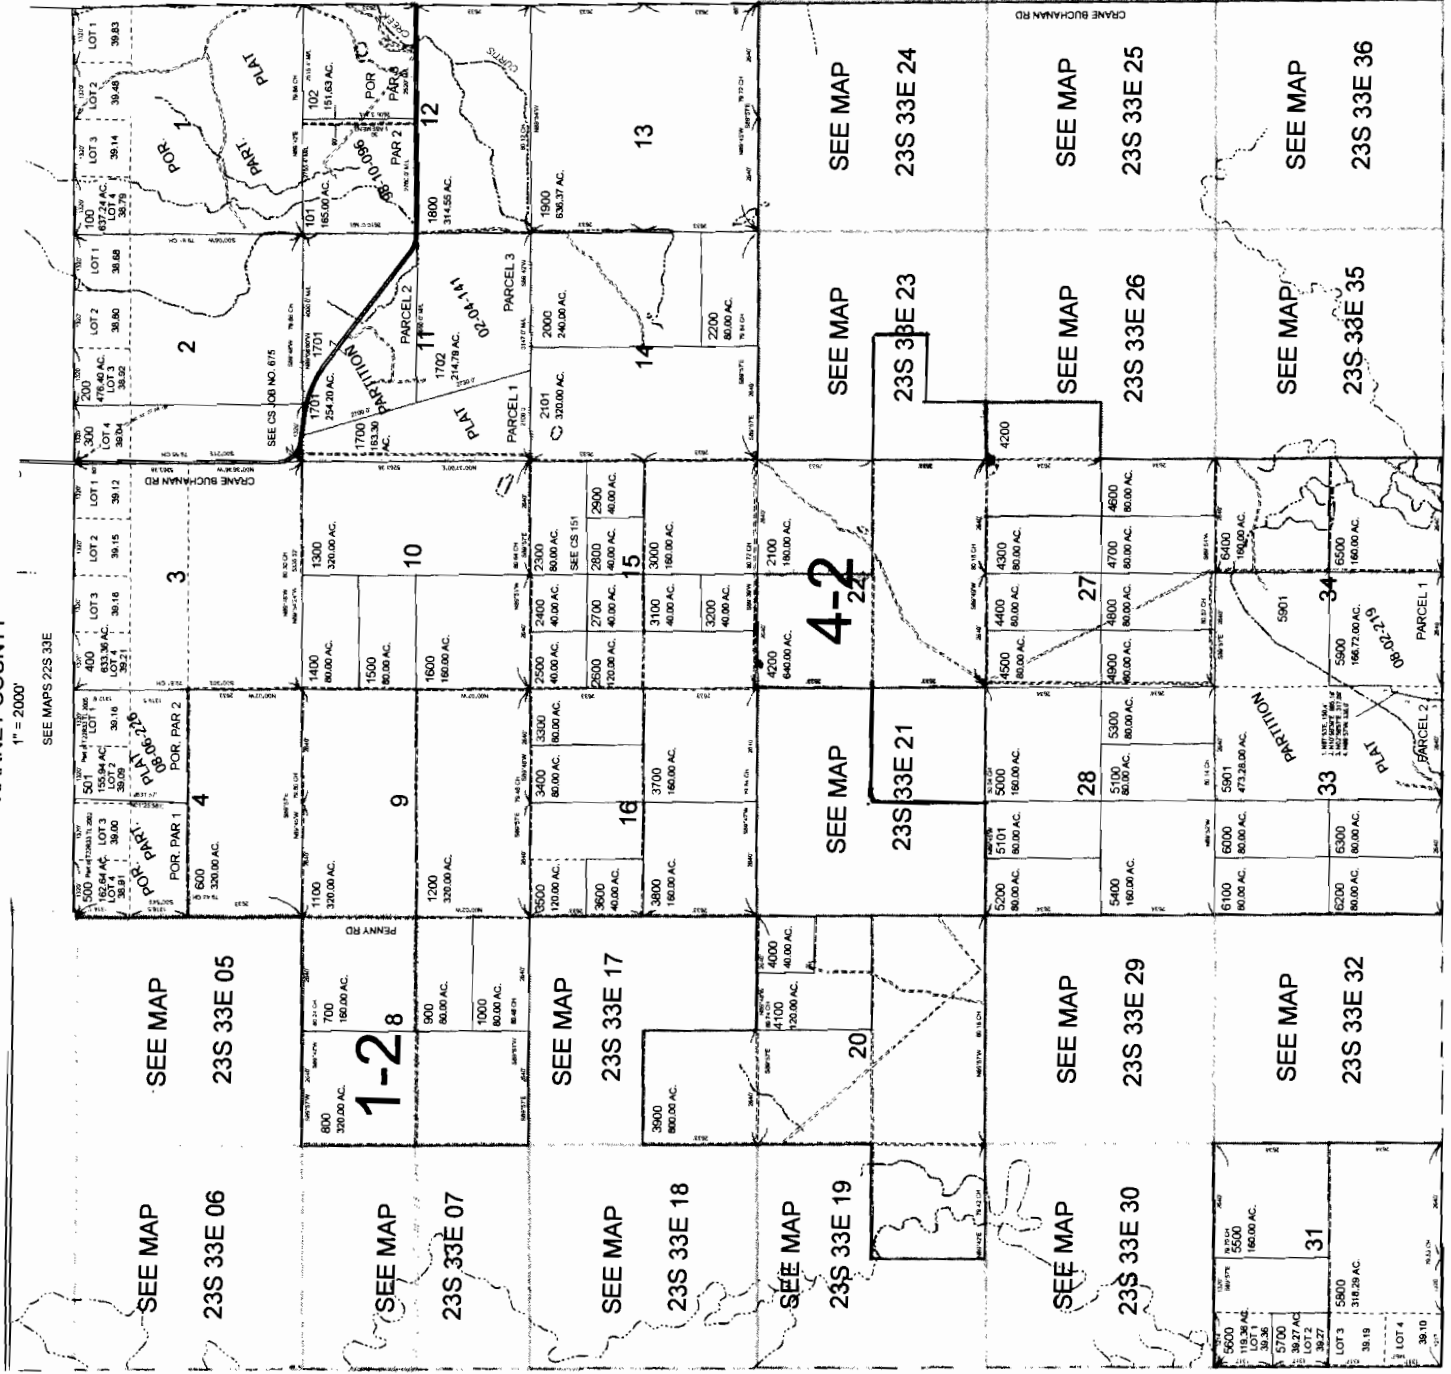

RECEIVED

AUG 03 2009

WATER RESOURCES DEPT
SALEM, OREGON

512249

23S 33E
& INDEX


CANCELLED NO.
401
600M1
600M2
700M1
700M2

Decided
LAMES


State Law

PRINTED ON
Jul 07, 2008
23S 33E
& INDEX

THIS MAP WAS PREPARED FOR ASSESSMENT PURPOSE ONLY

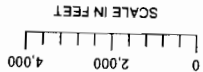

T.23S. R.33E. W.M. HARNEY COUNTY

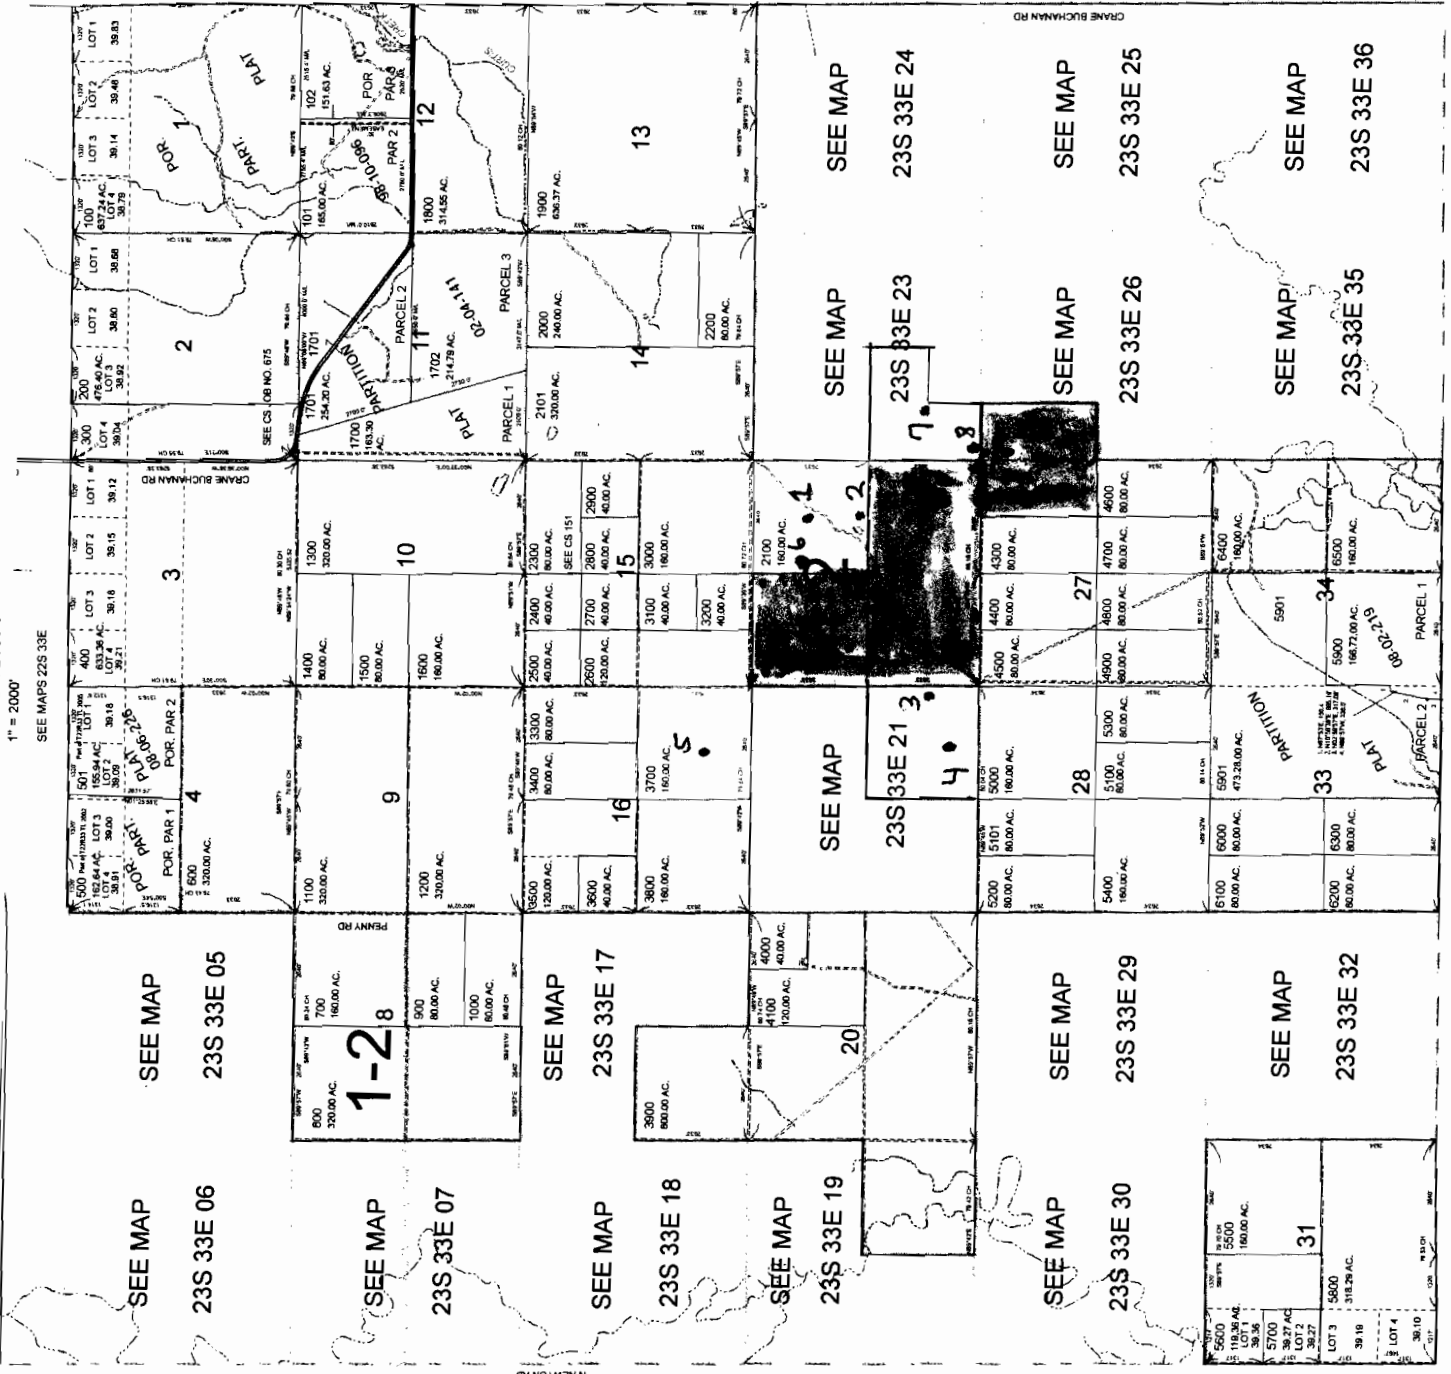

SEE MAPS 23S 32VE

SEE MAPS 23S 34E

SEE MAPS 24S 33E

23S 33E
& INDEX

- CANCELLED NO.
- 401
- 600M1
- 600M2
- 700M1
- 700M2
WATER RESOURCES DEPT
SALEM, OREGON

RECEIVED
AUG 03 2009

STATE LEASE
LAND

Wells 1-8

PRIVATE
LAND

PRINTED ON
Jul 07, 2008
23S 33E
& INDEX