

Send To Printer


Back To TerraServer

Change to 11x17 Print Size

Show Grid Lines

Change to Landscape

USGS 167 km W of Boise, Idaho, United States 01 Jul 1974

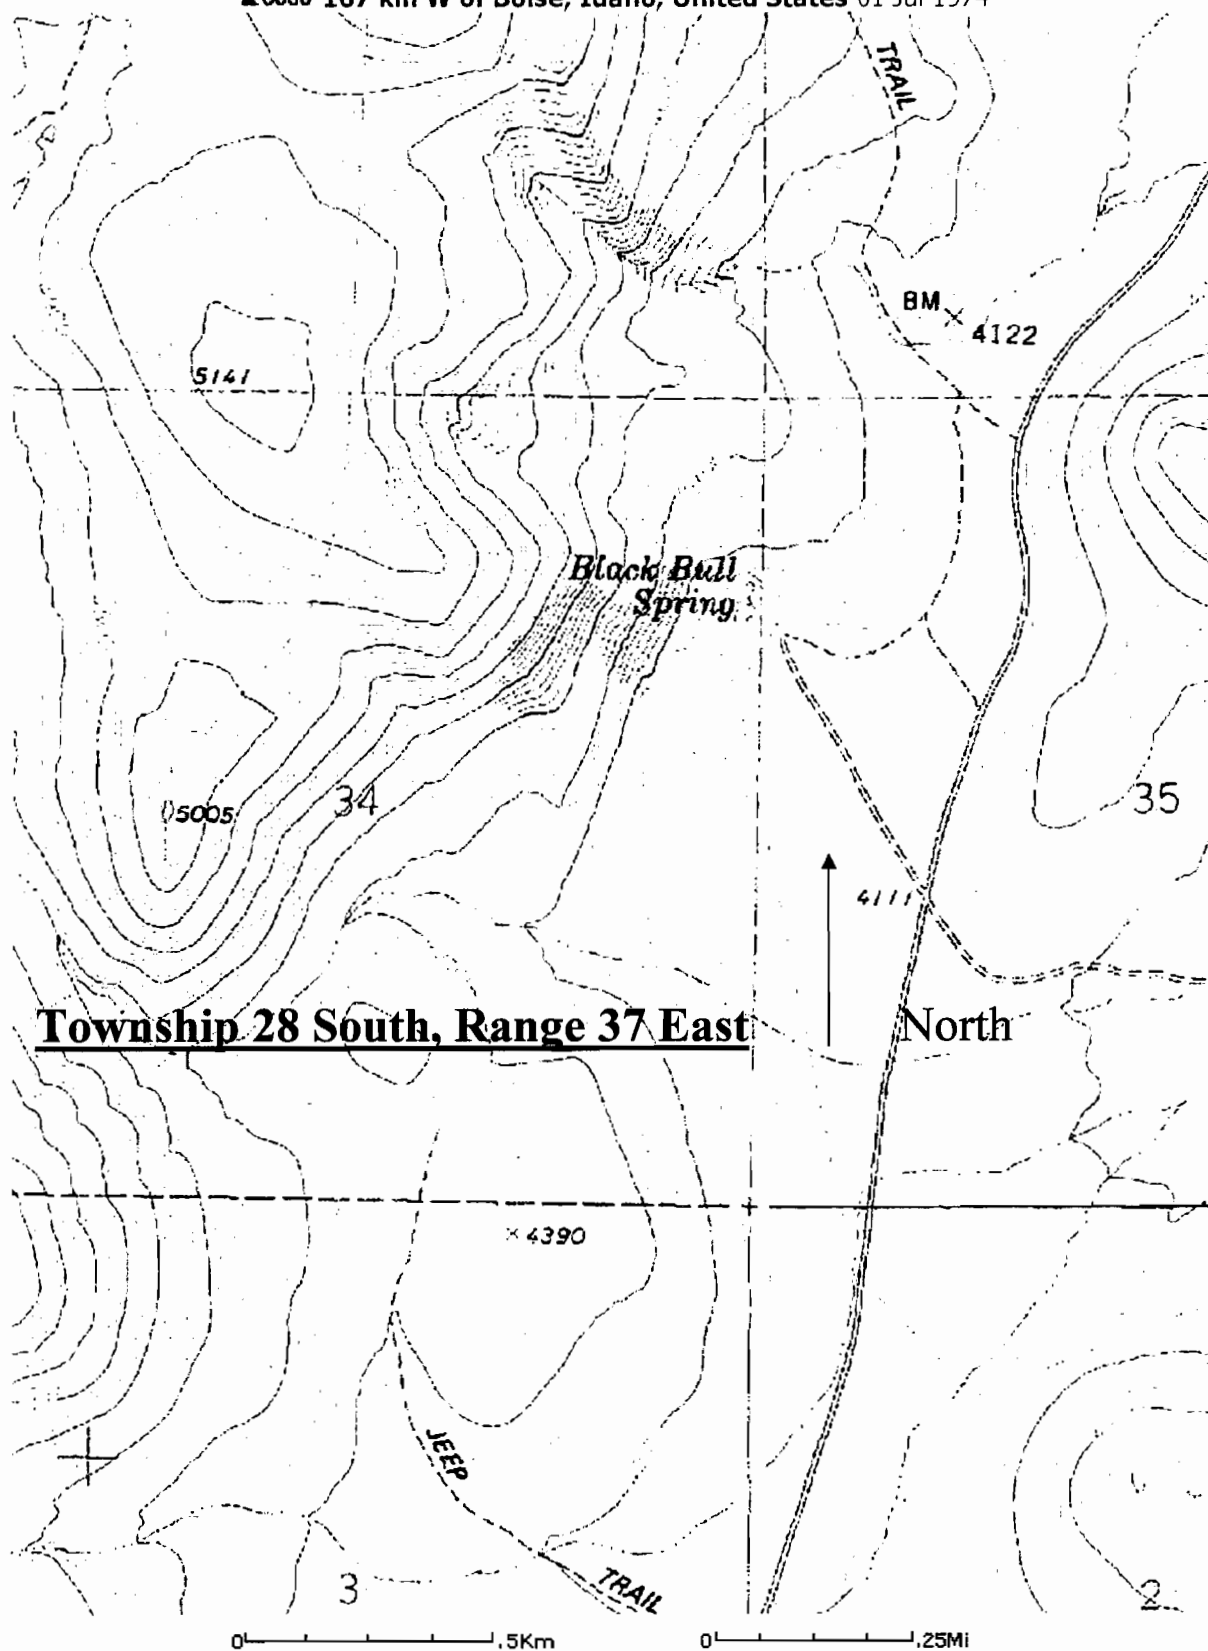**Township 28 South, Range 37 East**

North

Image courtesy of the U.S. Geological Survey
© 2004 Microsoft Corporation. **Terms of Use** **Privacy Statement**

RECEIVED


AUG 03 2009

WATER RESOURCES DEPT
SALEM, OREGON

RECEIVED**AUG 04 2009**WATER RESOURCES DEPT
SALEM, OREGON

Black Bull Spring Ranch
Malheur County, Oregon
Owyhee River Basin
Water Rights Application Map
Malheur County Tax Lot 1900

(Section Corner common to 26/27/34/35)

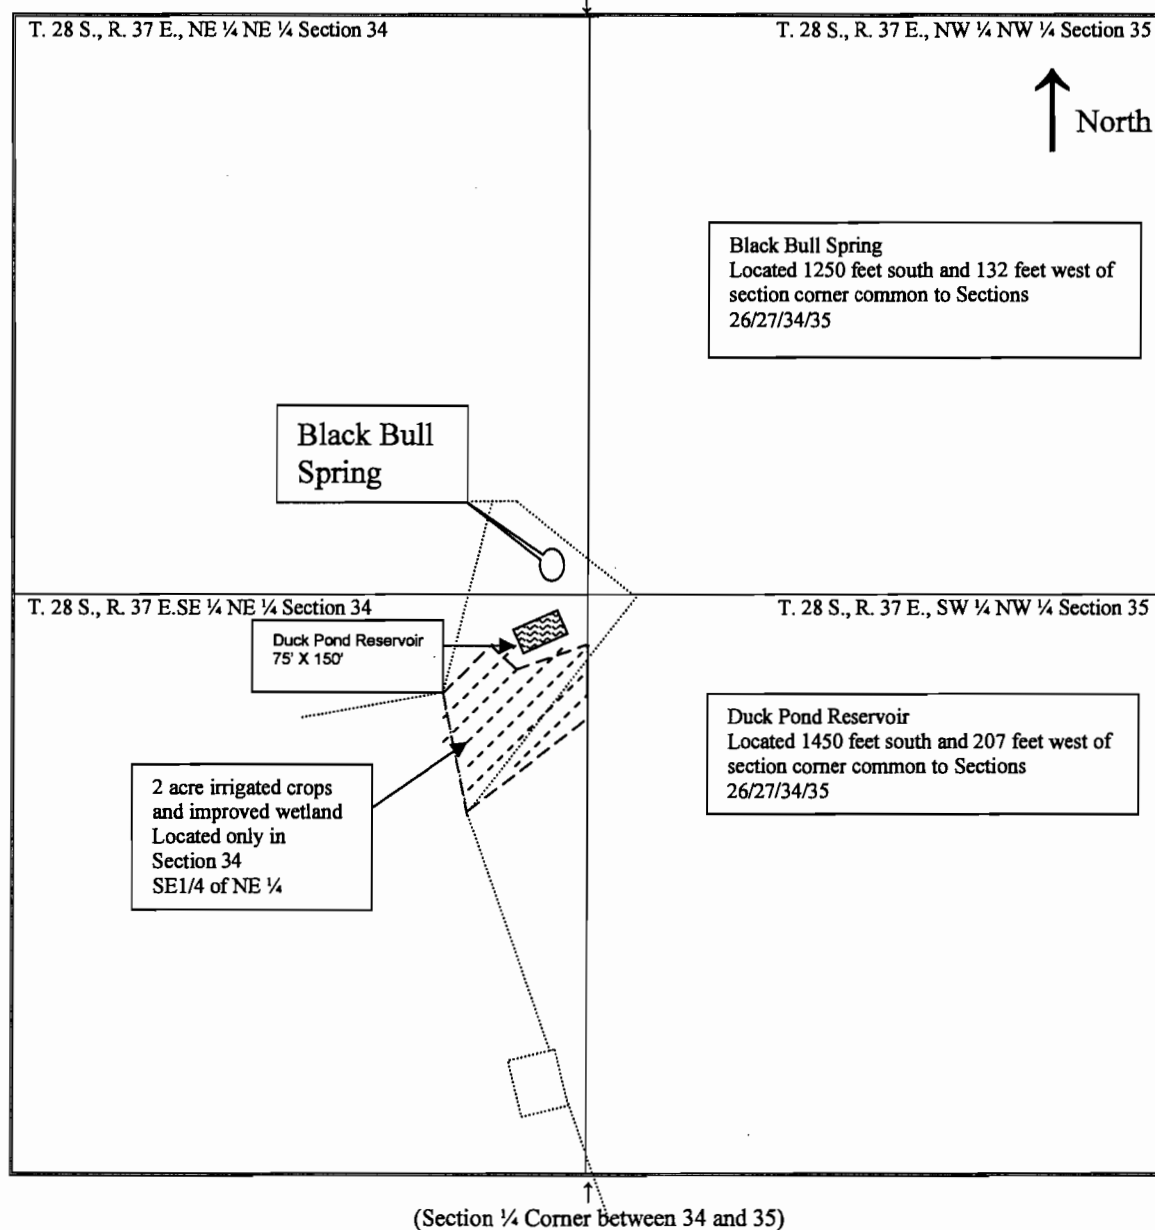

1" = 440 feet 6" = 1/2 mile. Pasture Fencing:


Township 28 South, Range 37 East, Section 34 E 1/2 NE 1/4 and Section 35 W 1/2 NW 1/4.
Malheur County Tax Lot # 1900.

July 11, 2009

R-87503

Black Bull Spring Ranch
Malheur County, Oregon
Owyhee River Basin
Water Rights Application Map
Malheur County Tax Lot 1900

(Section Corner common to 26/27/34/35)

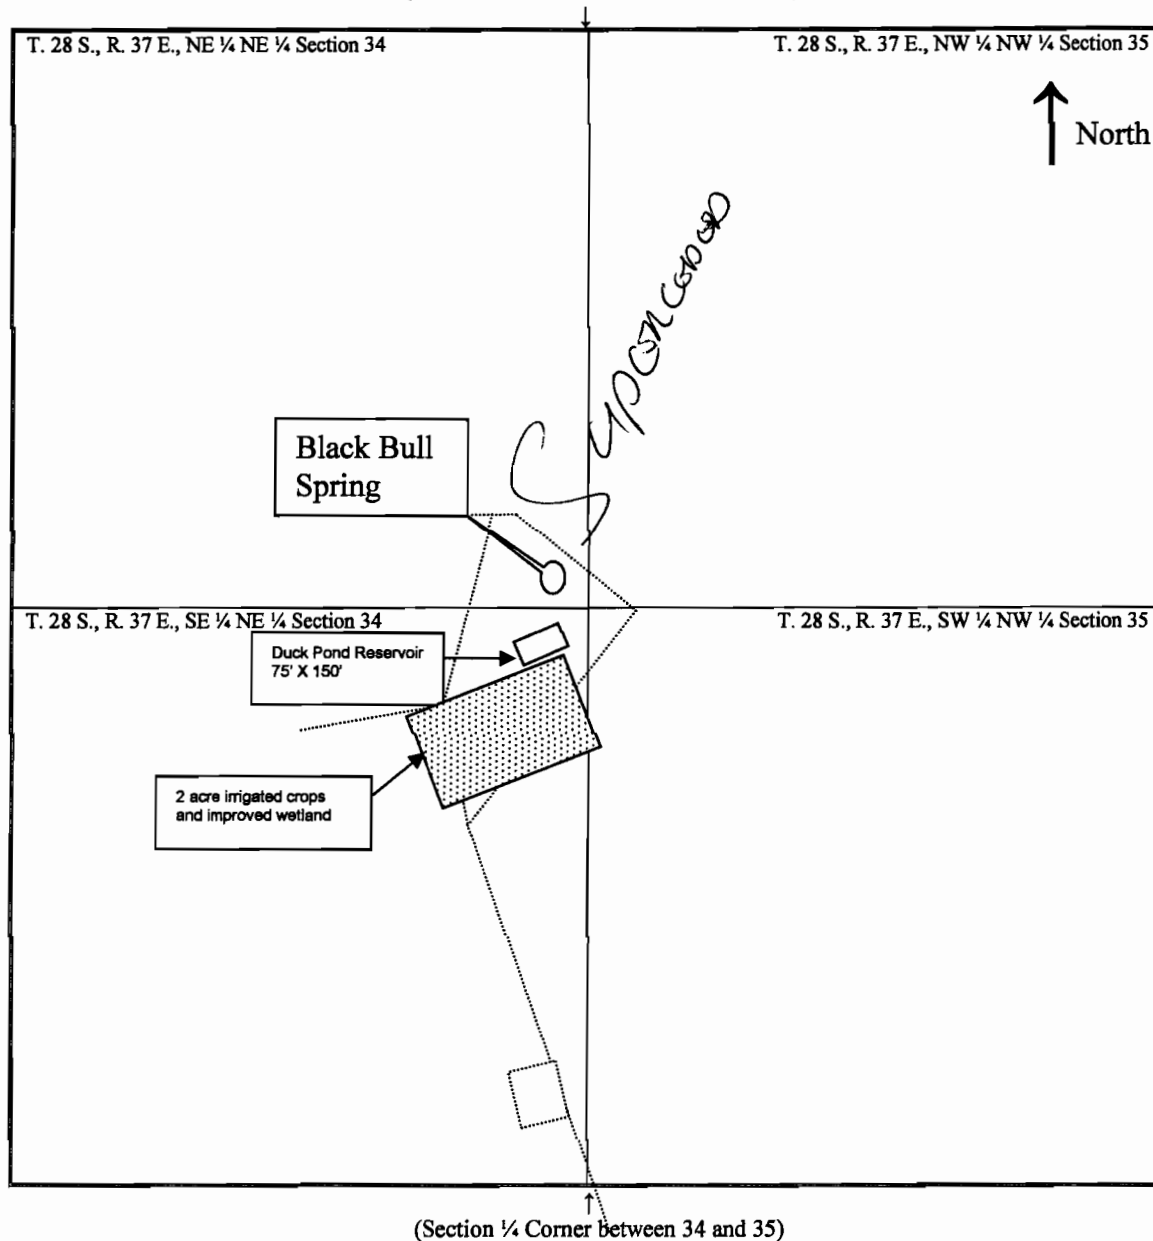

1" = 440 feet 6" = ½ mile. Pasture Fencing: _____
Township 28 South, Range 37 East, Section 34 E ½ NE ¼ and Section 35 W ½ NW ¼.
Malheur County Tax Lot # 1900.
July 11, 2009

RECEIVED

AUG 03 2009

WATER RESOURCES DEPT
SALEM, OREGON