

7.2.09

supersedes corrected 4.28.09 map

SECTION PLAT

Dabe Hawk

Dist. Wm Div 10


Section 15

Township 24 S

Range 33 E

County of Harney State of Oregon

NORTH

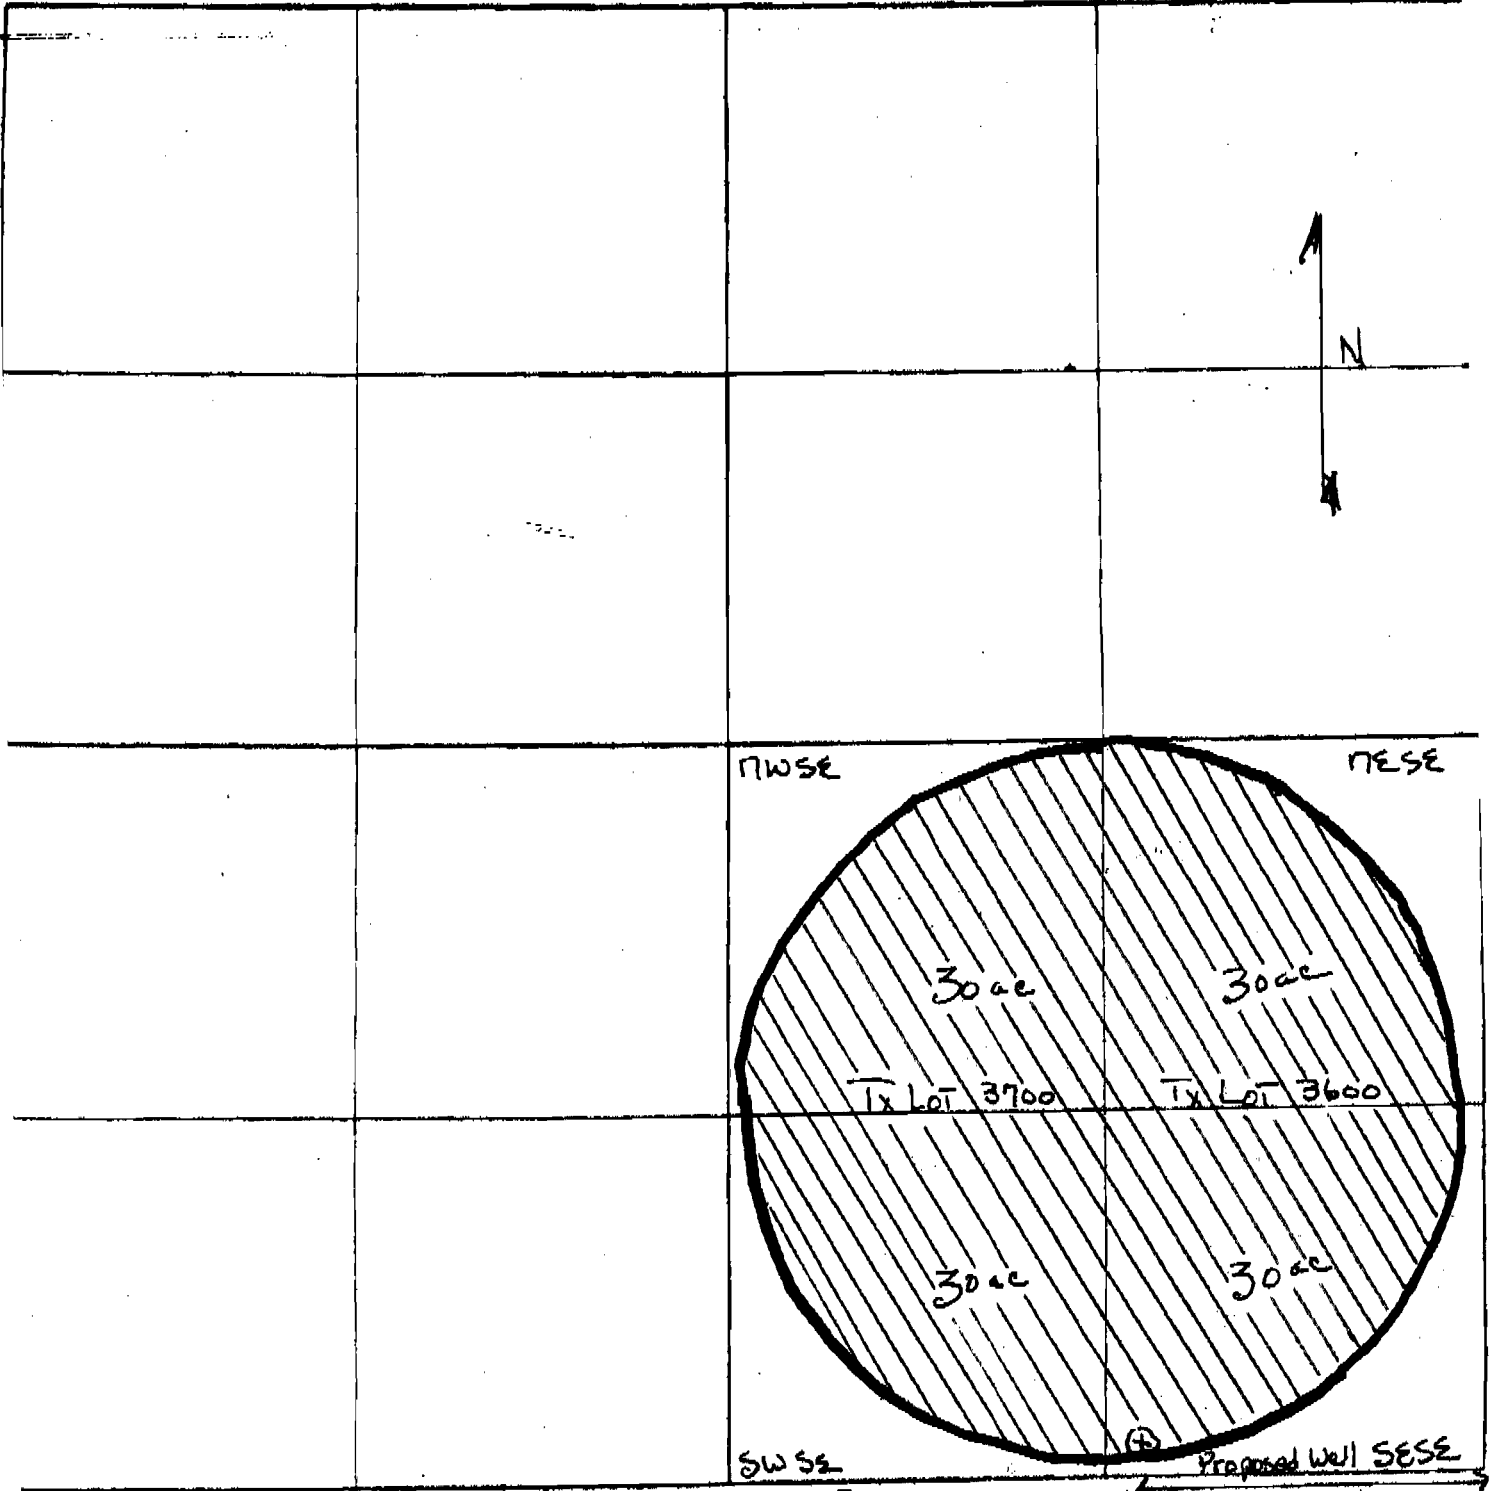

T. Donne Leach
 4153 Collins DR.
 Madras, Oregon