



T. 25 S., R. 31 E., WM
SECTIONS 3, 4, 9 & 10
TAX LOT # 300
HARNEY COUNTY, OREGON


G-17254

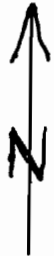

1" = 660'

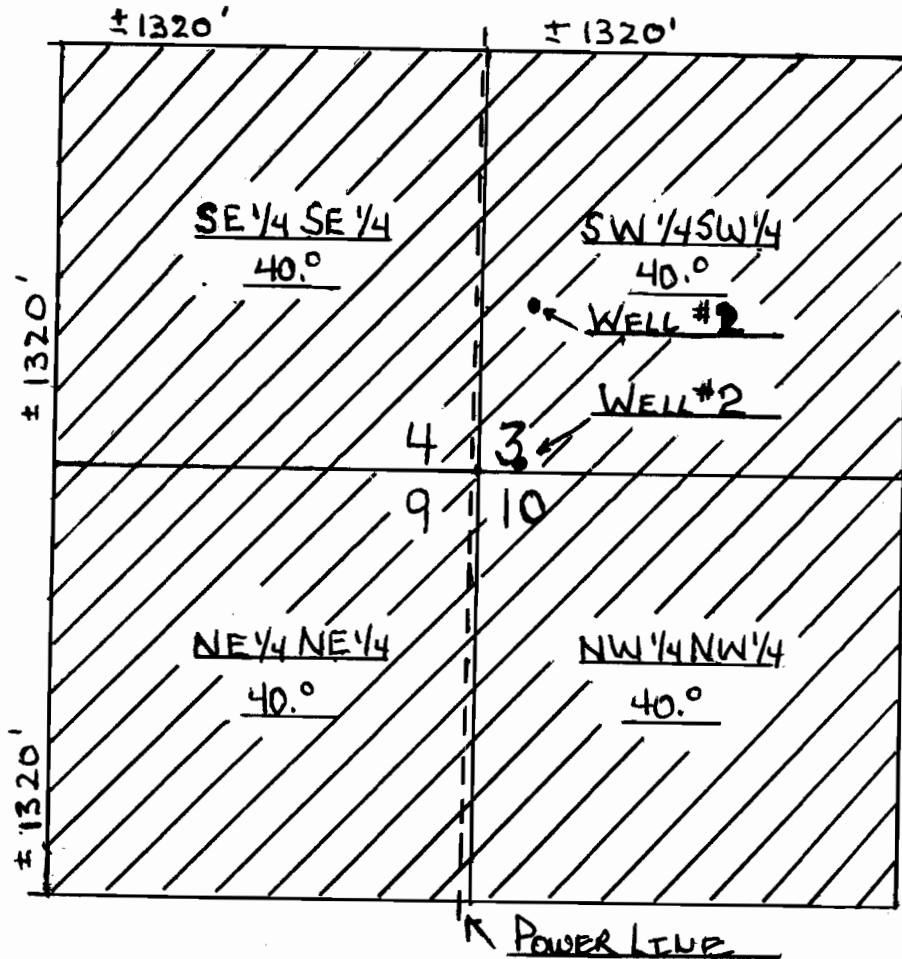

AREA IRRIGATED

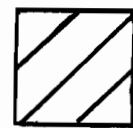

WELL #1: 545 FT NORTH AND, 165 FT
EAST OF SOUTHWEST CORNER OF
SECTION # 3.

WELL #2: 20 FT NORTH AND, 195 FT
EAST OF SOUTHWEST CORNER OF
SECTION # 3.

RECEIVED

AUG 20 2009

WATER RESOURCES DEPT
SALEM, OREGON