


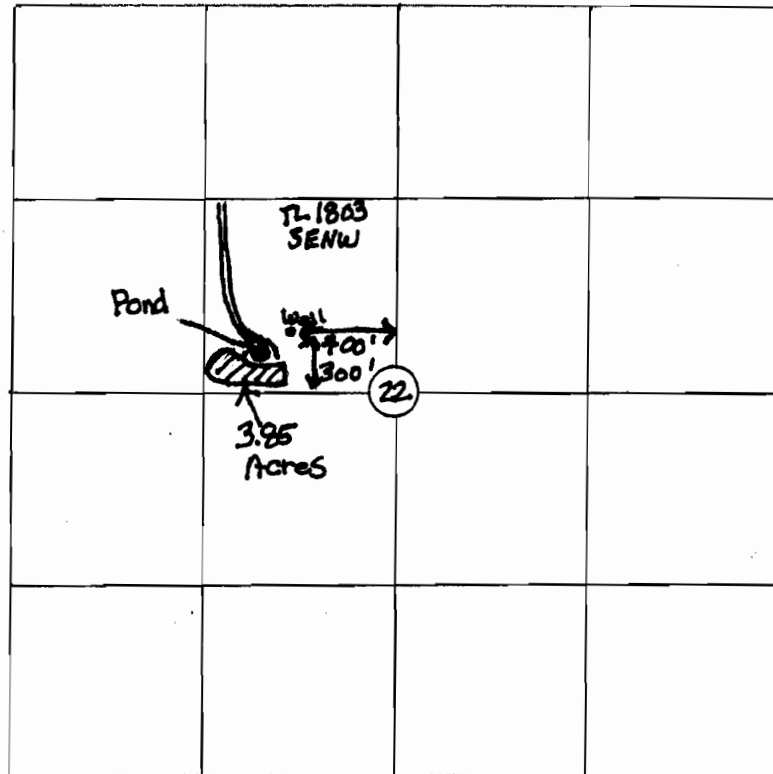

 Area to be irrigated



AUG 21 2009

WATER RESOURCES DEPT
SALEM, OREGON

Township 14 South Range 10 East Section 22
SE NW, 4. M.

Well location: 700' West & 300' North From Center of Section 22,
T14S, R10E, SENE, WM

70240 Stevens Canyon Road Sisters, OR 97759

Application No. Permit No.

IN NAME OF

Connie C Hines

Surveyed 19....., by