

T18S, R8E Sec 32
NW 1/4 of NE 1/4


TRACT M LOT 6

LOCATION MAP

Point of Diversion is 304' South, 3346' East of NW Corner section 32 T18S, R8E.

Sec ELK LAKE
3346' East

30 29
31 32

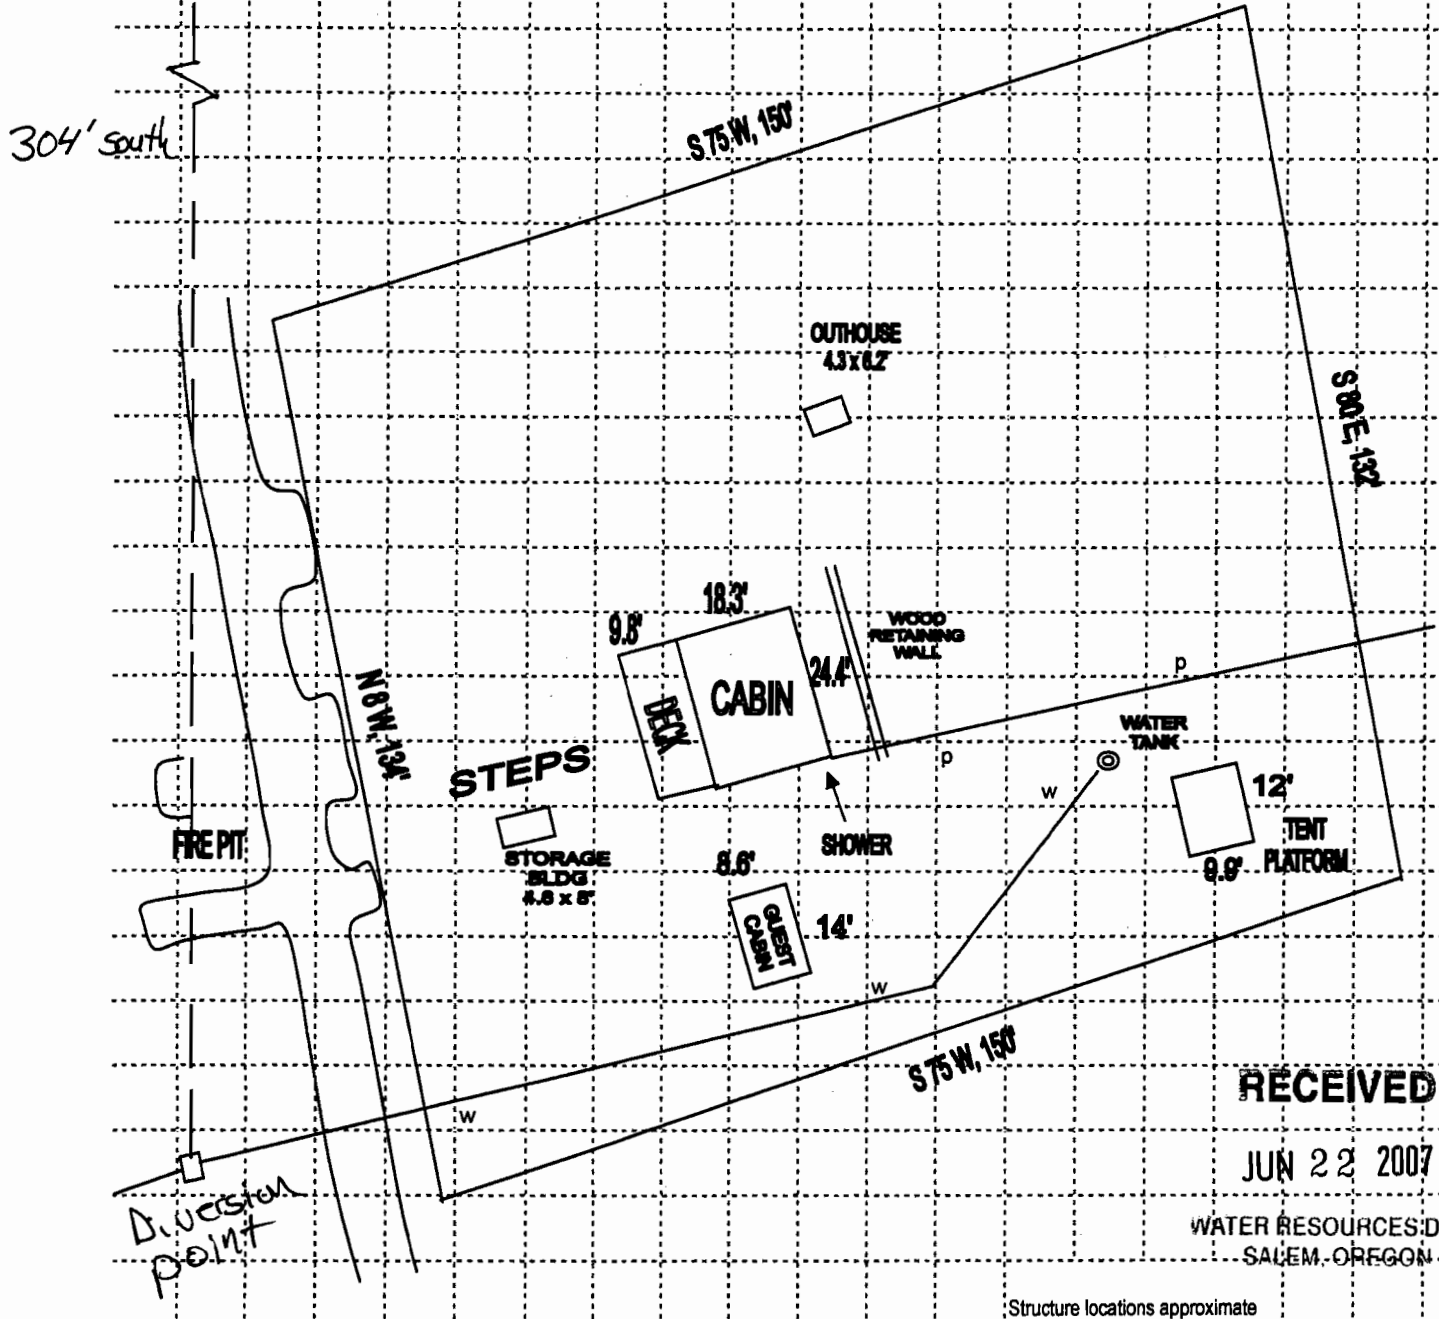

Date 9/8/2004

Scale in Feet



LEGEND

—	Structures
-- w --	Water lines
≡	Septic Field
==	Roads
⊙	Fire Pits
⊗	Well
-- p --	Power - Overhead
-- u --	Power - Buried

appno 5-86905