


8/26/2009

Alternate Review Reservoir Application Map
For
Michael Ensign

R-87519

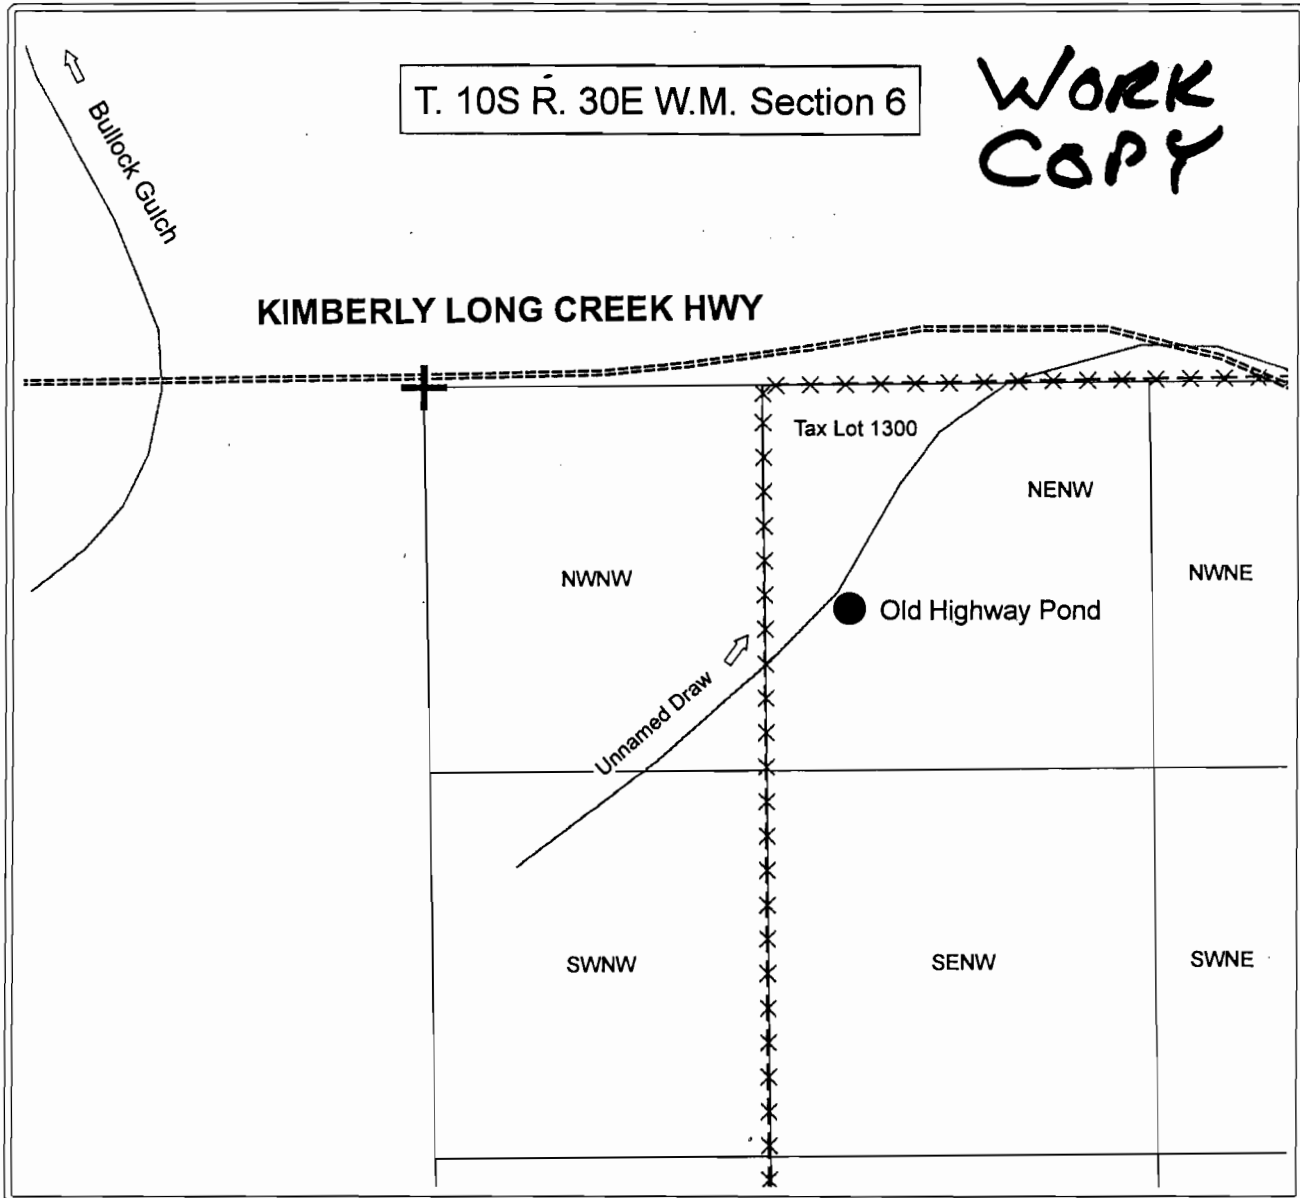

Pond Location is approx 780 feet South and 1445 feet East of
the ~~NE~~ corner of Section 6, T. 10S R. 30E W.M. being within
the NE1/4 NW1/4 of Section 6, T. 10S R. 30E W.M.

CORRECTION NW CORNER

*** Tax Lot Boundary

RECEIVED

AUG 21 2009

WATER RESOURCES DEPT
SALEM, OREGON




1" = 660 feet

R-87519

Alternate Review Reservoir Application Map
For
Michael Ensign

2-87519

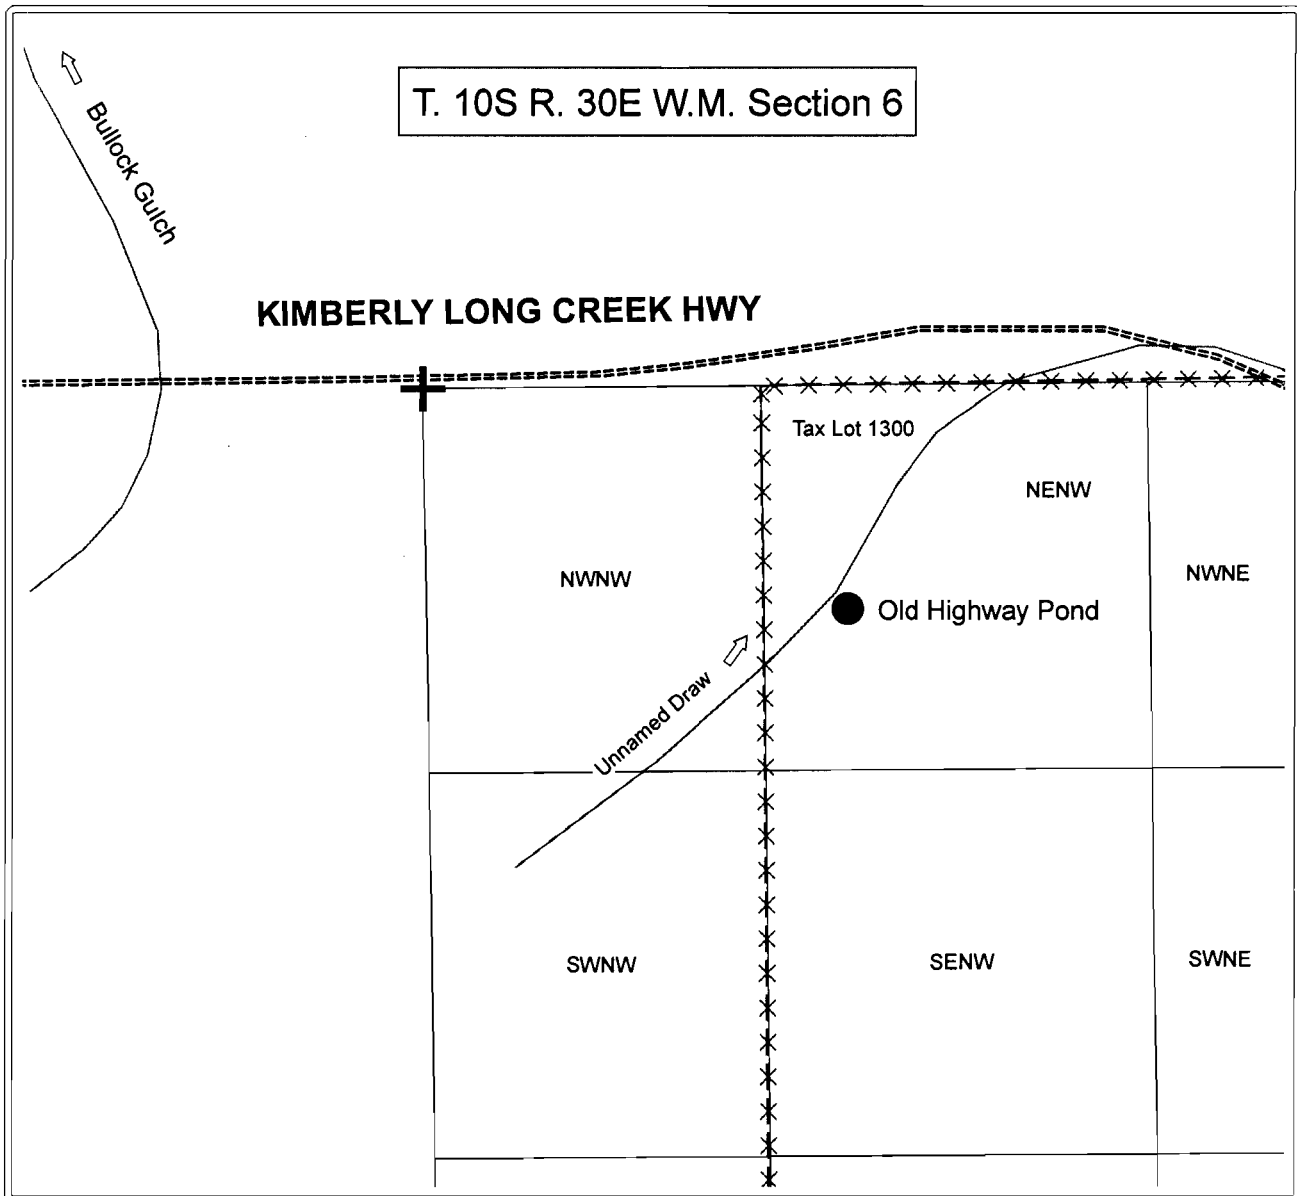

Pond Location is approx 780 feet South and 1445 feet East of the NE corner of Section 6, T. 10S R. 30E W.M. being within the NE1/4 NW1/4 of Section 6, T. 10S R. 30E W.M.

RECEIVED

AUG 21 2009

WATER RESOURCES DEPT
SALEM, OREGON



1" = 660 feet

* * * Tax Lot Boundary