

Jerry Sauter

From: jan ensign [janensign@live.com]
Sent: Wednesday, August 26, 2009 7:20 AM
To: Jerry Sauter
Subject: RE: Reservoir applications

From: sauterjk@wrд.state.or.us
To: Janensign@live.com
Date: Tue, 25 Aug 2009 15:45:25 +0000
Subject: Reservoir applications

Craig,
Here is the information that you and Herb have talked about. If you could look over the corrections and reply back that they are ok with you, that would resolve the issue.
Thanks for your assistance.
Sincerely,
Jerry Sauter

[illegible]

Jerry Sauter
Water Rights Program Analyst
Water Rights Section
Water Resources Department
725 Summer Street NE, Suite A
Salem, Oregon 97301
Telephone 503.986.0817 Fax 503-986-0901


Messages to and from this e-mail address may be available to the public under Oregon Law
I have reviewed and approve the changes made on the three reservoir applications.
Craig J. Ensign

Hotmail® is up to 70% faster. Now good news travels really fast. Try it now.

APPEARS TO BE A HIK UP ON
LOCATION BETWEEN LAMDA CIE SHAP
DESCRIPTION
K
SHOULD BE UPPER CANN
POUND, THEN EVERYTHING
MATCHES. K
UPPER CABIN

**Alternate Review Reservoir Application Map
For
Craig Ensign**

R-67524

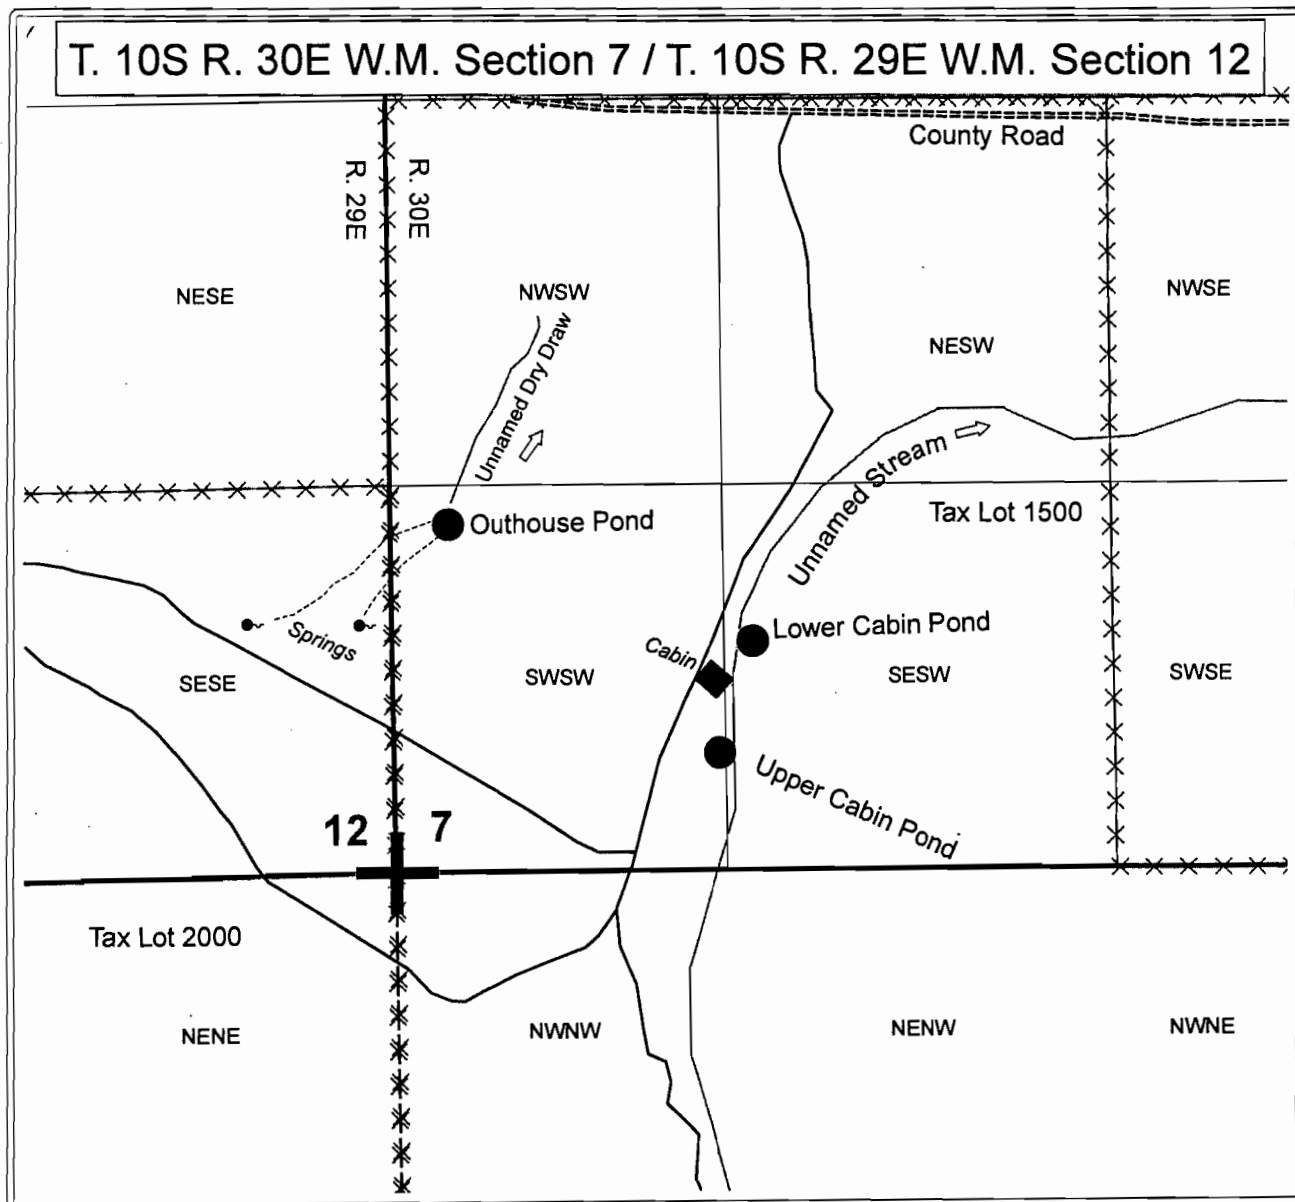

Pond Location is approx 400 feet North and 1120 feet East of the SW corner of Section 7 of T. 10S R. 30E W.M. being within the SW1/4 SW1/4 of Section 7, T. 10S R. 30E W.M.

RECEIVED

AUG 21 2009

WATER RESOURCES DEPT
SALEM, OREGON




1" = 660 feet

*** Tax Lot Boundary

Alternate Review Reservoir Application Map
For
Craig Ensign

R-87524

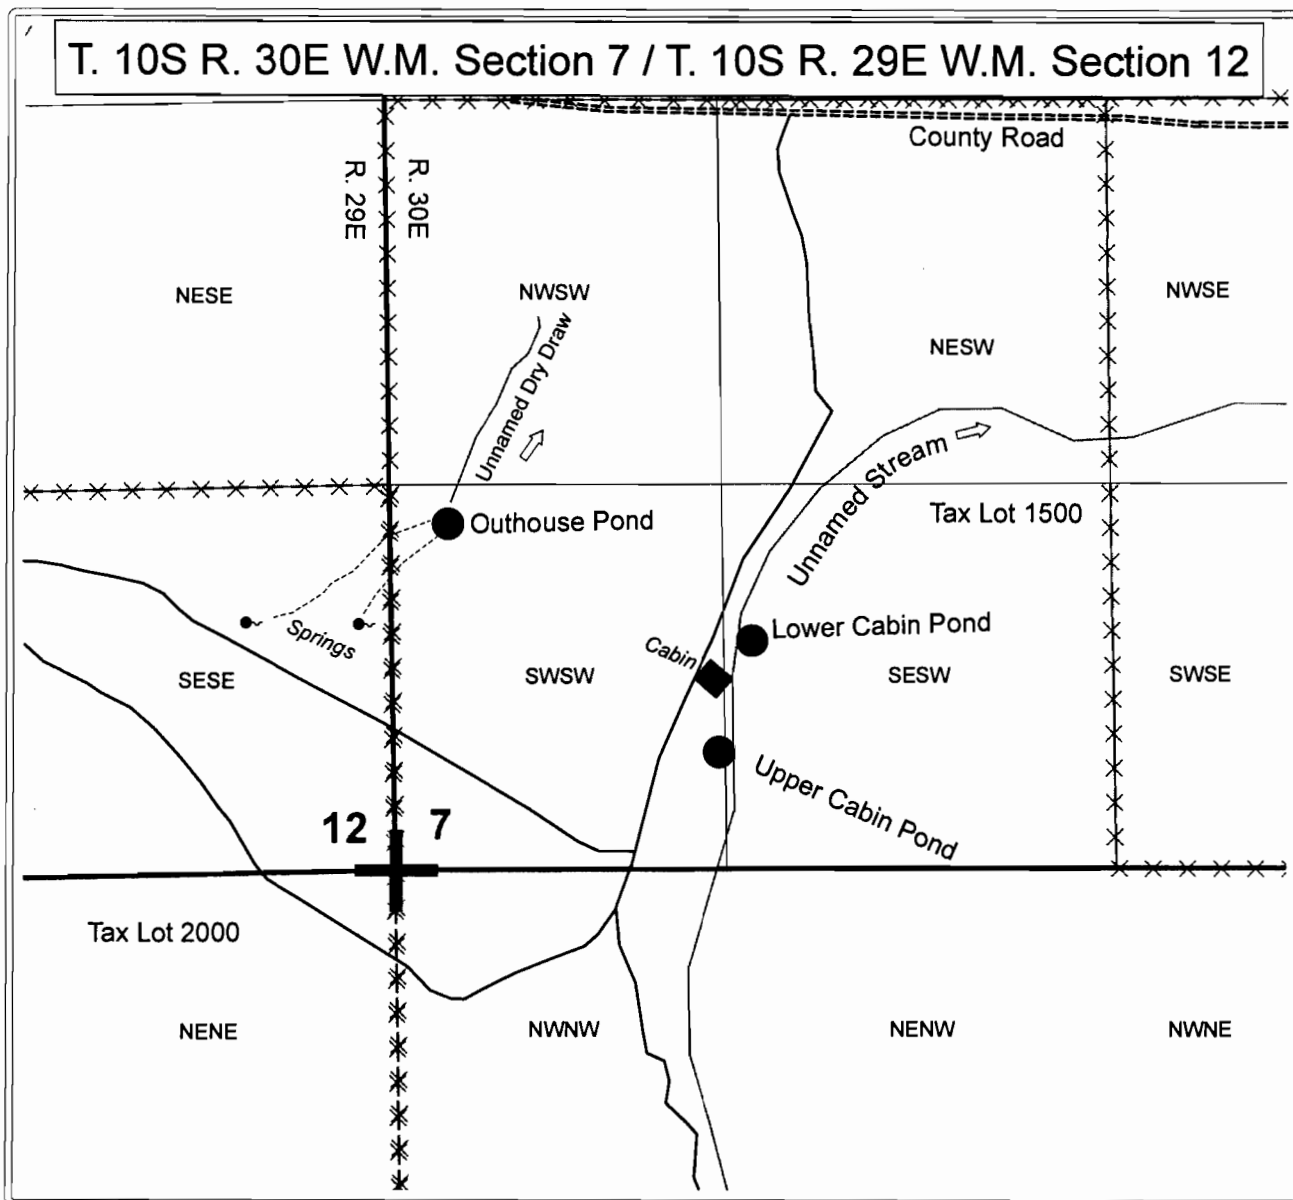

Pond Location is approx 400 feet North and 1120 feet East of the SW corner of Section 7 of T. 10S R. 30E W.M. being within the SW1/4 SW1/4 of Section 7, T. 10S R. 30E W.M.

RECEIVED

AUG 21 2009

WATER RESOURCES DEPT
SALEM, OREGON

1" = 660 feet

*** Tax Lot Boundary
