


North

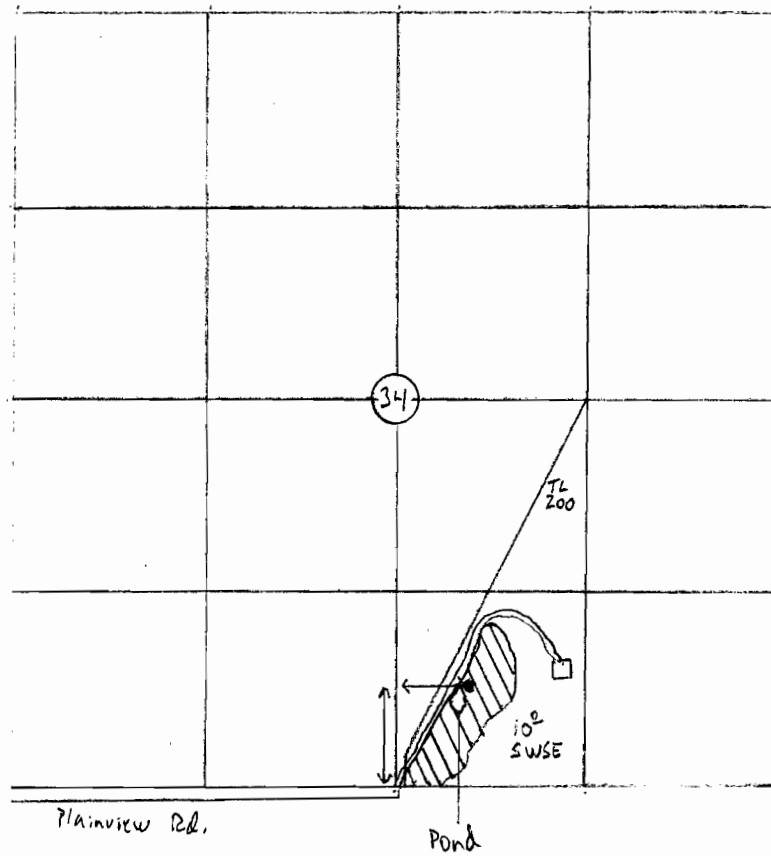

RECEIVED

AUG 27 2009

WATER RESOURCES DEPT
SALEM, OREGON

Well-located; Township 15 South Range 11 East Section 34 W.M.
Being 600' north & 520' east of S 1/4 corner of Section 34 SWSE
Scale 1" = 1320'

FINAL PROOF SURVEY UNDER

Application No. Permit No.
IN NAME OF

In the name of Ramon J. Seidler

Surveyed 19....., by