

THIS MAP WAS PREPARED FOR
ASSESSMENT PURPOSE ONLY

SE1/4 SECTION 20 T.02N. R.48E. W.M.
WALLOWA COUNTY

G-17263

WORK
COPY

02N 48E 20D

CANCELLED NO.
102
105
106
200
300
301
1001
1300

IMPROVED ADJUSTED
ACCURATE SCALE
MAP

Well Location 1" = 400 FT.

SE 1/4 Section 20
T2N - R48E W.M.
1900' North & 170' East
From S 1/4 corner of sec 20

Tax Lot 104

Acres Location

4.60 AC - NE 1/4 SE 1/4

.40 AC - SW 1/4 NE 1/4

5.00 AC total

Scale 1" = 400'

Key

POA = o (well)

POA =  (5.00 AC)

WATER RESOURCES DEPT
SALEM, OREGON


SEP 18 2009

RECEIVED

SEE MAP 02N 48E 20

FD. STONE
S 1/4 COR.
SEC. 20

6-2

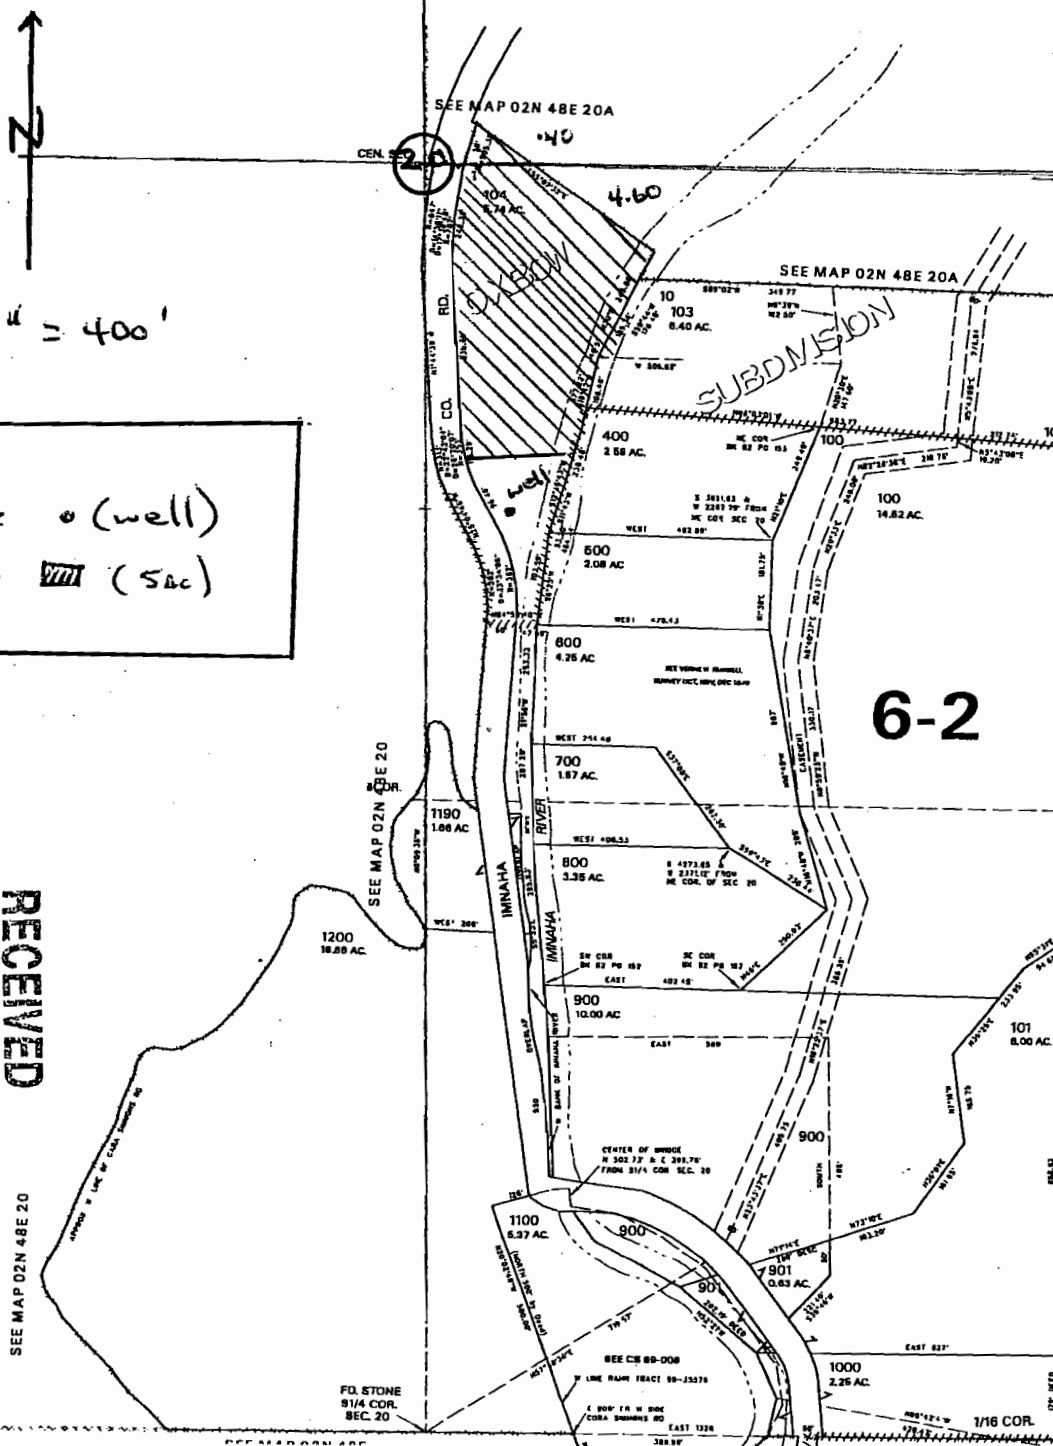

SE1/4 SECTION 20 T.02N. R.48E. W.M.
WALLOWA COUNTY

CANCELLED NO.
102
105
106
200
300
301
1001
1300

Key

POA = • (well)

$P_{04} = \boxed{\text{VII}}$ (5_{ΔC})

well Location

SE $\frac{1}{4}$ Section 20
T2N - R48E W.M.
1900' North & 170' East
From S $\frac{1}{4}$ Corner of sec 20

Tax Lot 104

Acres Location

4.60 AC - NE $\frac{1}{4}$ SE $\frac{1}{4}$

.40 ac - SW 1/4 NE 1/4

5.00 Ac total

64-7263

REC'D

SEP 18 2009

WATER RESOURCES DEPT
SALEM, OREGON