


T. 19 S., R. 47 E., W. M.

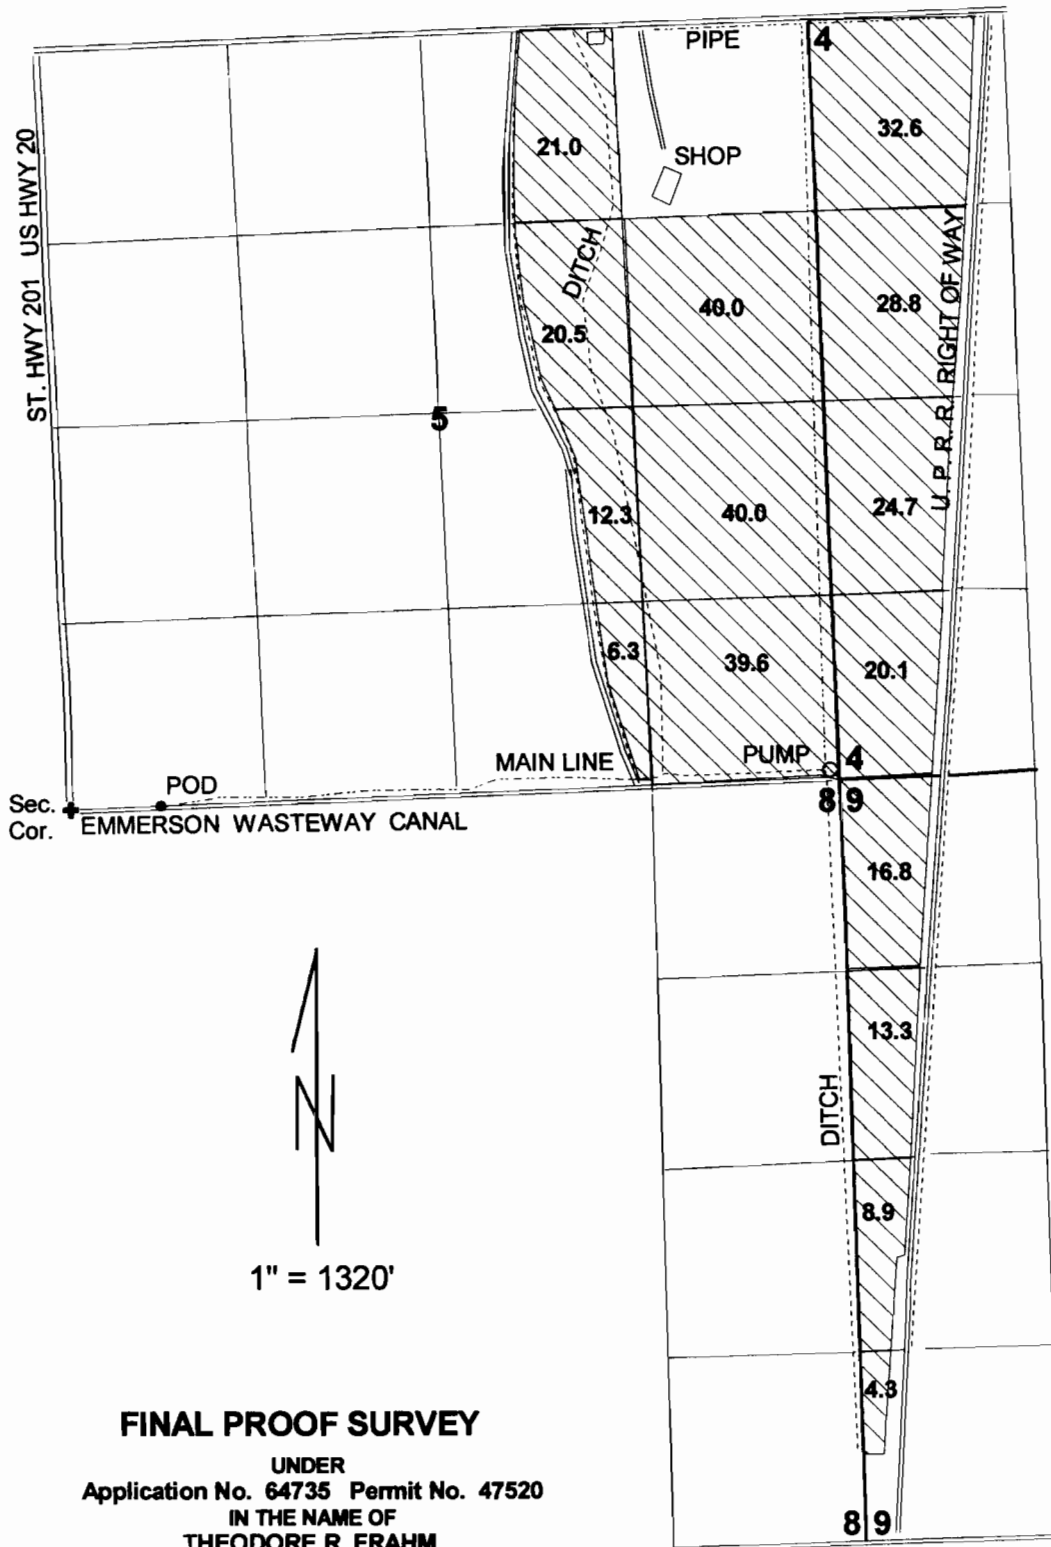

FINAL PROOF SURVEY
UNDER
Application No. 64735 Permit No. 47520
IN THE NAME OF
THEODORE R. FRAHM
Surveyed: 4-09-2003 by: J. Miller