

R-87535

CASSIDY RESRVIORS

T 19S- R 4W-WM SECTION 31
LANE COUNTY OREGON

SCALE 1 INCH = 200 FEET

CORRECTED APPROX ADJUSTED SCALE



NORTH

SE 1/4 SE 1/4

TAX LOT 400

CREEK TRIBUTARY TO COYOTE CREEK

SPILLWAY

856'

CASSIDY # 2

SPILLWAY

GALVANIZED BURRIED CULVERT

CASSIDY # 3

660'

RECEIVED

OCT 02 2009

WATER RESOURCES DEPT
SALEM, OREGON

31

32

SOUTH EAST CORNER OF
T19 S-R4 W-SECTION 31

WORK
COPY


CASSIDY RESRVIORS

**T 19S- R 4W-WM SECTION 31
LANE COUNTY OREGON**

SCALE 1 INCH = 200 FEET



NORTH

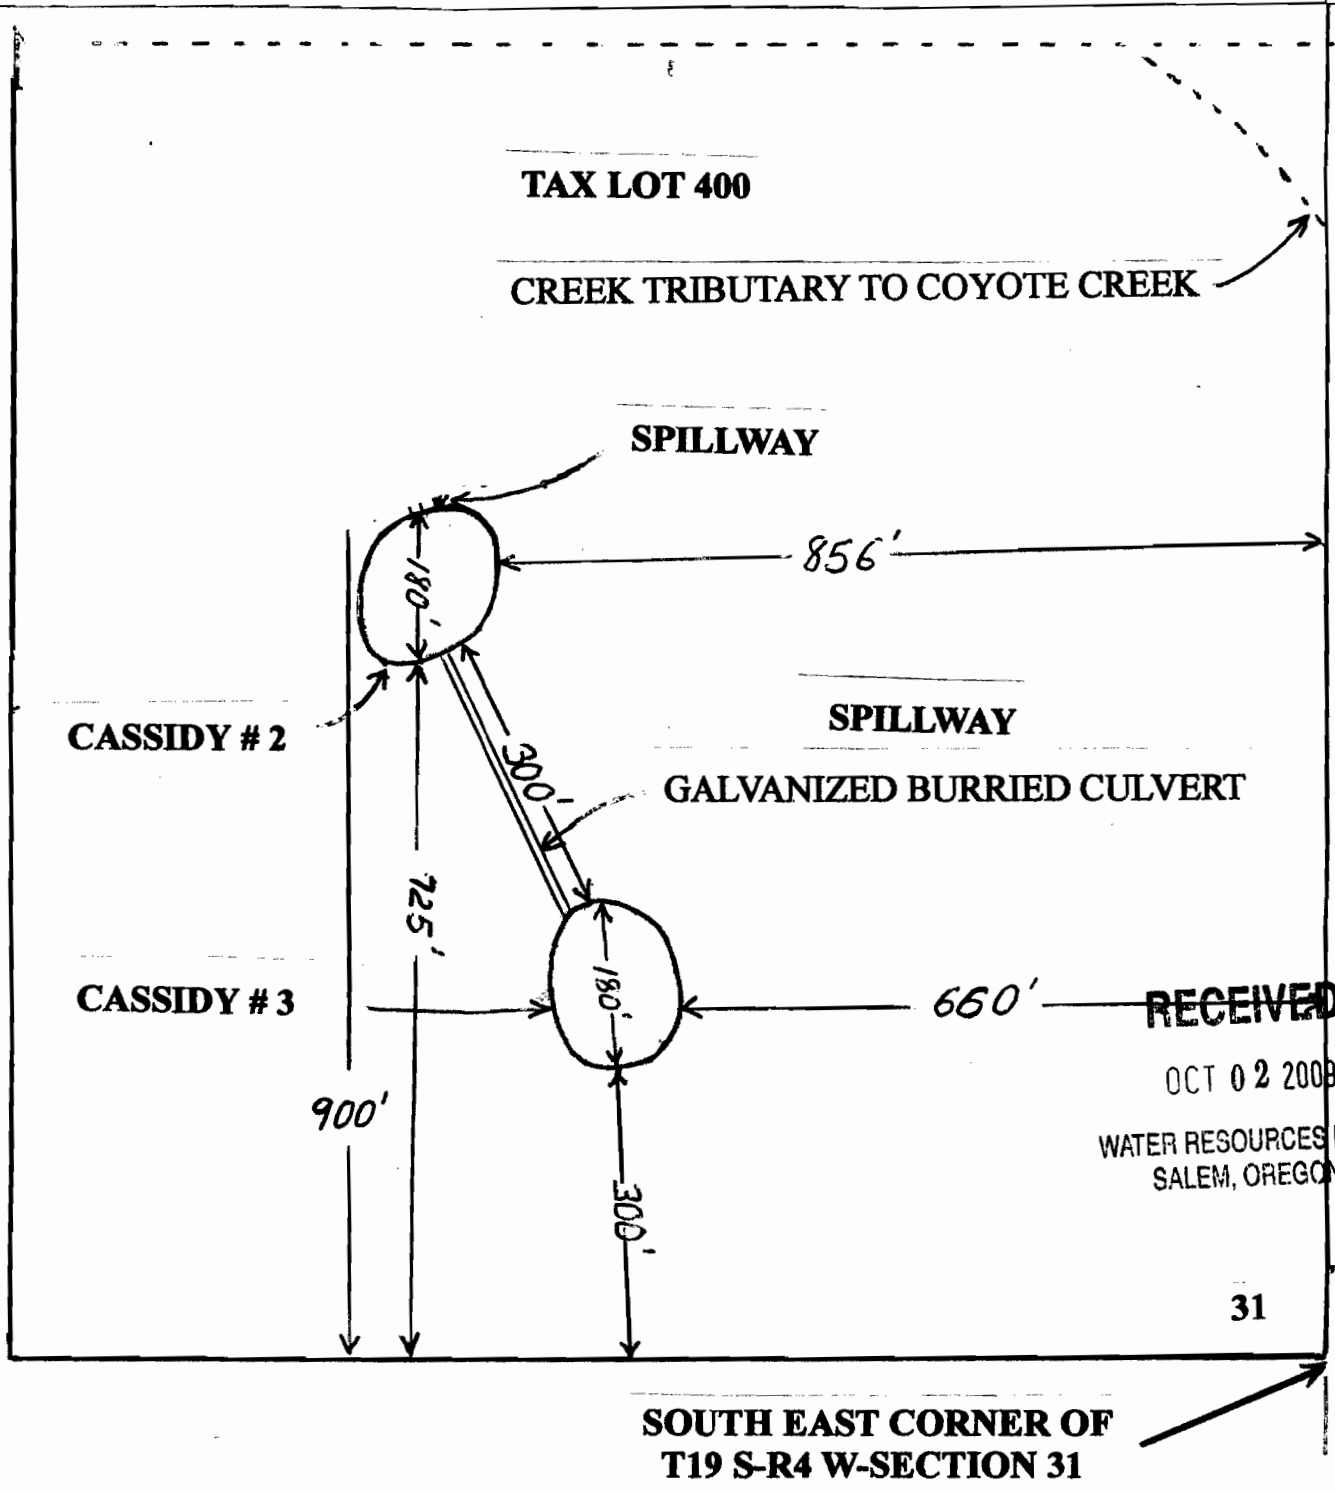

R-87535

FOR ASSESSMENT AND
TAXATION ONLY

SECTION 31 T.19S. R.4W. W.M.
Lane County

