

**CUTSFORTH PARK
POND TOPOGRAPHICAL
SURVEY, 5/19/09**

Ferguson Surveying



Engineering



**P.O. BOX 519, 210 E. MAIN
MT. VERNON, OR 97865
PHONE (541)932-4520
FAX (541)932-4430
EMAIL dfse@oretelco.net**

Scale 1"=50'

RECEIVED


OCT 08 2009

WATER RESOURCES DEPT
SALEM, OREGON

1-2

Park Boundary

CENTER SEC. 27 4

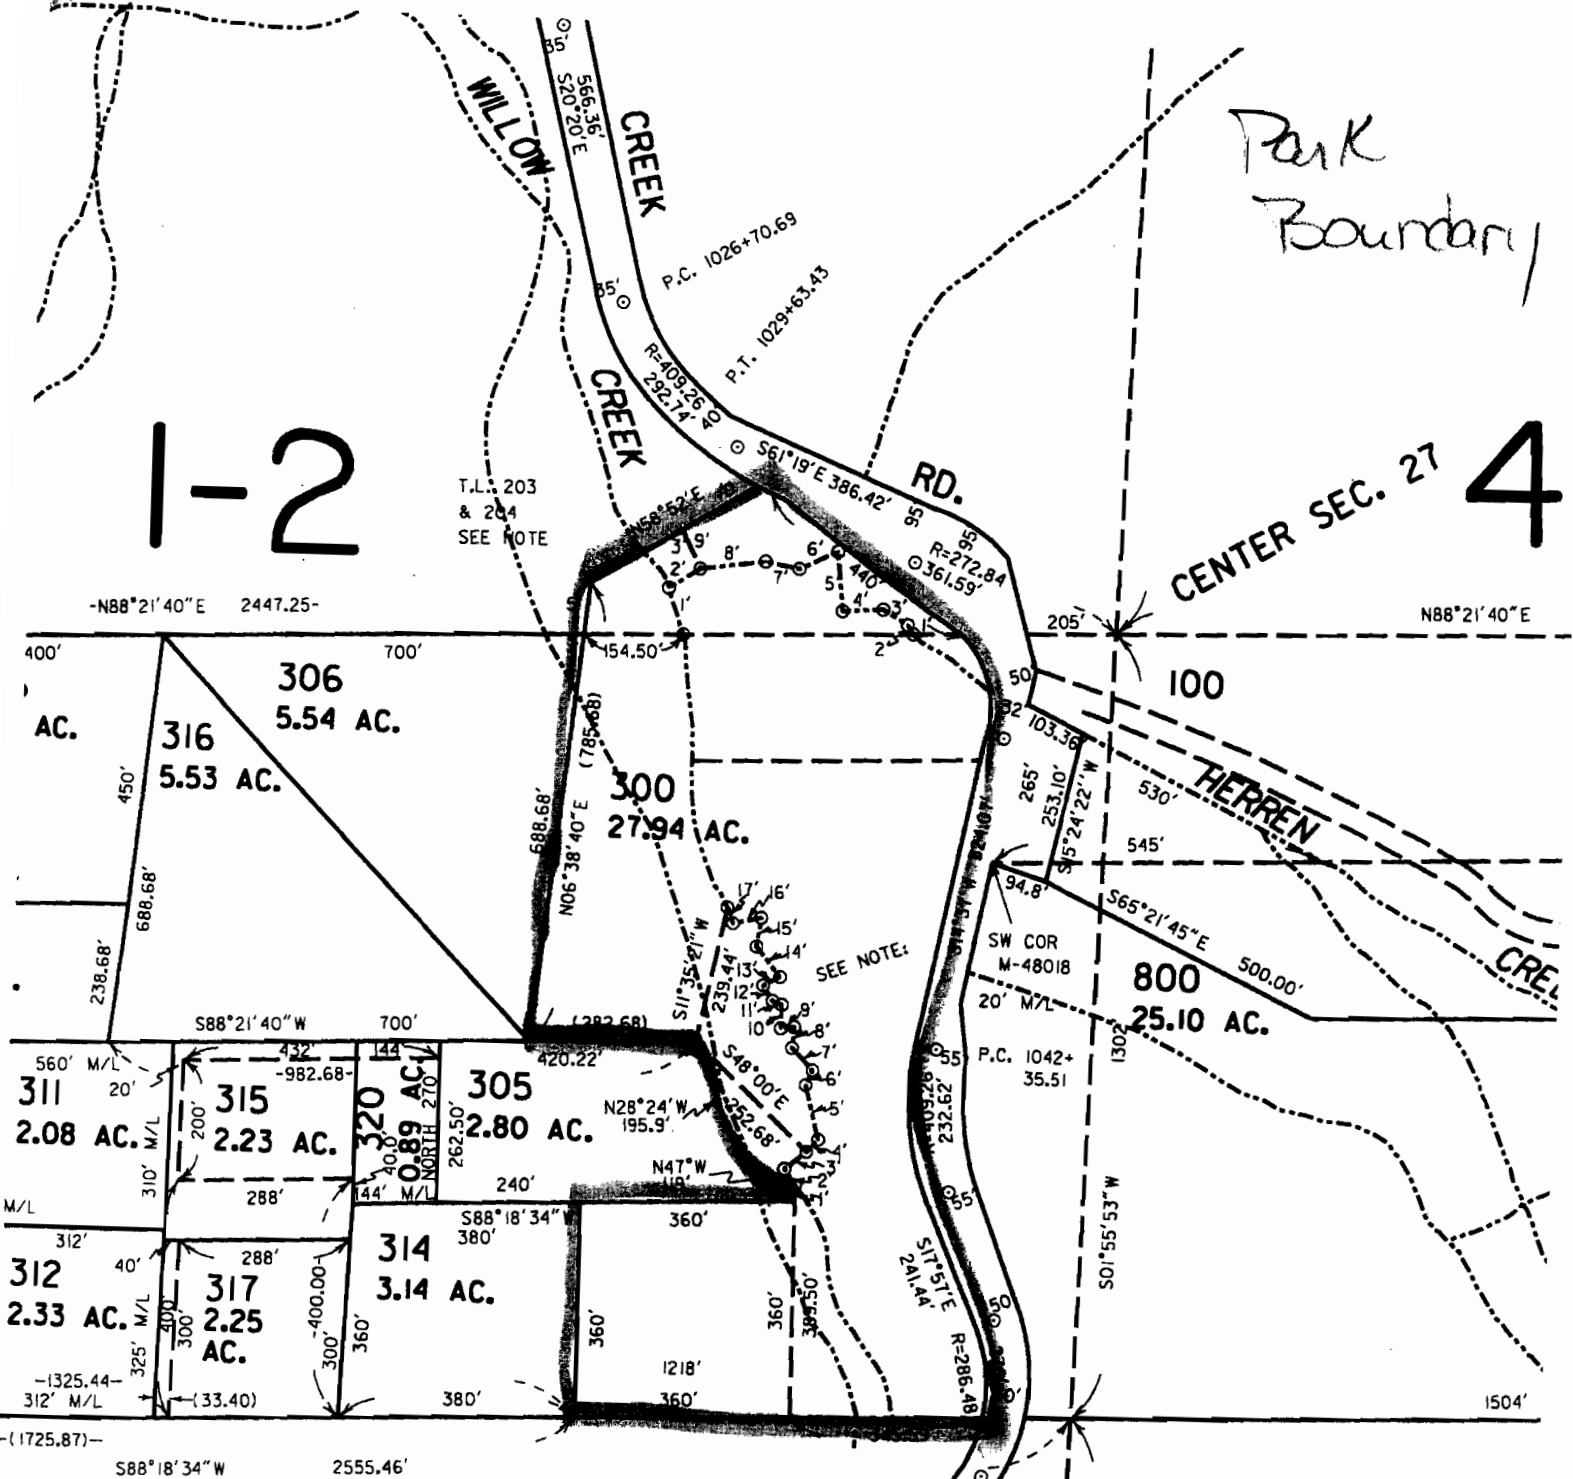

RECEIVED

OCT 08 2009

WATER RESOURCES DEPT
SALEM, OREGON

NOTE: T.L.30


- 1. NORTH 29.50'
- 2. N50°43'W 36.00'
- 3. N47°49'E 47.82'
- 4. N47°49'E 22.38'
- 5. N16°09'W 93.10'
- 6. N29°29'E 37.20'
- 7. N52°33'W 44.80'

THIS MAP WAS PREPARED FOR ASSESSMENT PURPOSE ONLY

SECTION 27 T.4S. R.28E. W.M. MORROW COUNTY

1" = 400'

ADJUSTED CORRECTED APPROX SCALE 1" = 600 FEET

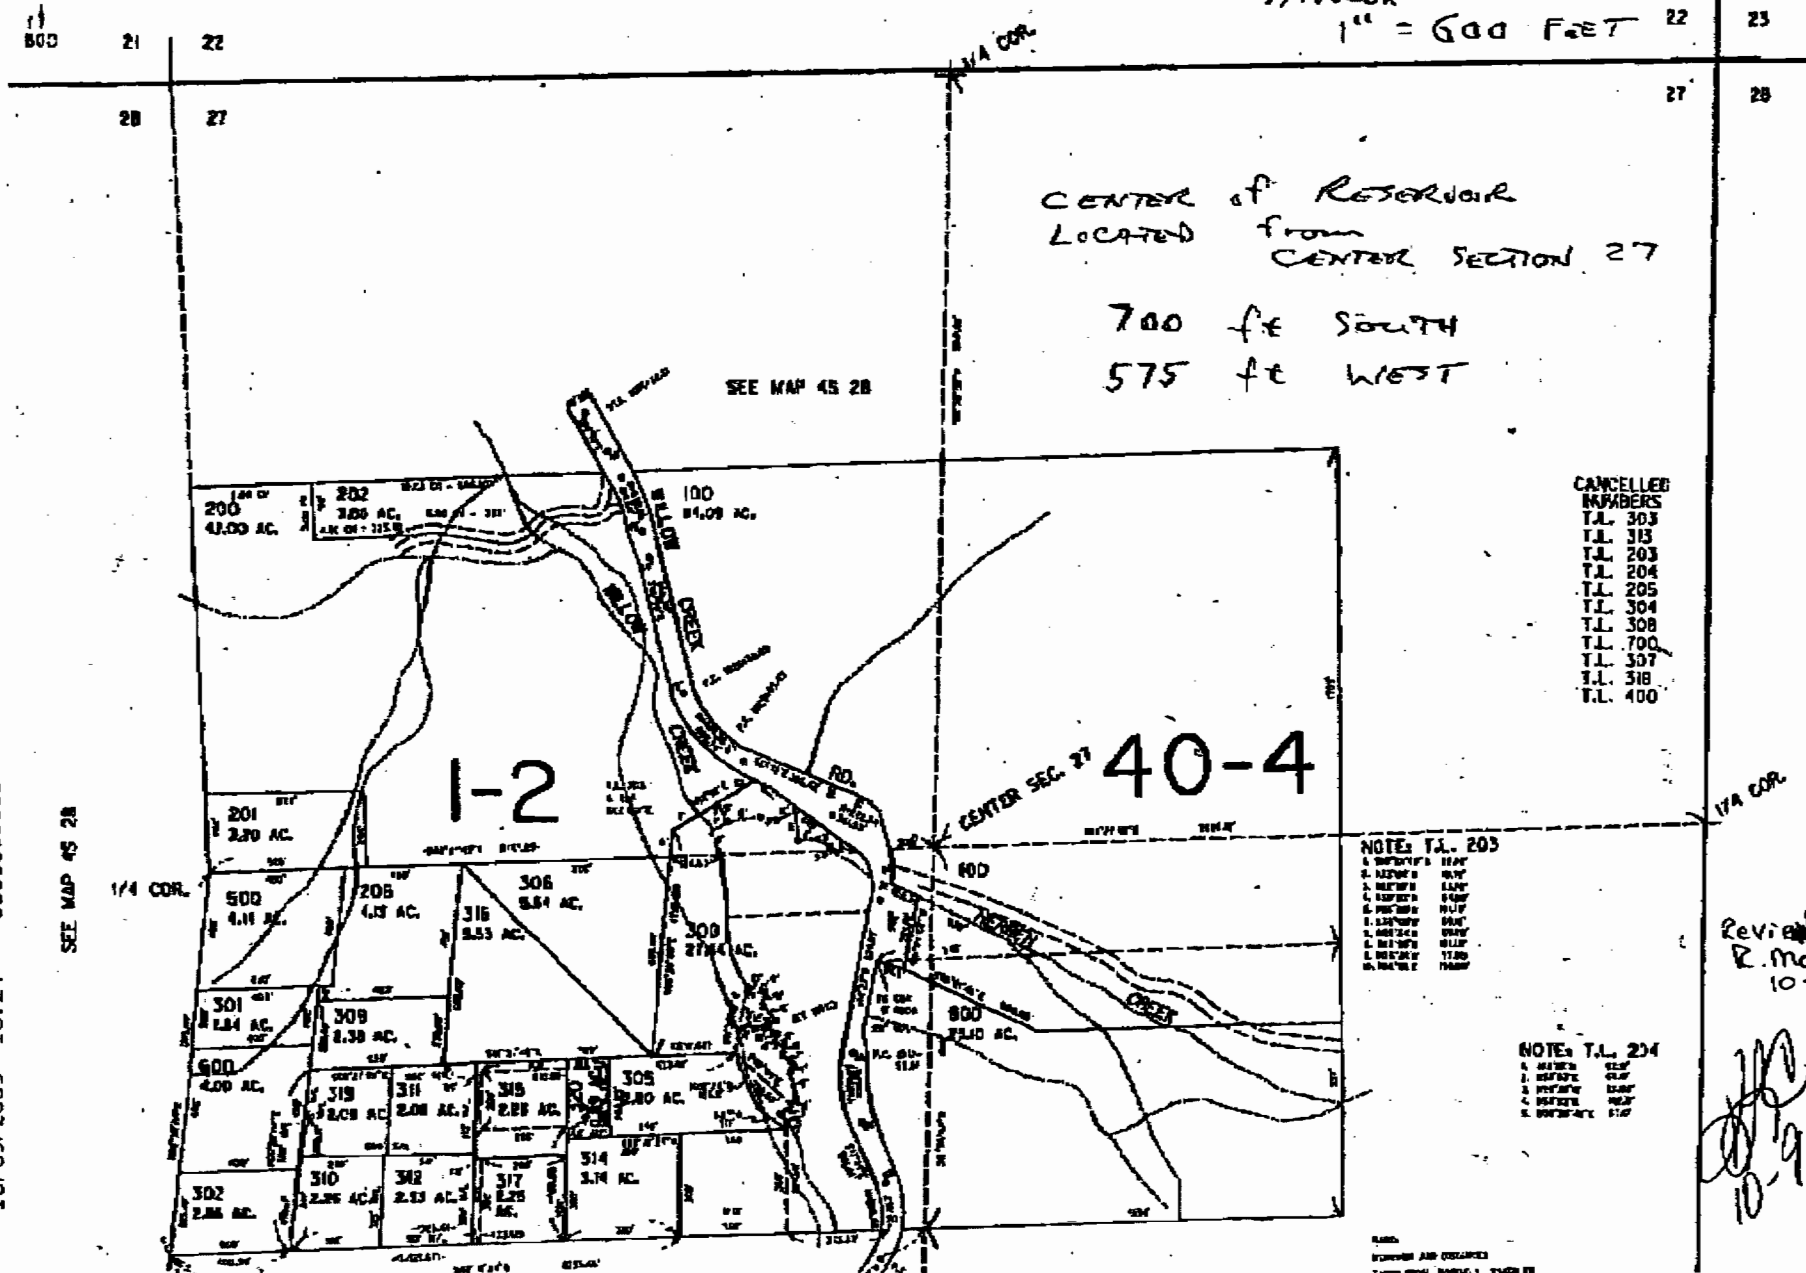

CENTER of RESERVOIR LOCATED FROM CENTER SECTION 27 700 FE SOUTH 575 FE WEST

- CANCELLED MAPS
- T.L. 303
 - T.L. 313
 - T.L. 203
 - T.L. 204
 - T.L. 205
 - T.L. 304
 - T.L. 308
 - T.L. 700
 - T.L. 307
 - T.L. 318
 - T.L. 400

- NOTES T.L. 203

Reviewed by R. Montimore 10-9-09


[Handwritten signature]
10-9-09

THIS MAP WAS PREPARED FOR
ASSESSMENT PURPOSE ONLY

SECTION 27 T.4S. R.28E. W.M.
MORROW COUNTY
1" = 400'

4S 28 27

SCALE IN FEET
0 100 200

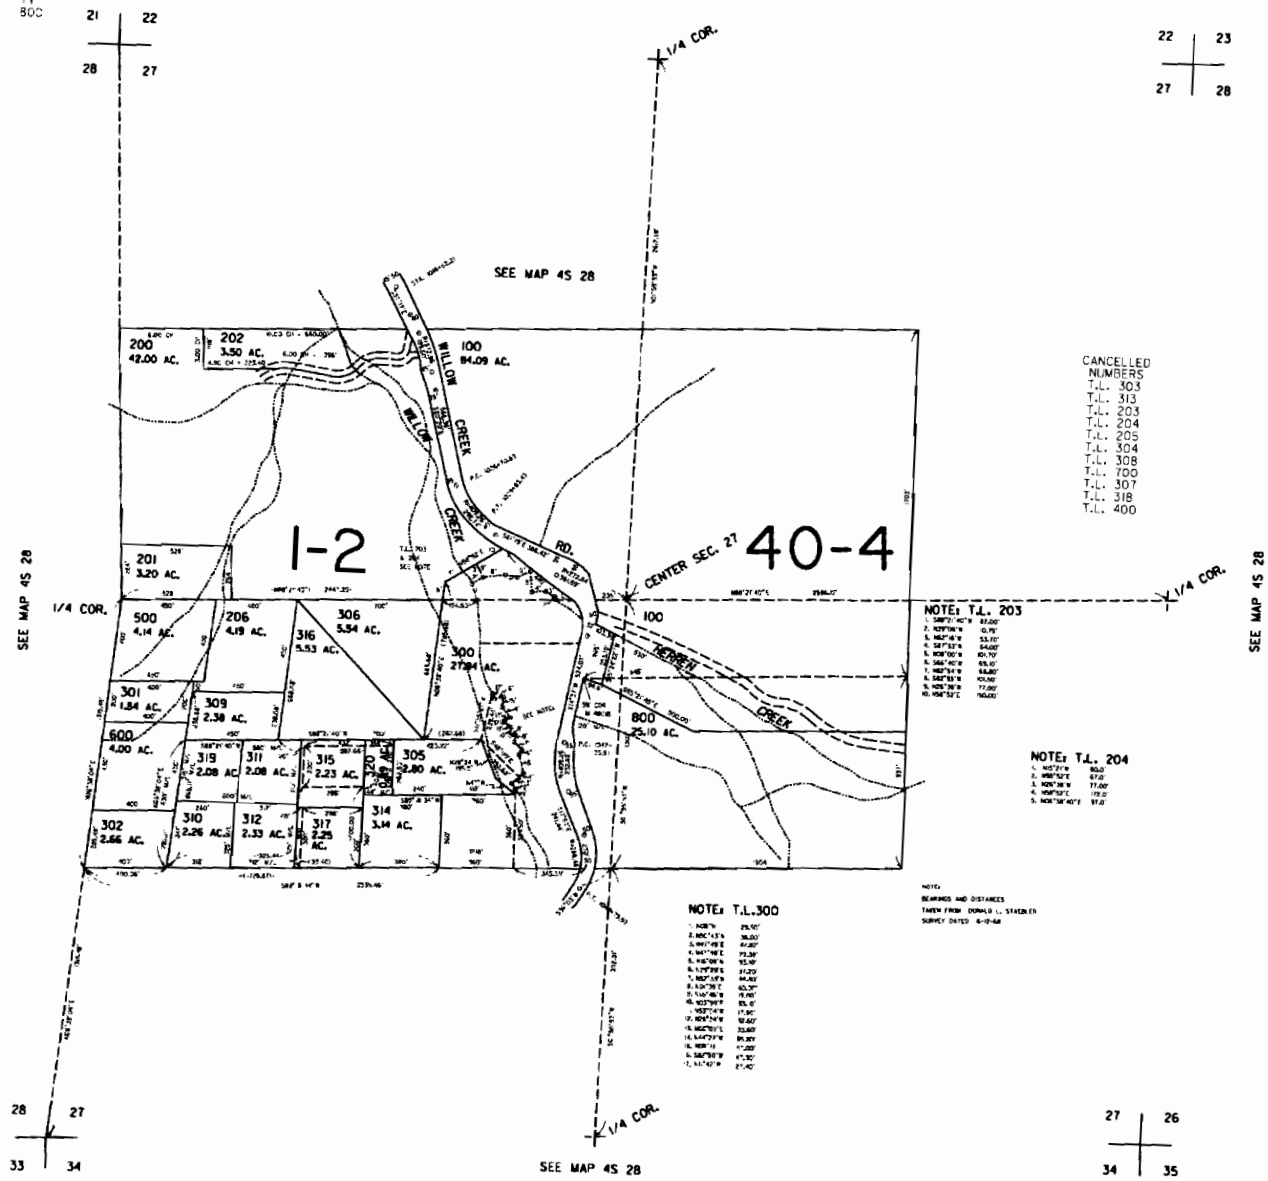

CANCELLED
NUMBERS
T.L. 303
T.L. 313
T.L. 203
T.L. 204
T.L. 205
T.L. 304
T.L. 308
T.L. 700
T.L. 307
T.L. 318
T.L. 400

NOTE: T.L. 203


NOTE: T.L. 300

NOTE:
BEARINGS AND DISTANCES
TAKEN FROM DONALD L. STICKLER
SURVEY DATED 6-10-88

RECEIVED
OCT 08 2009
WATER RESOURCES DEPT
SALEM, OREGON

Revised
8/12/2005, KH
4S 28 27

R-27536