

SECTION PLAT

647275

Section 2


Township 24-S

Range 30-E


County of Harney

State of OR

NORTH

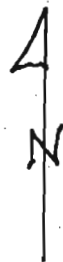

TL 1400

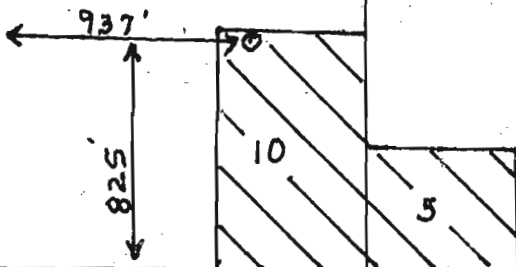

RECEIVED

OCT 21 2009

WATER RESOURCES DEPT
SALEM, OREGON

S

Remarks scale - 8" = 1 mile - 660) -