

T.9 S., R.27 E., W.M.

T-5339
C-53670

TRANSFER APPLICATION MAP
FOR
J. DONALD CAPON

T-5339




RECEIVED

AUG 6 1983

WATER RESOURCES DEPT.
SALEM, OREGON

C-39363

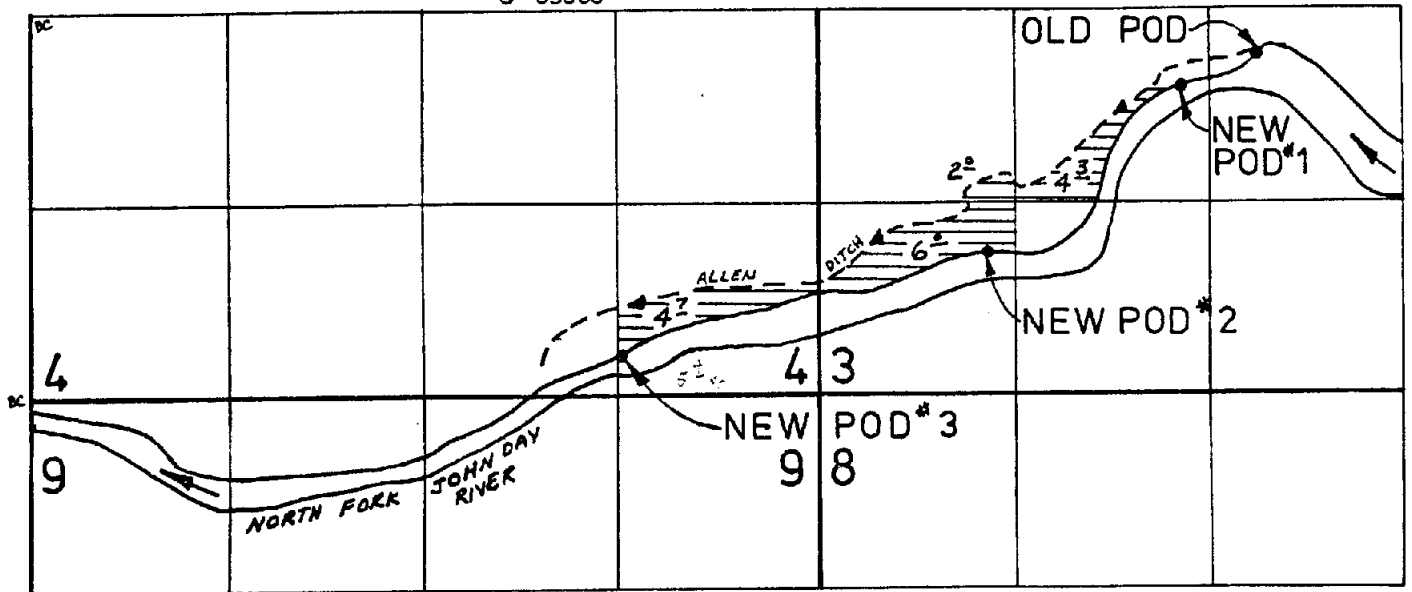

SCALE 4"=1mi

OLD POD

-N.49°E., 3814 ft from SW cor.
sec.3

APPROVED

NEW POD's

- #1-2100 ft N & 2470 ft E
- #2-970 ft N & 1150 ft E
- #3-270 ft N & 1310 ft W
- all from SW cor Sec.3

all T.9 S., R.27 E., W.M.