
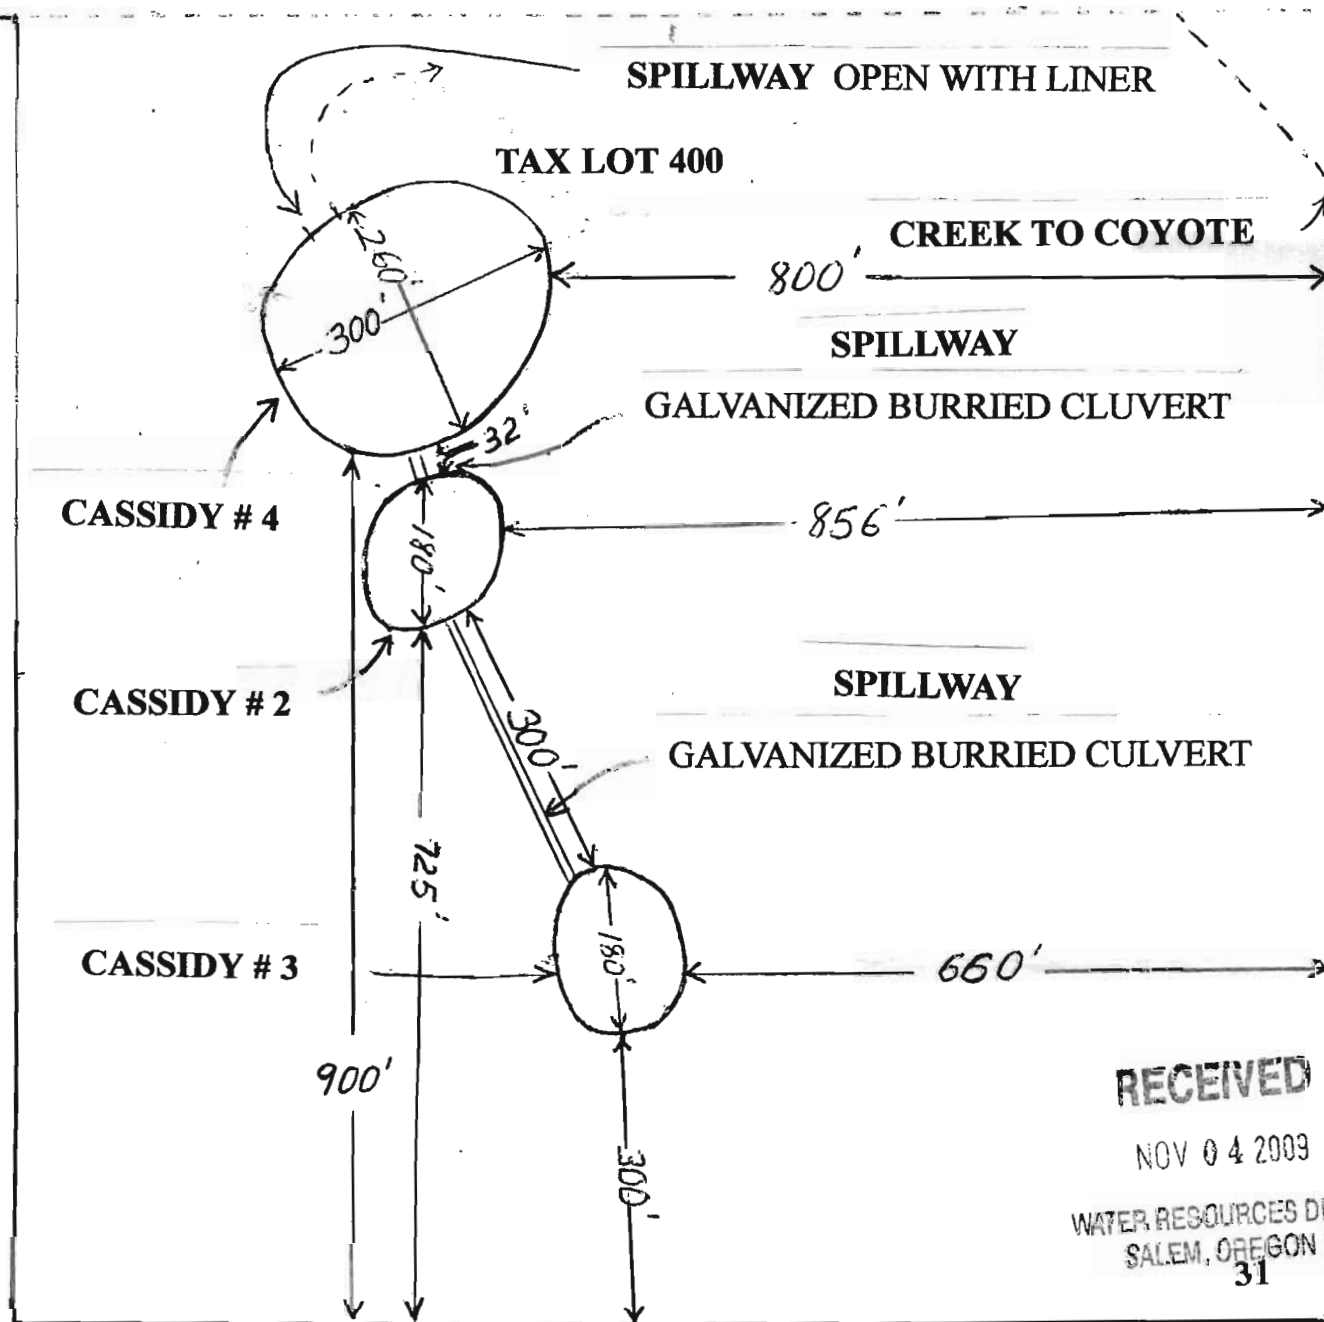


CASSIDY RESRVIORS**T 19S- R 4W-WM SECTION 31
LANE COUNTY OREGON****SCALE 1 INCH = 200 FEET****NORTH****SOUTH EAST CORNER OF
T19 S-R4 W-SECTION 31**

R-87545

Map 19-04-31 Lot 400

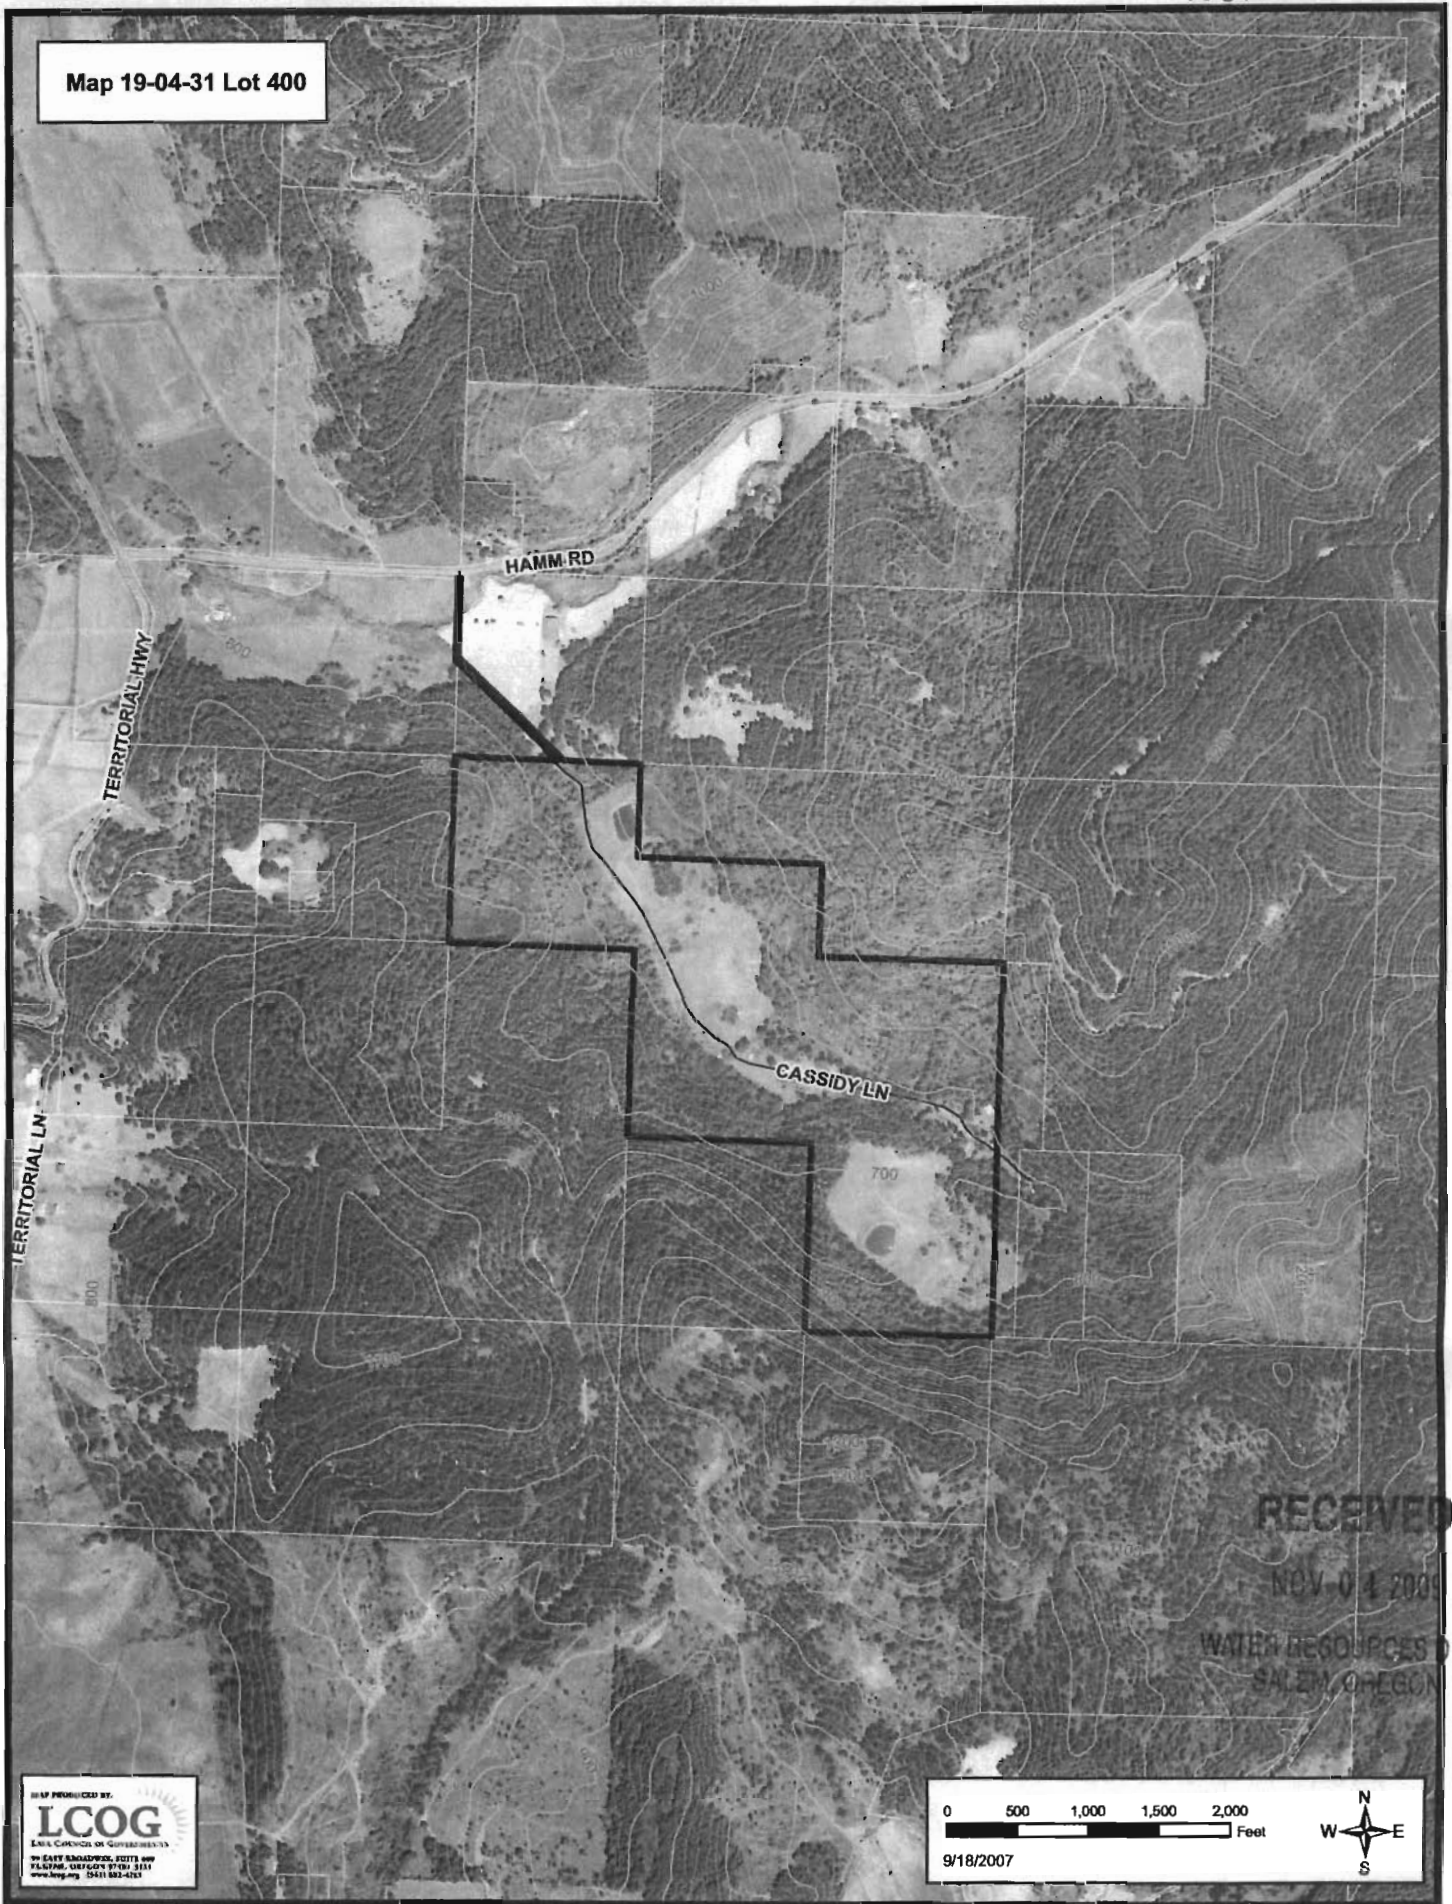

RECEIVED

NOV 04 2009

WATER RESOURCES DEPT
SALEM, OREGON

MAP PROVIDED BY:
LCOG
LANE COUNCIL OF GOVERNMENTS

0 500 1,000 1,500 2,000
Feet

9/18/2007



The information on this map was derived from digital databases on Lane Council of Governments' regional geographic information system. Care was taken in the creation of this map, but it is provided "as is". LCOG cannot accept any responsibility for errors, omissions, or positional accuracy in the digital data or the underlying records. Current designations (e.g., zoning) for specific parcels should be confirmed with the appropriate jurisdictions. There are no warranties, expressed or implied, accompanying this product. However, notification of any errors will be appreciated.