


Tax Lot 300  
SEC.19 T.30S. R.5W. W.M.  
DOUGLAS COUNTY  
Scale 1" = 1000'

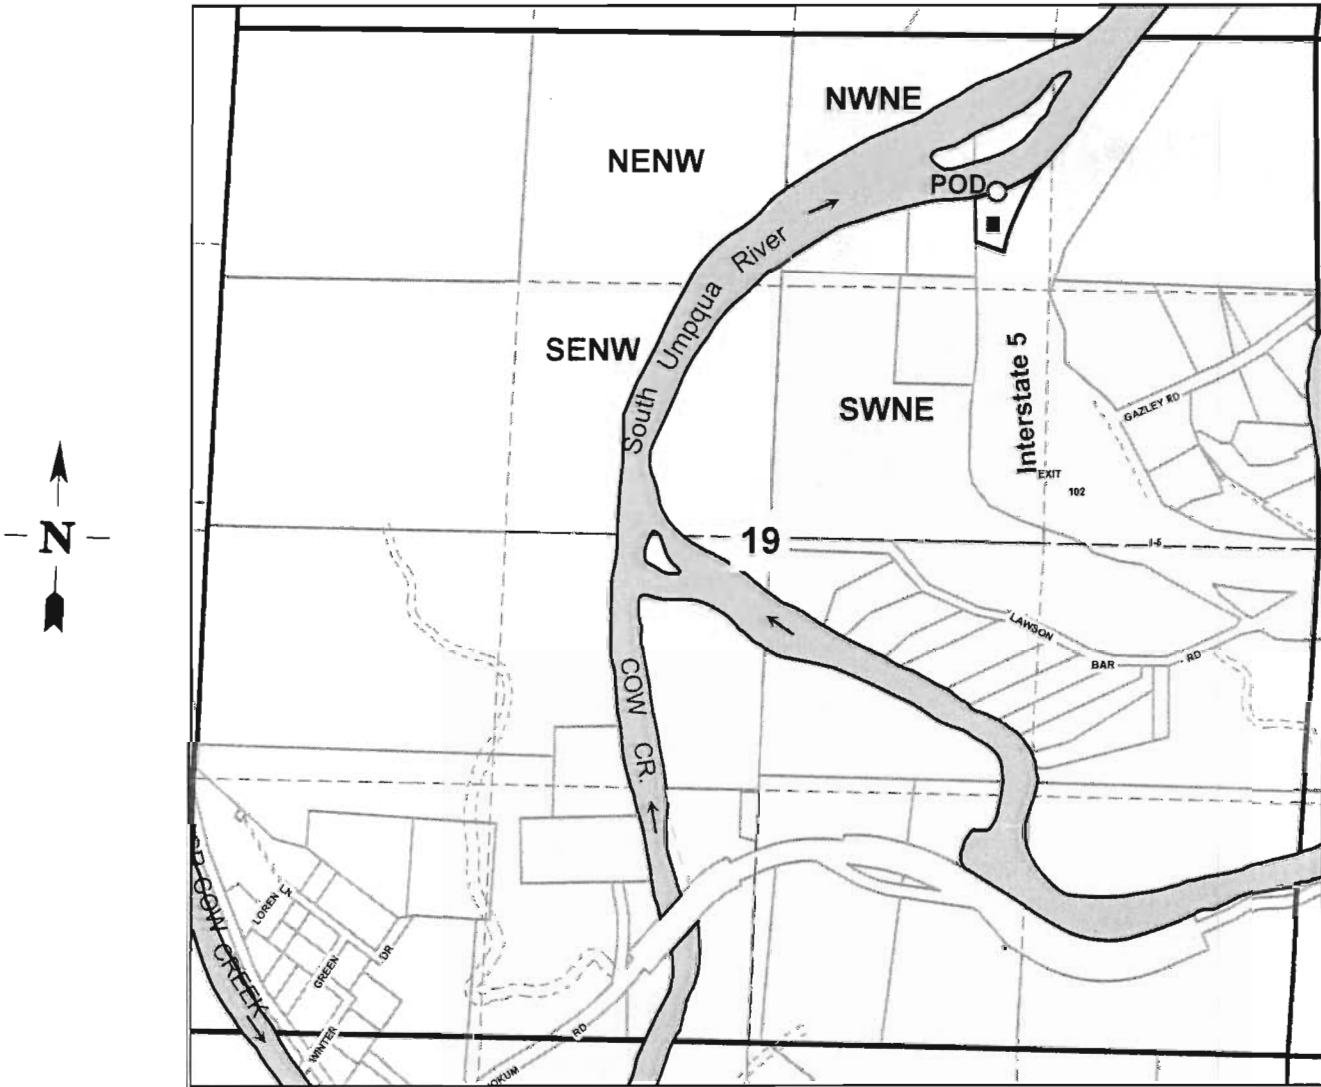

POD: 811 ft. S. 1623 ft. W. from the NE corner of Sec. 19

**RECEIVED**  
NOV 25 2009  
WATER RESOURCES DEPT  
SALEM, OREGON