

SUPPLEMENTAL
COPY

Section 30

Township 25-S


Range 31-E

G-17208

County of Harney

State of OR

NORTH

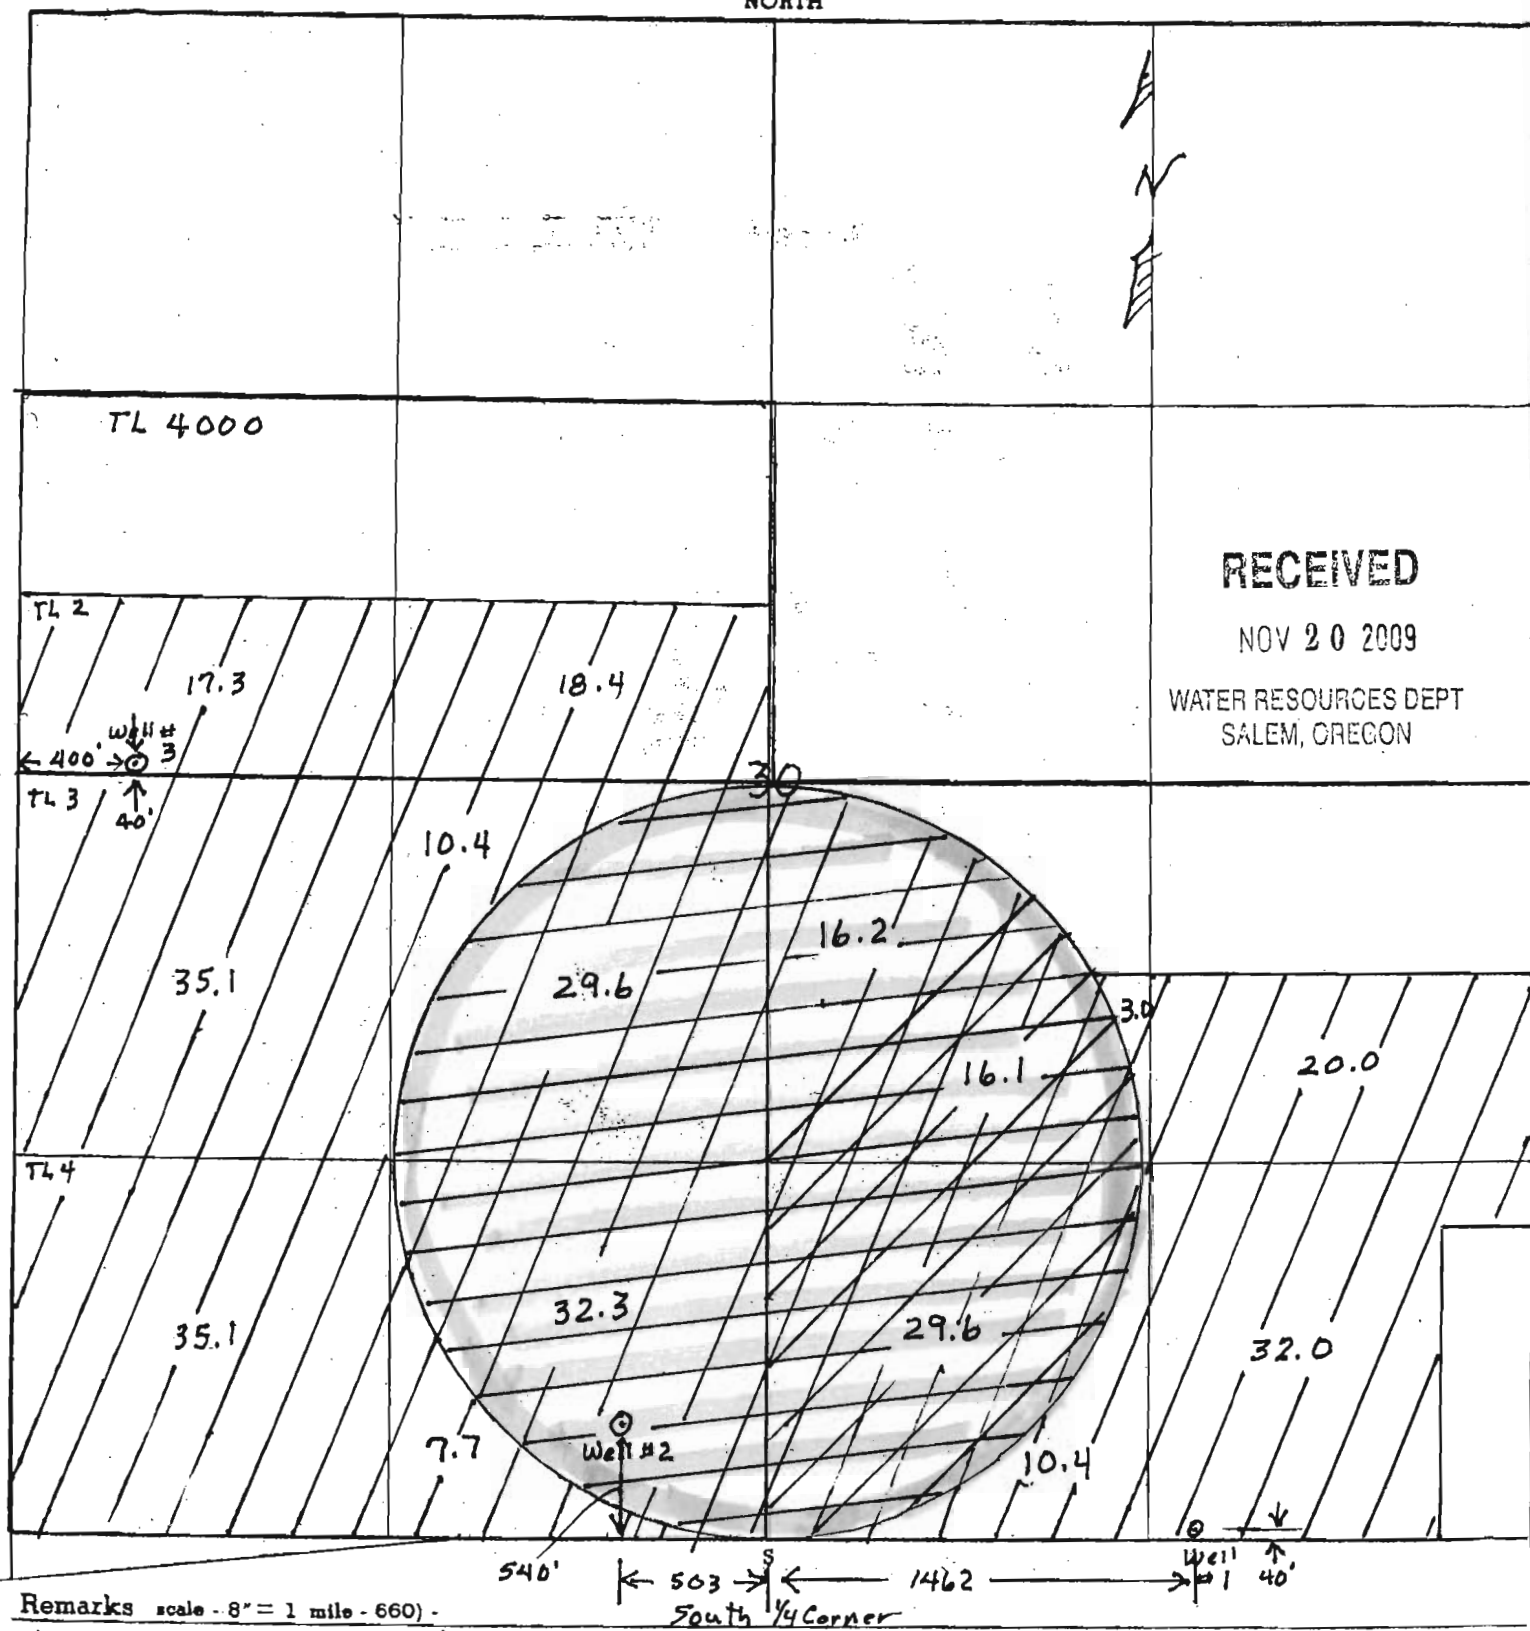

Well #1 is Supplement To Well #2

Well #2 is Supplement To Well #1

Well #3 is Supplement To Wells #1 & #2

Section 30


Township 25-S

Range 31-E

County of Harney

State of OR

NORTH

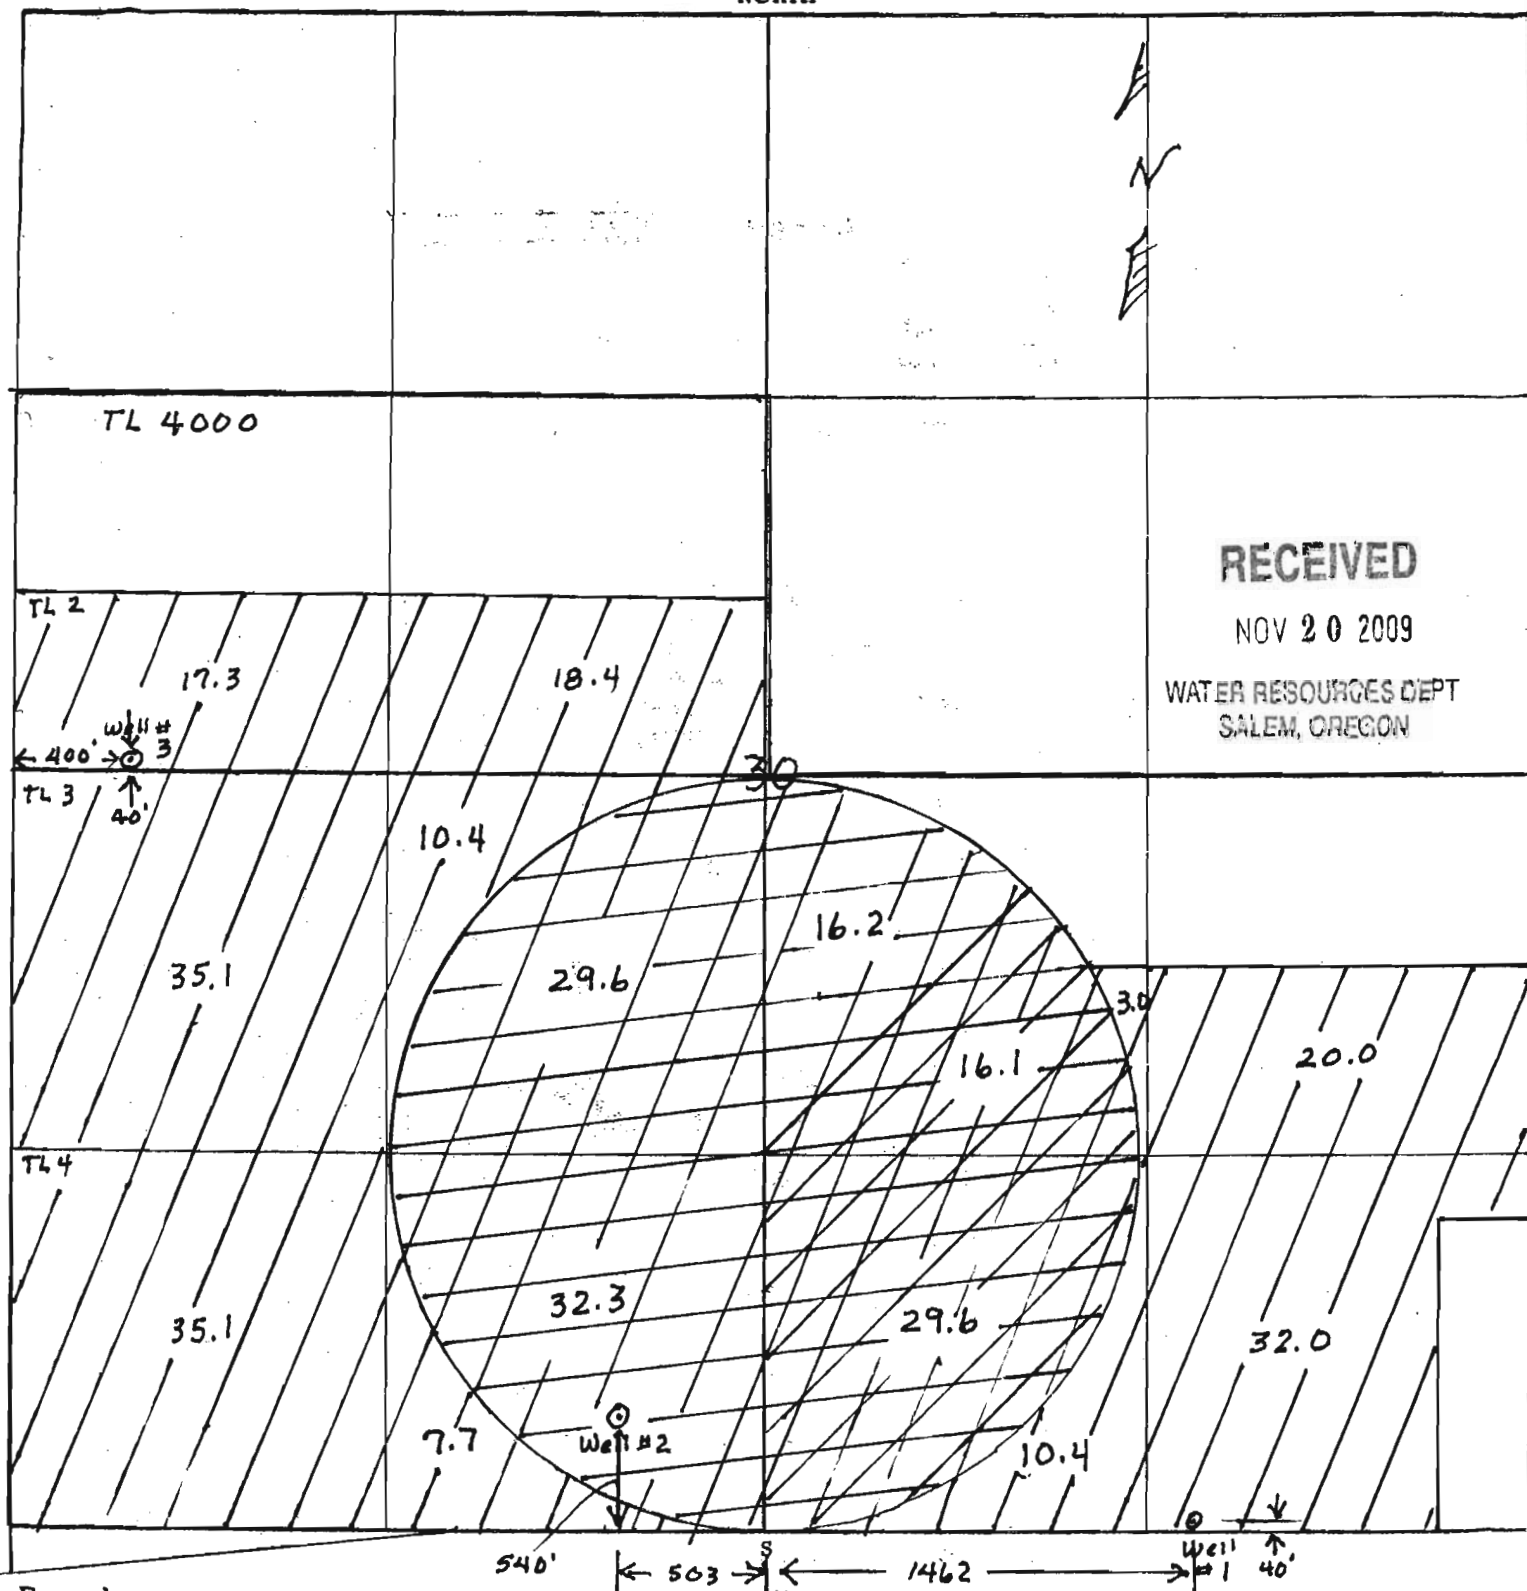

RECEIVED

NOV 20 2009

WATER RESOURCES DEPT
SALEM, OREGON

Remarks scale - 8" = 1 mile - 660' -

Well #1 is Supplement To well #2

Well #2 is Supplement To well #1


Well #3 is Supplement To wells #1 & #2

RECEIVED

JAN 21 1999

WATER RESOURCES DEPT.
SALEM, OREGON

T25 S, R 31 E, WM

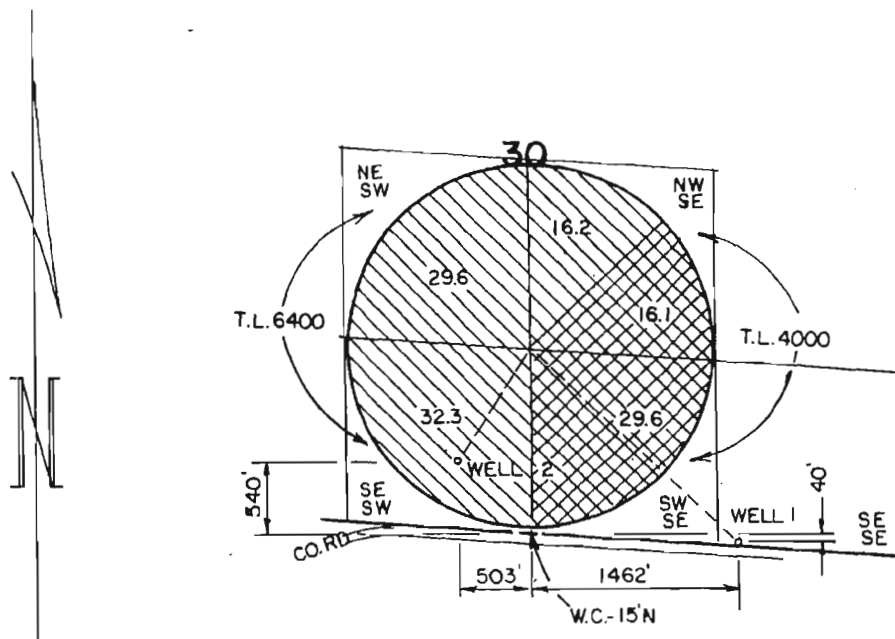

WELL 1


WELL 2

THE PURPOSE OF THIS MAP IS TO IDENTIFY THE LOCATION OF THE WATER RIGHT. IT IS NOT INTENDED TO PROVIDE INFORMATION RELATIVE TO THE LOCATION OF PROPERTY OWNERSHIP.

Application No 614924

Permit No. G-13773

MIKE STILLS

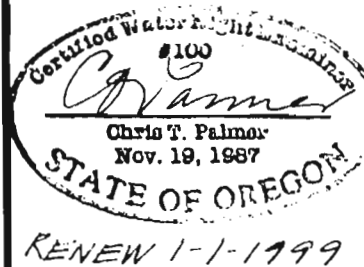WATER RIGHT APPLICATION MAP

Scale: 4" = 1 MILE

Date: 8-25-98

Job: 1677-98

Dgn:

Dwn: CHRIS

Ckd:

M. A. PALMER & SONS, INC.
ENGINEERING & SURVEYING
254 N. Alder - Box 61
Burns, Oregon 97720

Sht. No.

of 1

CA-17280

PRIMARY
COPY

Section 30

Township 25-S

Range 31-E

County of Harney State of OR


NORTH

TL 4000

RECEIVED

NOV 20 2009

WATER RESOURCES DEPT
SALEM, OREGON

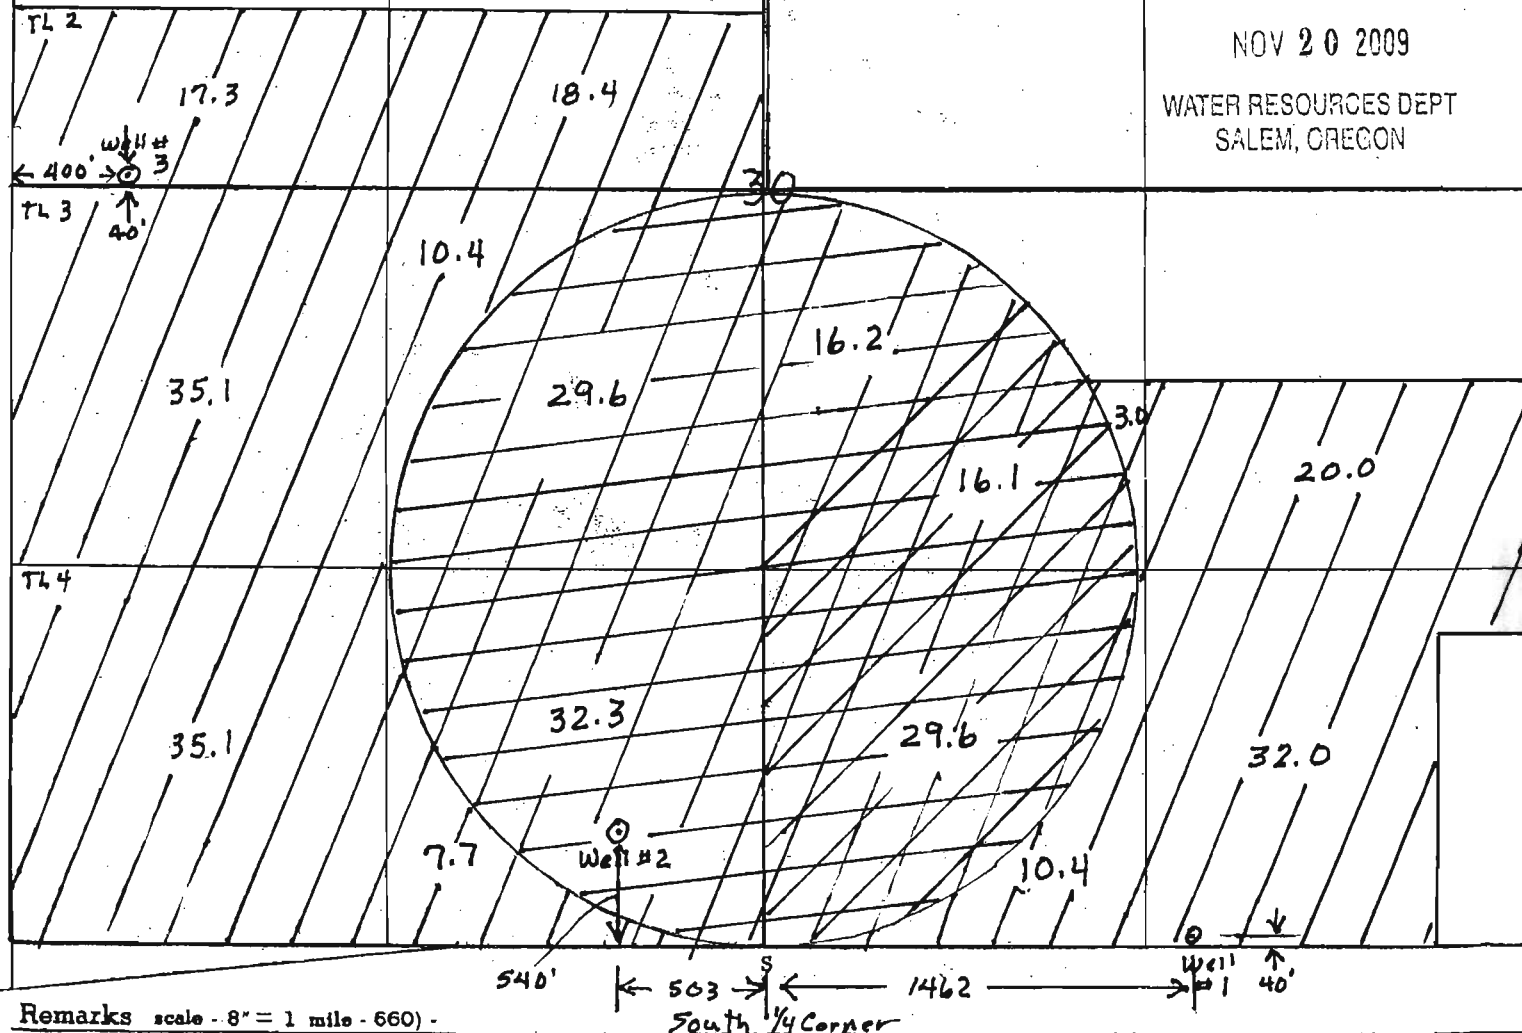

Remarks scale - 8" = 1 mile - 660) -

South $\frac{1}{4}$ Corner

Well #1 is suplemt To well #2

well #2 is supplement to well #1

Well #3 is Supplement To wells #1 & #2