

THIS MAP WAS PREPARED FOR ASSESSMENT PURPOSE ONLY


SW1/4 SEC. 25 T.24S. R.11W. W.M.
COOS COUNTY

CORRECTED ADJUSTED
APPX SCALE

24 11 25C
& INDEX

CANCELLED
601

1" = 400 FEET

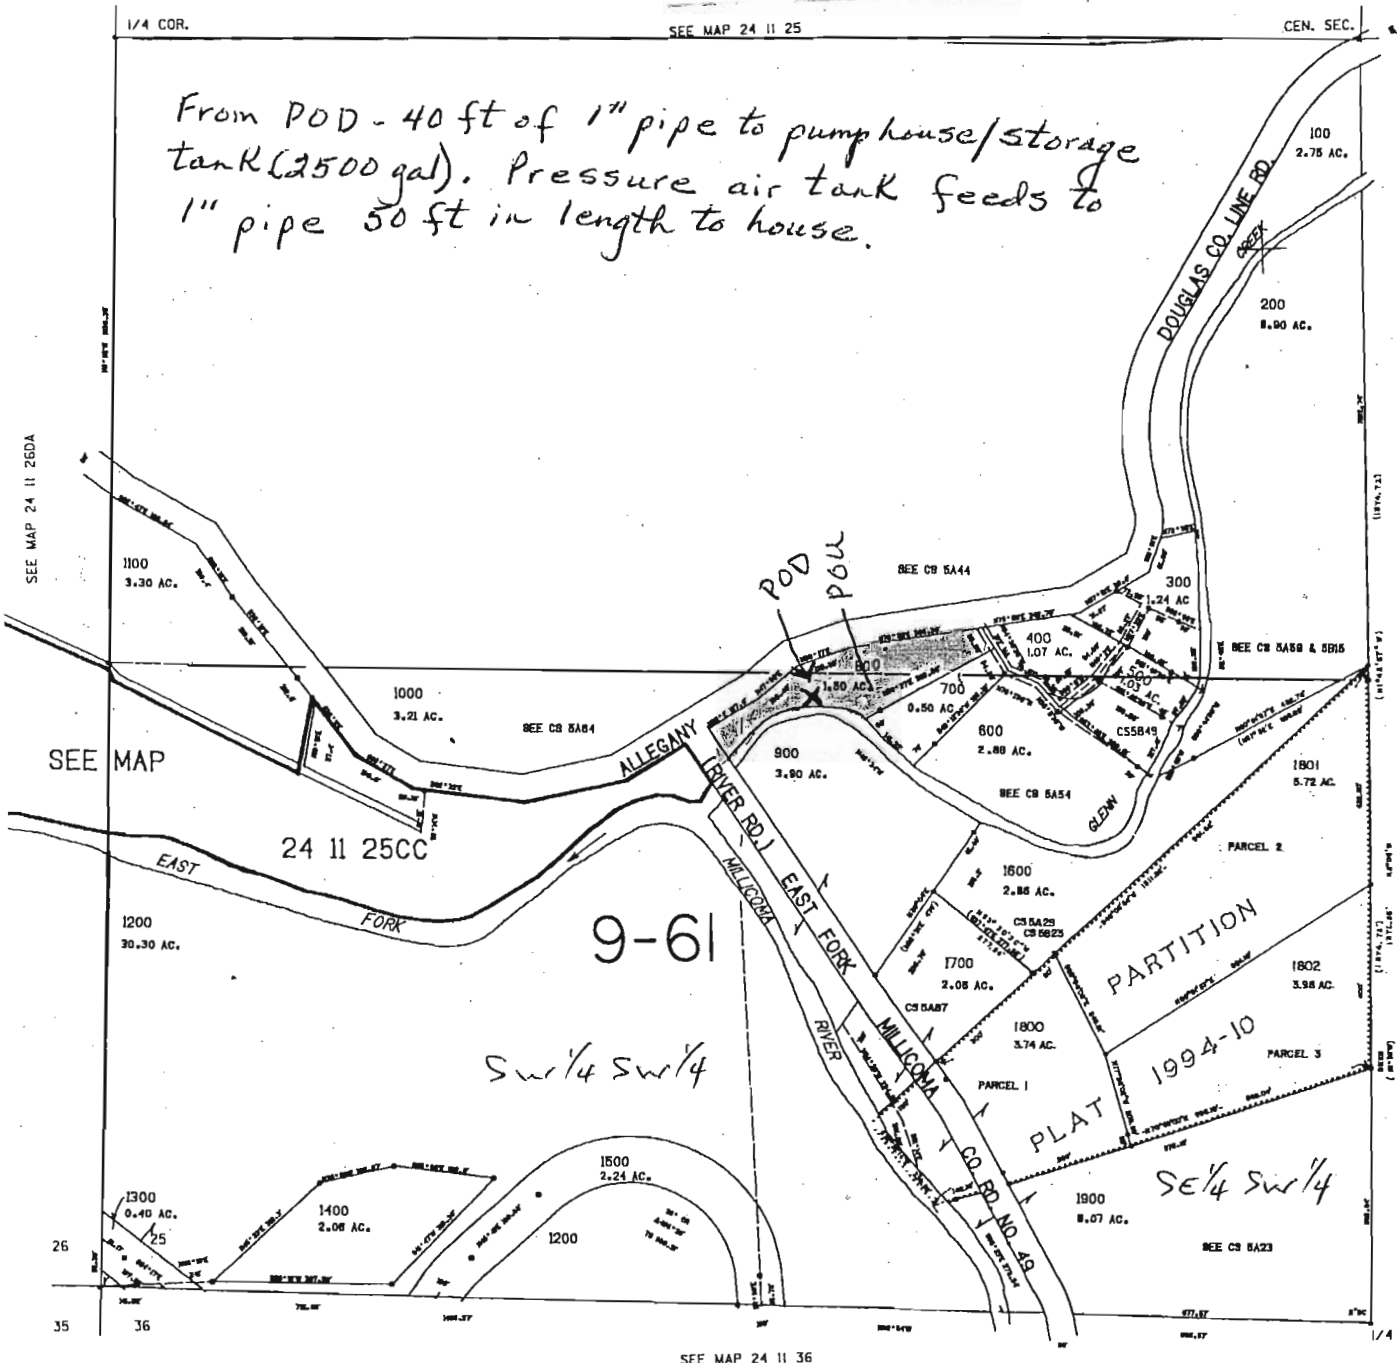

From POD - 40 ft of 1" pipe to pump house/storage tank (2500 gal). Pressure air tank feeds to 1" pipe 50 ft in length to house.

RECEIVED

Tax Lot # 800

POD LOCATED FROM SW CORNER
SECTION 25

1475 ft EAST
1270 ft NORTH

8-2-2004
24 11 25C

Jerry Sauter

From: LuAnn [ludeanabney39@peoplepc.com]
Sent: Monday, December 07, 2009 11:47 AM
To: Jerry Sauter
Subject: Re: Water Right Corrections

As per our phone conversation and email today, Dean & I (Roberta) have reviewed the additions to the map and we concur and approve of the additions made. Thank you for your assistance.

-----Original Message-----

From: Jerry Sauter
Sent: Dec 7, 2009 12:02 PM
To: "LuDeanAbney39@peoplepc.com"
Cc: Herb Mosgar
Subject: Water Right Corrections

Dean and Roberta Abney:

Attached are map corrections that Herb Mosgar has spoken to you about. If you agree with the corrections, please let Herb know and send him an e-mail authorizing the changes. Herb may be reached at Herbert.L.Mosgar@wrd.state.or.us Thank you for your assistance.

Sincerely,
Jerry Sauter

PeoplePC Online
A better way to Internet
<http://www.peoplepc.com>

RECEIVED
DEC 07 2009
WATER RESOURCES DEPT
SALEM, OREGON

THIS MAP WAS PREPARED FOR ASSESSMENT PURPOSE ONLY

SW1/4 SEC. 25 T.24S. R.11W. W.M.
COOS COUNTY

24 11 25C
& INDEX

1" = 200'


CANCELLED
601

1/4 COR.

SEE MAP 24 11 25

CEN. SEC.

From POD - 40 ft of 1" p.p.e to pump house/storage tank (2500 gal). Pressure air tank feeds to 1" pipe 50 ft in length to house.

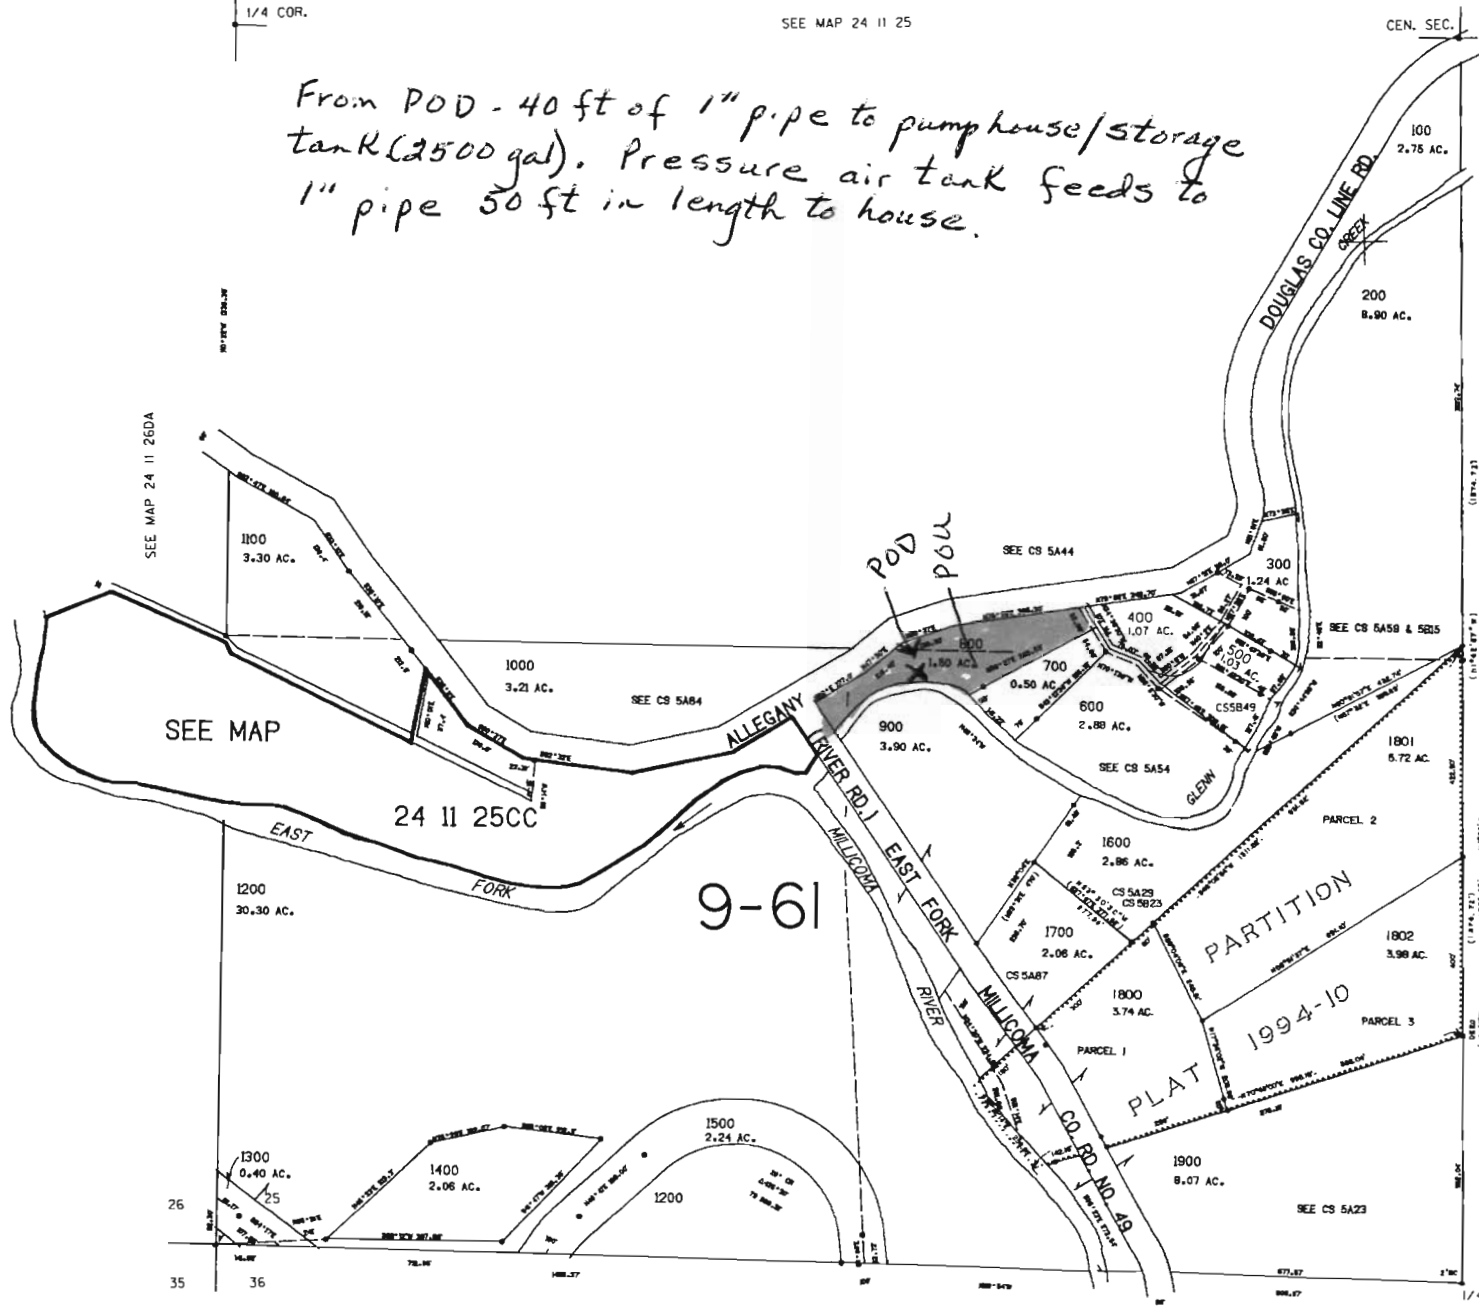

Tax Lot # 800

RECEIVED

DEC 04 2009

WATER RESOURCES DEPT
SALEM, OREGON

SEE MAP 24 11 25

9-61

SEE MAP 24 11 36

1/4 COR. 8-2-2004

24 11 25C
& INDEX