

Locate a place on the map ▶ Use Advanced Map ▶ Help ▶ Links ▶

Zoom In

Zoom Out

Pan

Full Extent


RECEIVED

NOV 30 2009

WATER RESOURCES DEPT
SALEM, OREGON

Map navigation controls: Home, Previous, Next, Full Screen, etc.

- ☒ OWRD Data
 - ☒ Rule Boundaries
 - ☒ Political Boundaries
 - ☒ Water Availability
 - ☒ Water Rights
 - ☒ Surface water
- ☒ Base Data
 - ☒ Political Boundaries
 - ☒ PLS
 - ☒ Roads
 - ☒ Surface water
 - ☒ Topography
 - ☒ Hillshade (state)
 - ☒ Hillshade (region)
- ☒ Imagery
 - ☐ Aerial Photography
 - ☒ USGSquads

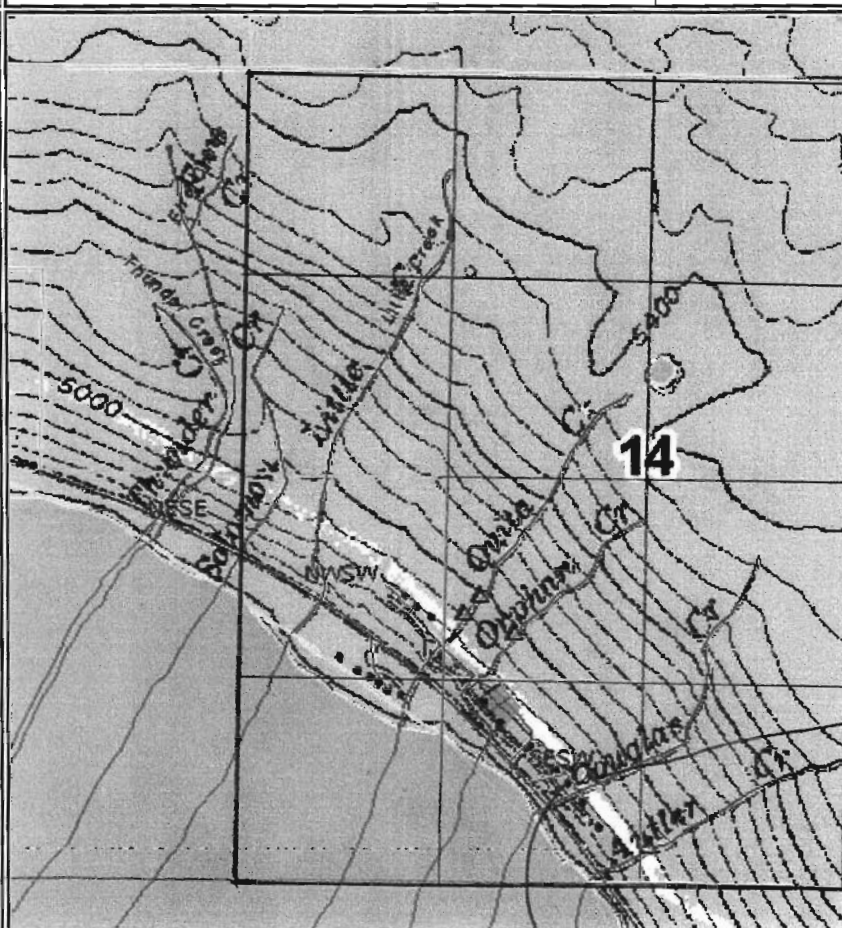

Spring is located :
600 ft N of the S border
of quarter quarter SE SW
section 14, T23S, R6E,
and
508 ft W of the E border of
quarter quarter SE SW
section 14, T23S, R6E.

Spring Location

cabin location

Fischer Cabin

John Fischer
2197 Jeppesen Acres Rd
Eugene OR 97401
jfisher51@gmail.com
541-683-5866

T23S R6E Section 14

RECEIVED

DEC 08 2009

WATER RESOURCES DEPT
SALEM, OREGON

S-87550

RECEIVED

DEC 08 2009

WATER RESOURCES DEPT
SALEM, OREGON

WORK
COPY

RECEIVED

NOV 30 2009

WATER RESOURCES DEPT
SALEM, OREGON


Zoom In

Zoom Out

Pan

Full Extent

ll

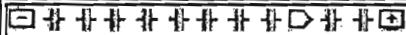

☒ OWRD Data


- ☒ Rule Boundaries
- ☒ Political Boundaries
- ☒ Water Availability
- ☒ Water Rights
- ☒ Surface water

☒ Base Data

- ☒ Political Boundaries
- ☒ PLS
- ☒ Roads
- ☒ Surface water
- ☒ Topography
 - ☒ Hillshade (state)
 - ☒ Hillshade (region)

☒ Imagery

- ☐ Aerial Photography
- ☒ USGSquads

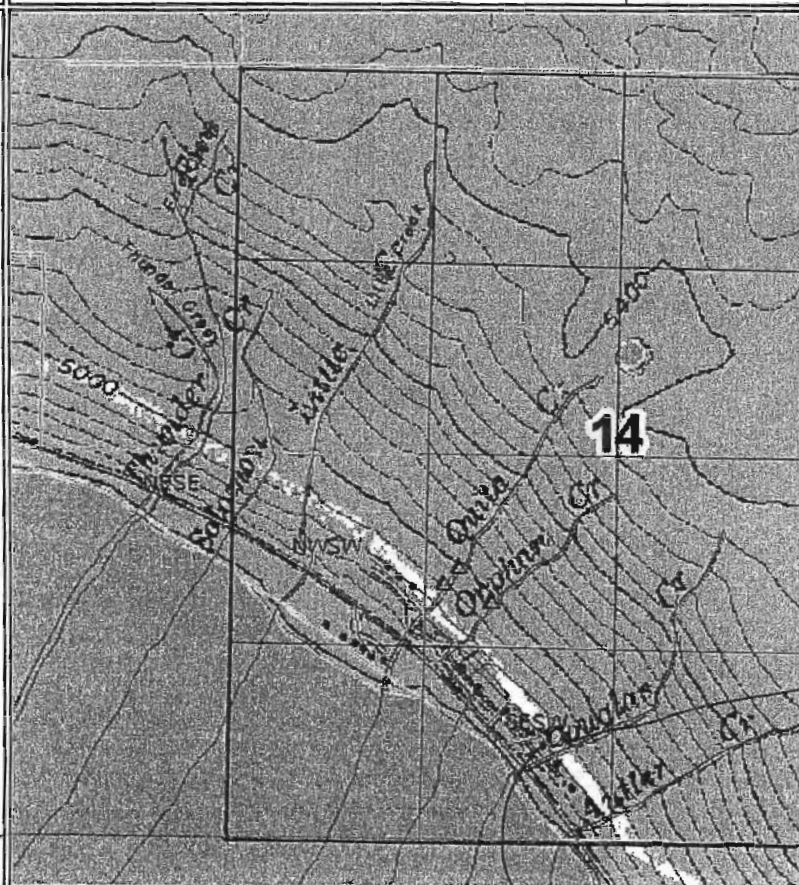

Spring is located:
600 ft N of the S border
of quarter quarter SE SW
section 14, T23S, R6E,
and
508 ft W of the E border of
quarter quarter SE SW
section 14, T23S, R6E.

Spring Location

cabin location

fischer Cabin


John fischer
2197 Jeppesen Acres Rd
Eugene OR 97401
jfischer51@gmail.com
541-683-5866

CORRECTED ADJUSTED
APPROX SCALE
1" = 1320 FEET

T23S R6E Section 14

S-87558

- ☒ OWRD Data
 - ☒ Rule Boundaries
 - ☒ Political Boundaries
 - ☒ Water Availability
 - ☒ Water Rights
 - ☒ Surface water
- ☒ Base Data
 - ☒ Political Boundaries
 - ☒ PLS
 - ☒ Roads
 - ☒ Surface water
 - ☒ Topography
 - ☒ Hillshade (state)
 - ☒ Hillshade (region)
- ☒ Imagery
 - ☐ Aerial Photography
 - ☒ USGSquads

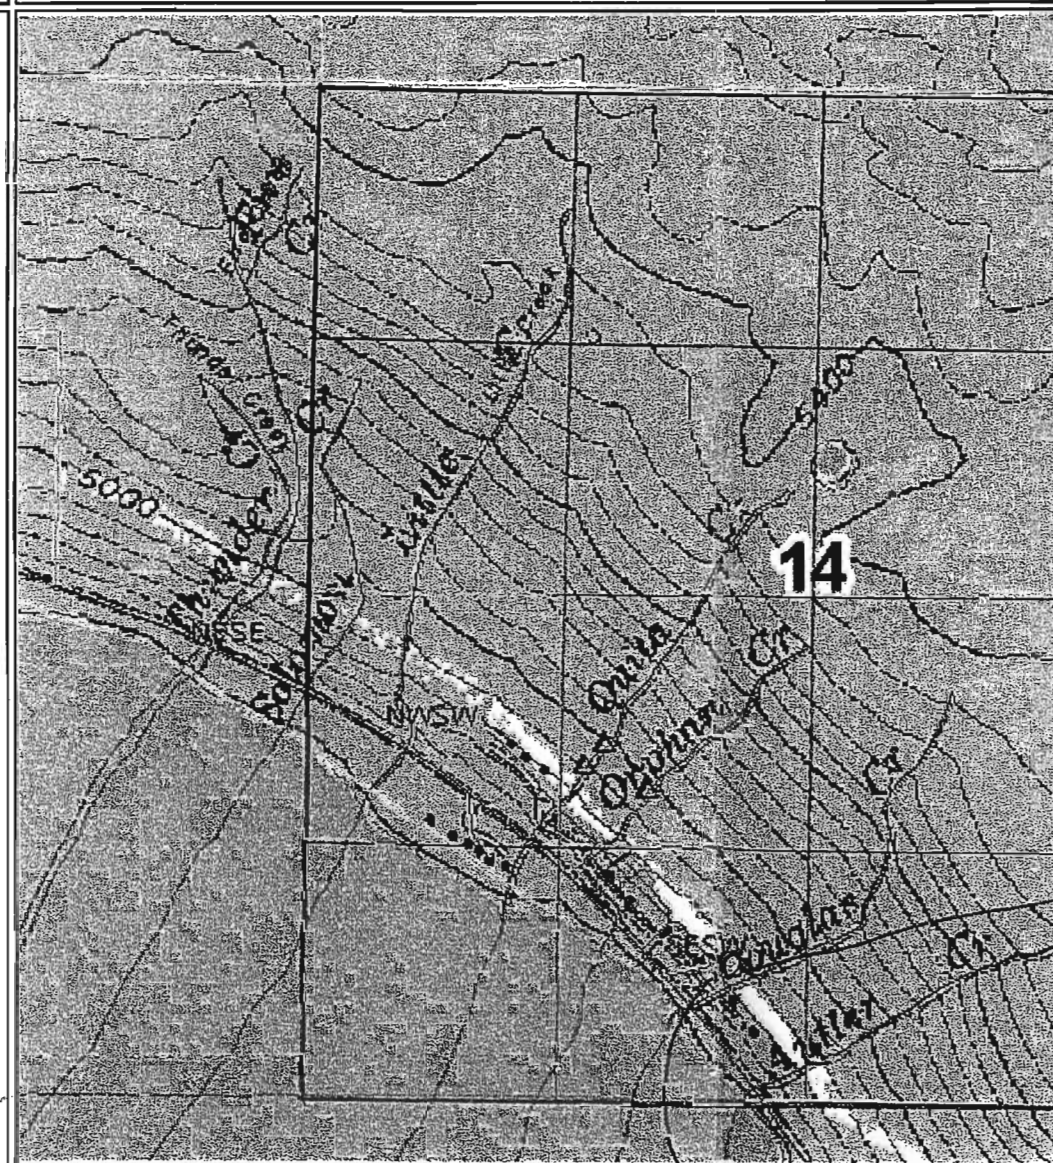

Spring is located:
600 ft N of the S border
of quarter quarter SE SW
section 14, T23S, R6E,
and
508 ft W of the E border of
quarter quarter SE SW
section 14, T23S, R6E.

fischer Cabin
John fischer
2197 Jeppesen Acres Rd
Eugene OR 97401
jfischer51@gmail.com
541-683-5866

CORRECTED ADJUSTED
APPROX SCALE

1" = 1000 FEET

T23S R6E Section 14

cabin location

WORK
COPY

Spring Location

RECEIVED

DEC 08 2009

WATER RESOURCES DEPT
SALEM, OREGON