

RECEIVED

RECEIVED

RECEIVED

NOV 9 1977

MAY 5 1978

JAN 02 2001

Application No. 56845  
Permit No. 44178

WATER RESOURCES DEPT. SALEM, OREGON  
WATER RESOURCES DEPT. SALEM, OREGON  
CENTER OF SEC. 10

MAR 19 1979


WATER RESOURCES DEPT.  
SALEM, OREGON

TP. 26 So. R. 3 W.M.M.

SECTION 1

1" = 200'

THIS MAP PREPARED BY *Sharon M. Blodgett*  
FOR THE WATER RESOURCES DEPARTMENT  
ALL INFORMATION FURNISHED BY THE  
DEPARTMENT

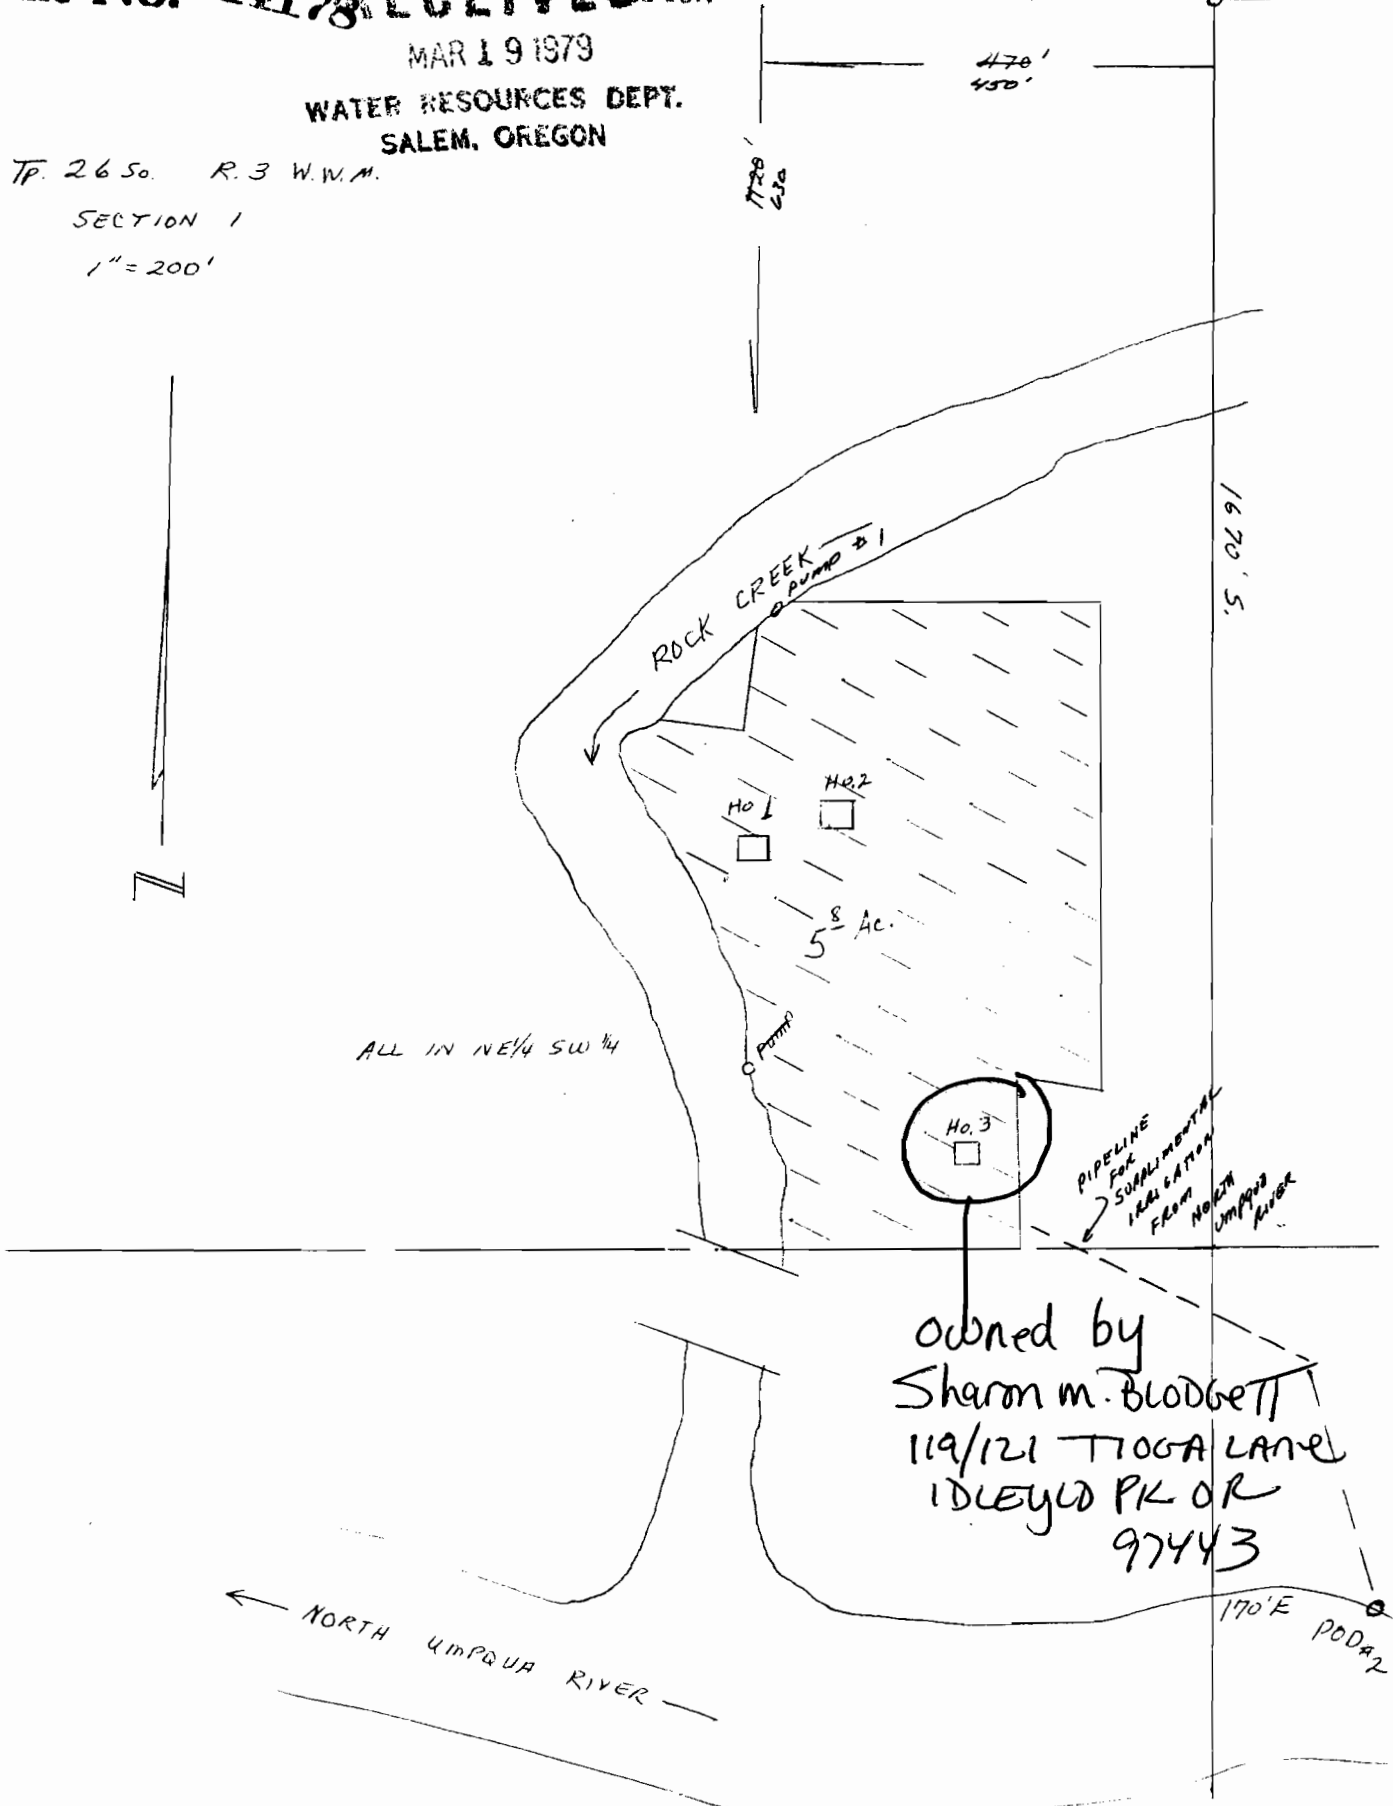

owned by  
Sharon M. Blodgett  
119/121 TIOGA LANE  
IDLEYD PK OR  
97443

← NORTH UMPQUA RIVER →