


SECTION 23 T.2N. R.10E. W.M.
HOOD RIVER COUNTY

1" = 400'

THIS MAP WAS PREPARED FOR
ASSESSMENT PURPOSE ONLY

2N 10 23

- CANCELLED NO.
- 500
- 1200
- 1802
- 2000
- 3701
- 4000
- 4100

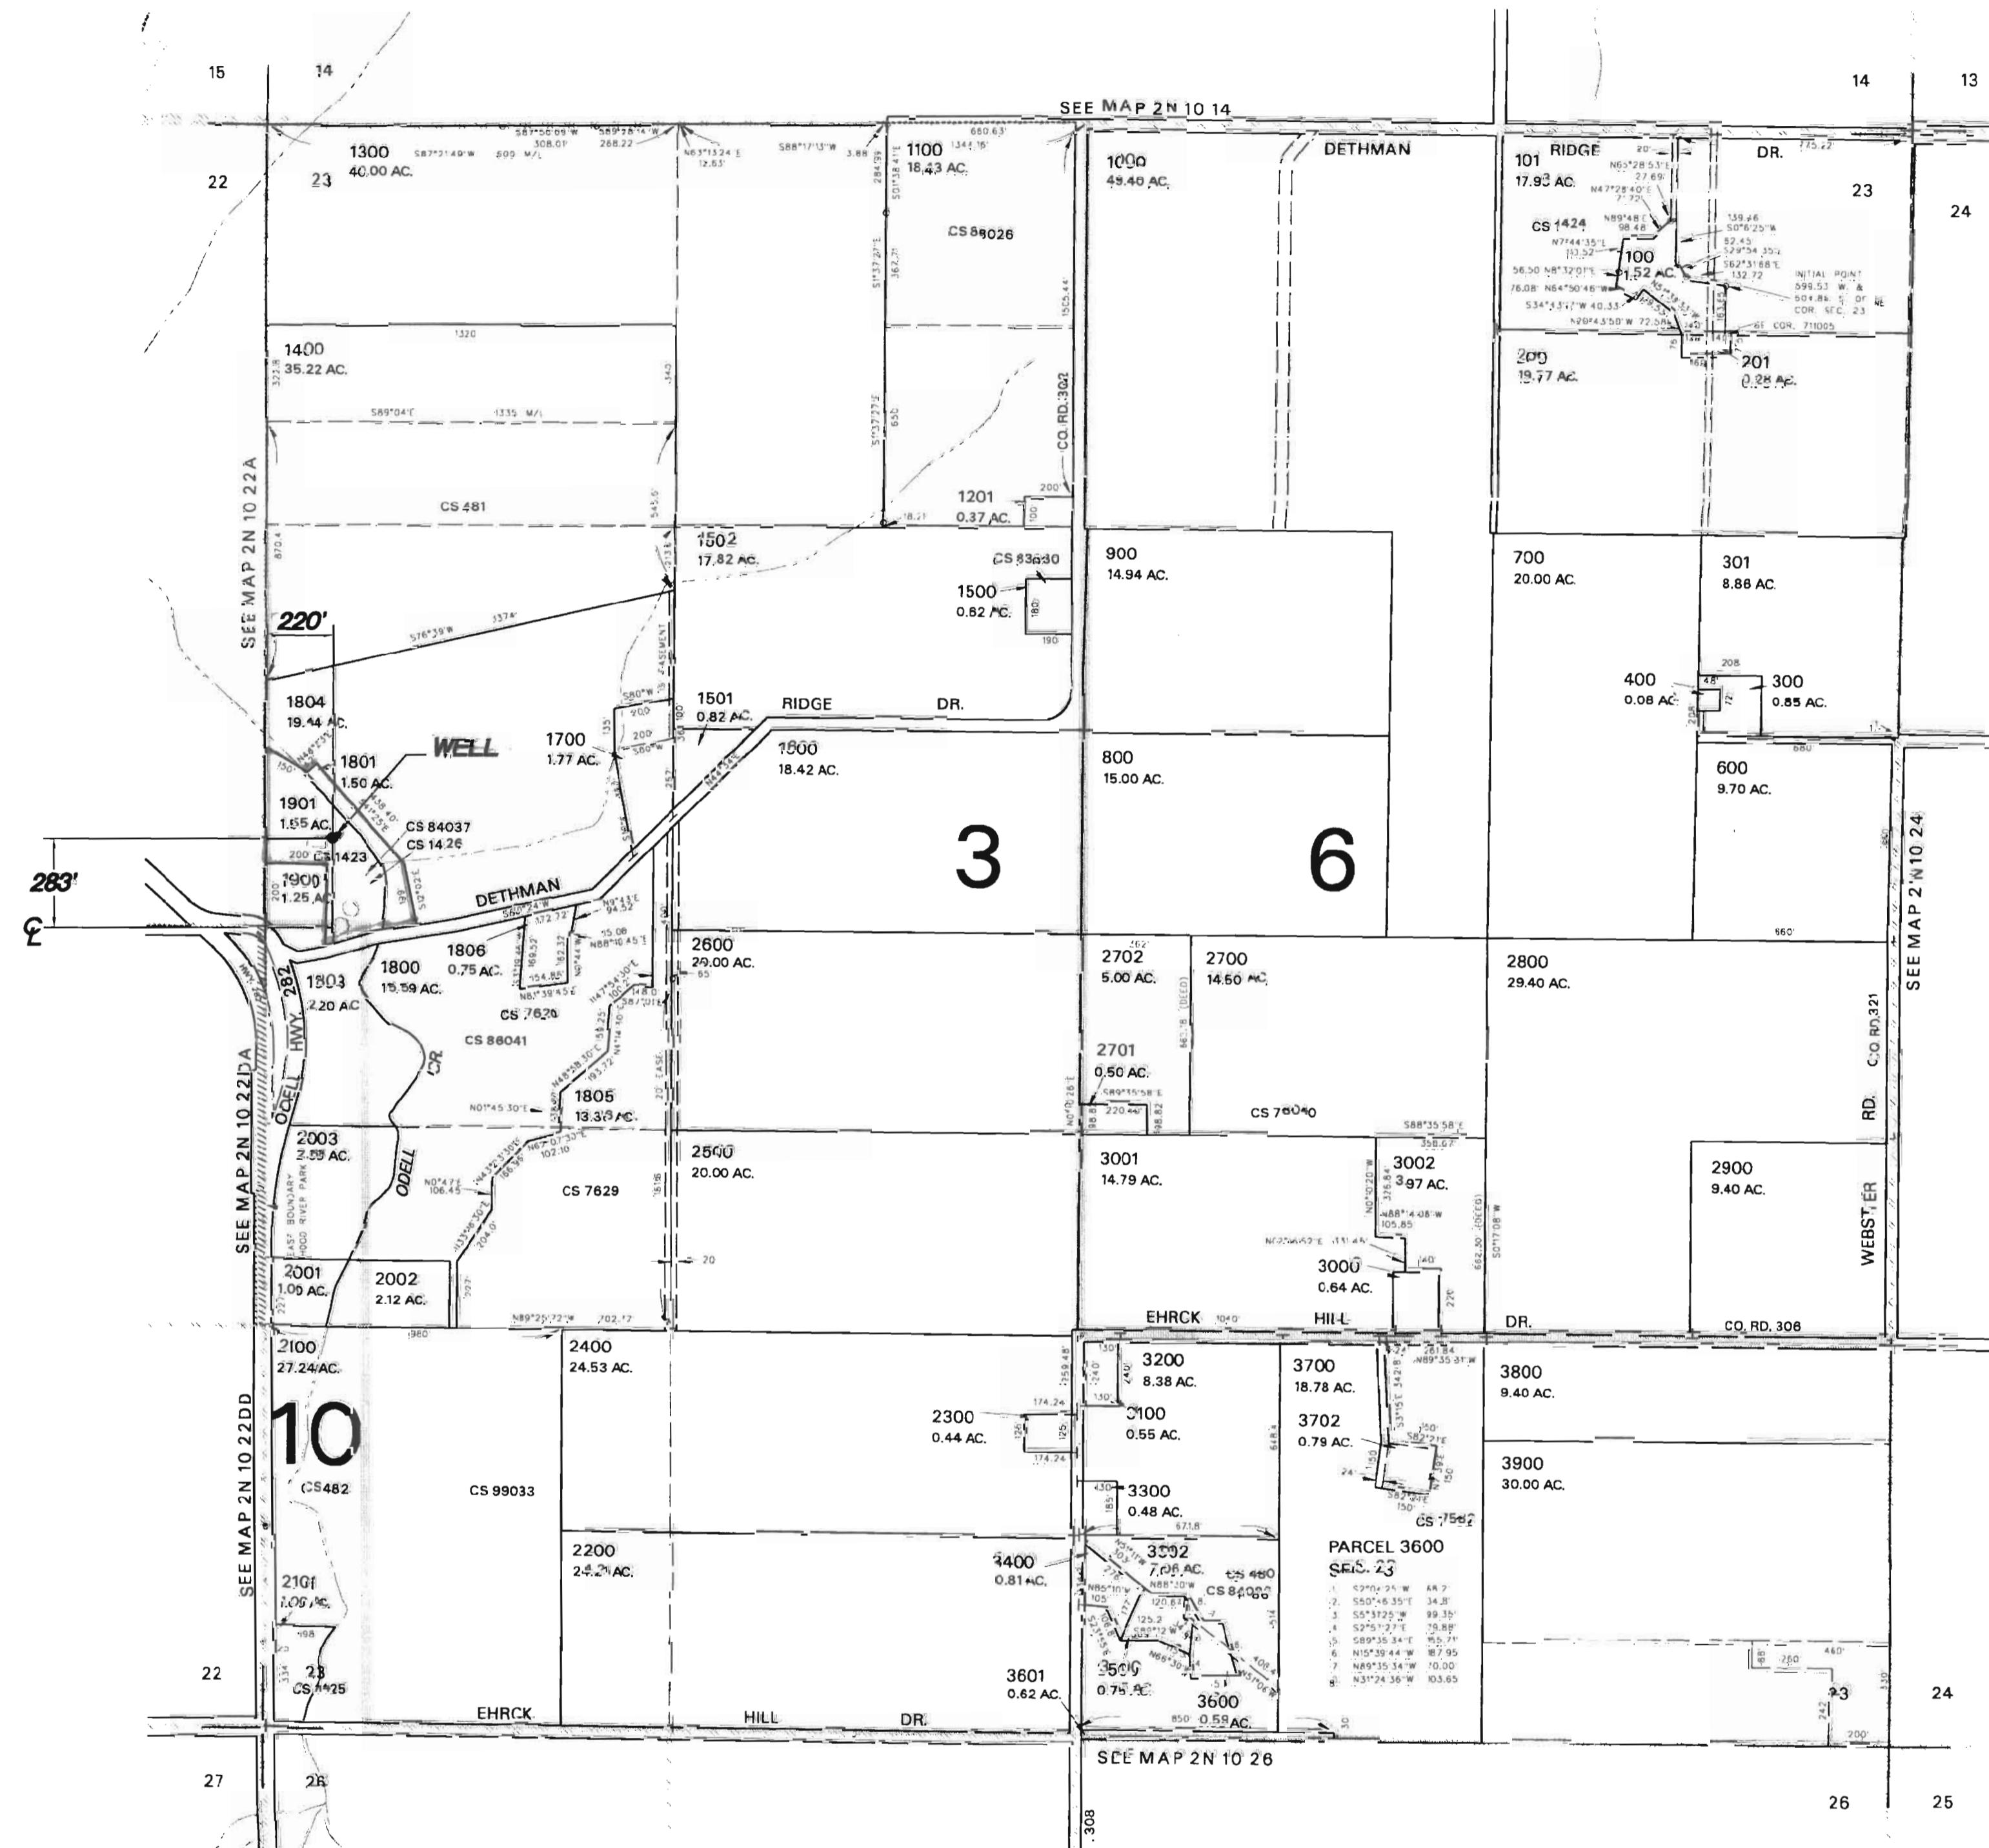

NOTE:
THIS MAP IS NOT INTENDED TO
PROVIDE LEGAL DIMENSIONS OR
LOCATIONS OF PROPERTY
OWNERSHIP LINES.

REVISED: JD
11/19/02

2N 10 23



WELL LOCATION MAP
SCALE: 1" = 400'

SEP 10 2007
WATER RESOURCES DEPT
SALEM OREGON

REV	DESCRIPTION	REVISED BY	DATE

CURRAN-MCLEOD, INC.
CONSULTING ENGINEERS

6655 SW HAMPTON ST. SUITE 210
PORTLAND, OREGON 97223
PHONE (503) 584-3478

OCELL SANITARY DISTRICT

WELL LOCATION MAP
WASTEWATER TREATMENT FACILITY IMPROVEMENTS
HOOD RIVER COUNTY, OREGON

JULY 2007
1436