


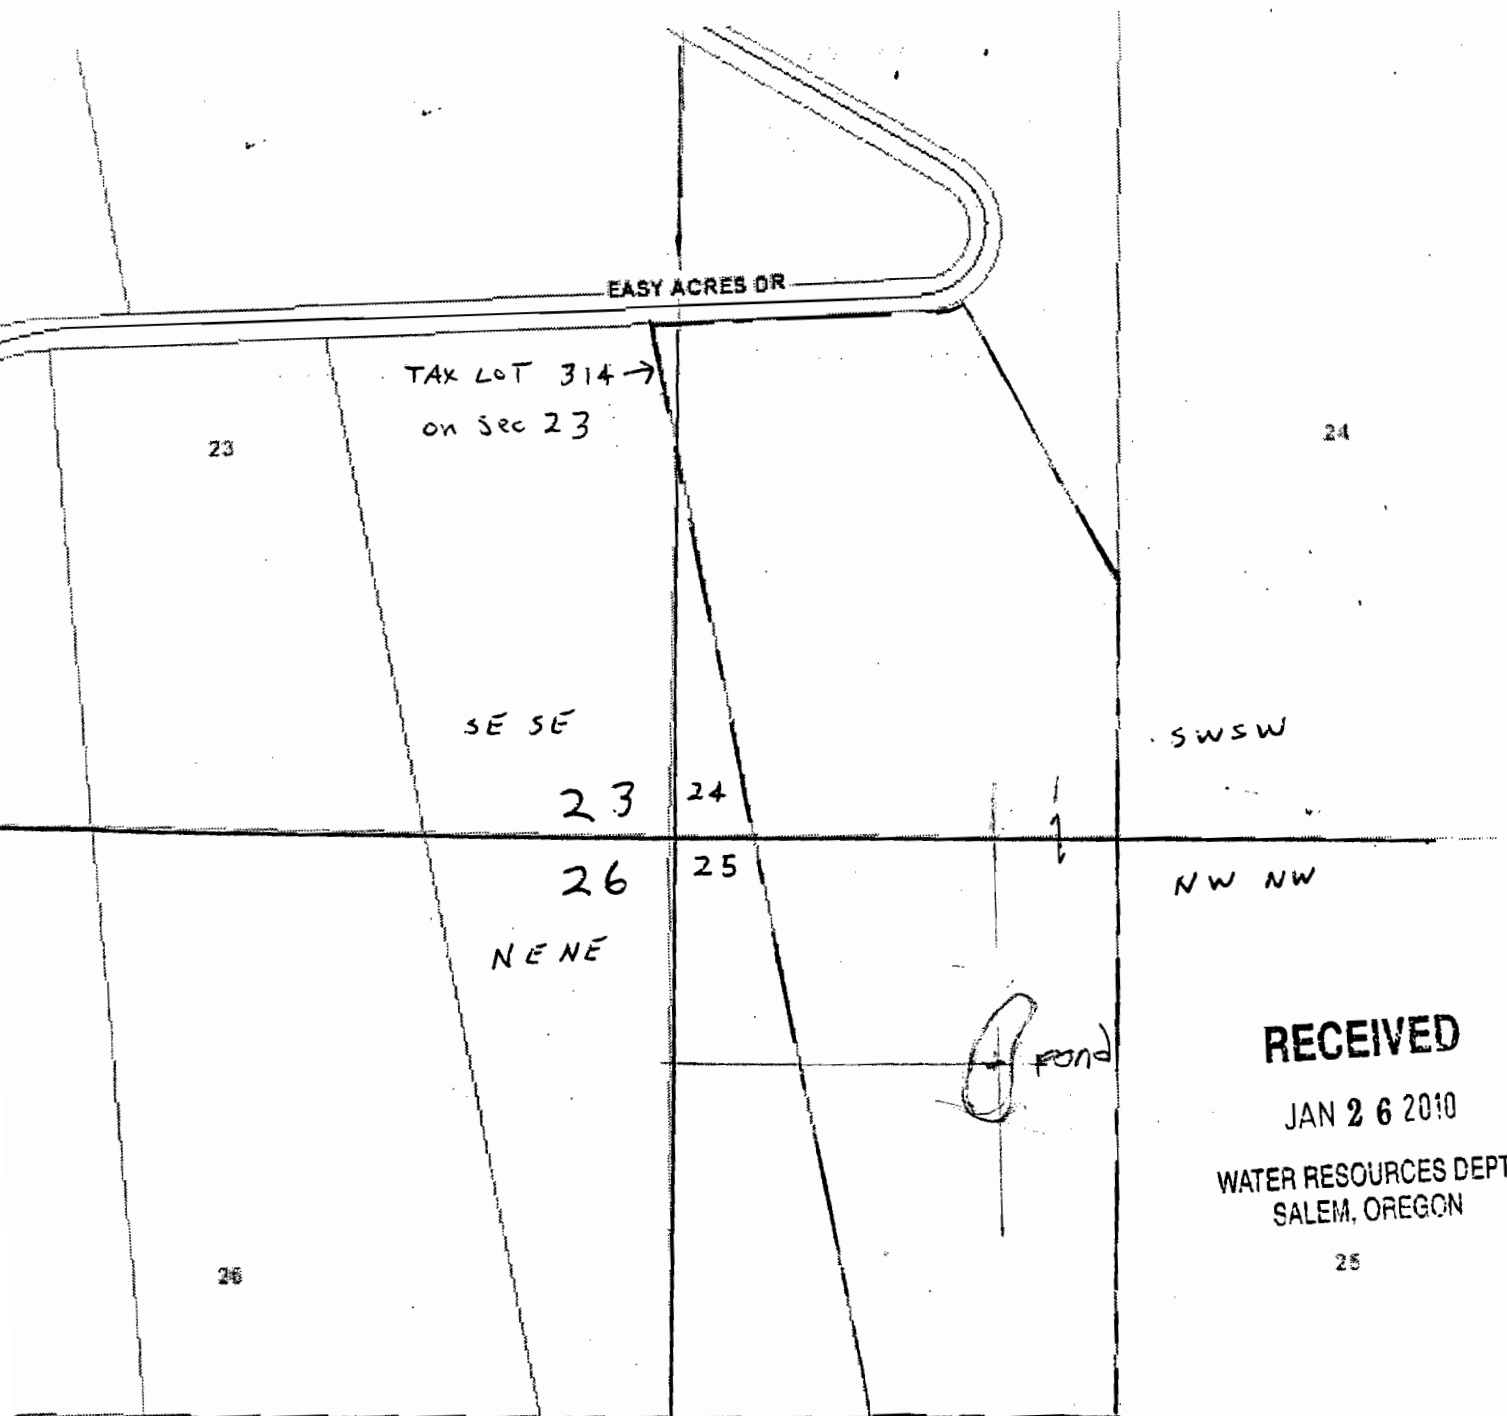

Tax Map lot 19052300 00314

N
1" = 300'


T 19 S R 5 W Sec 25

NW 1/4, NW 1/4

350 ft south and

500 ft East from

SE corner Sec 23

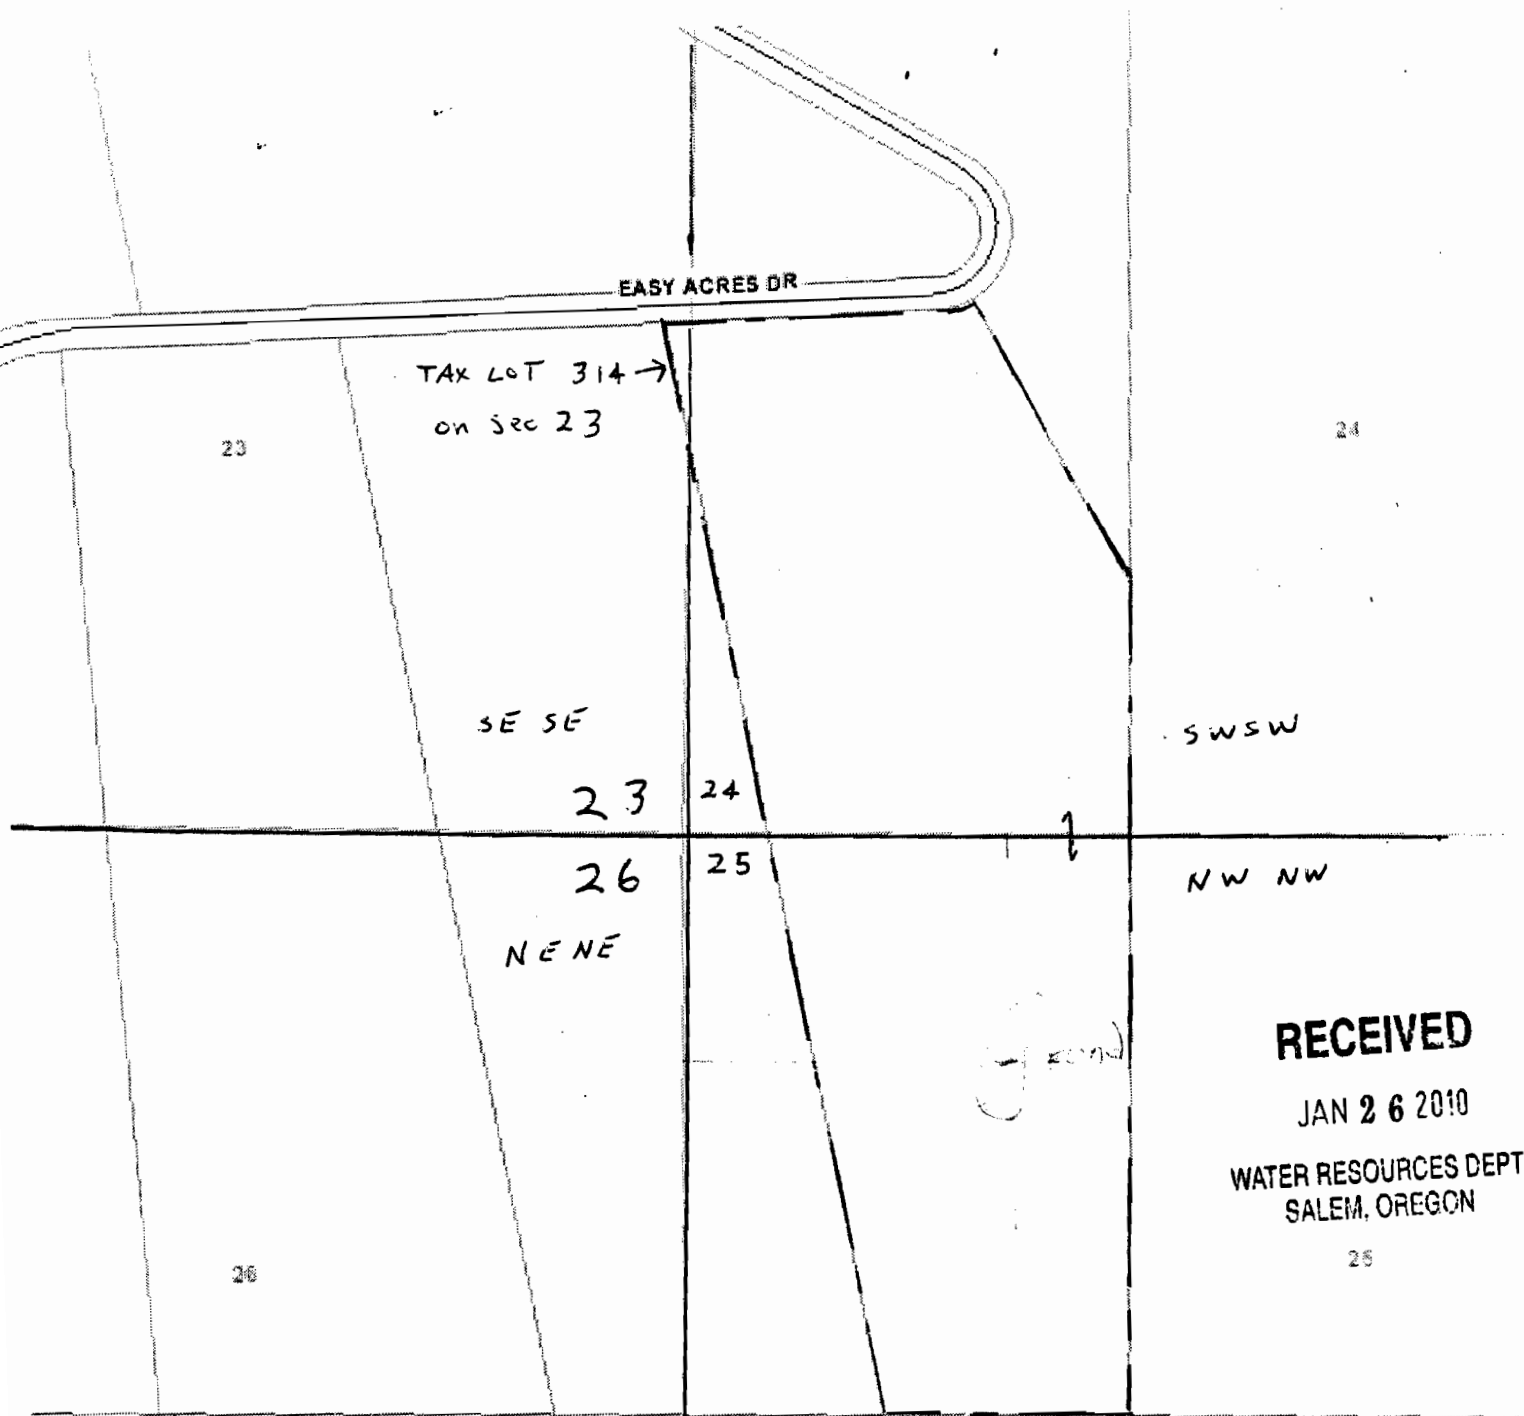

Tax Map lot 19052300 00314

T 19 S R 5 W Sec 25
NW 1/4, NW 1/4
350 ft south and
500 ft East from
SE corner Sec 23