


SEC.31 T.30S. R.5W. W.M.
DOUGLAS COUNTY
Scale 1" = 1000'

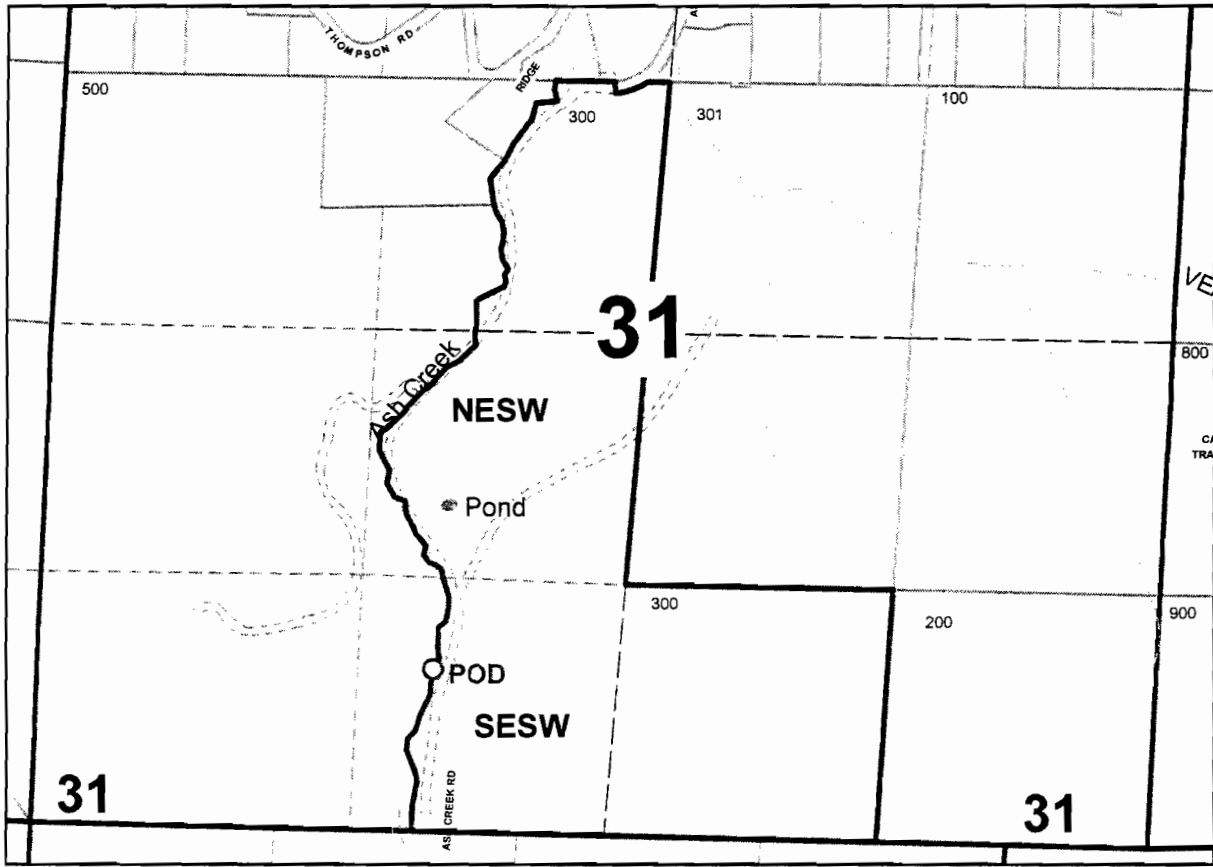

Pond is 2200 ft. S. and 2300 ft. W. from the NE 1/16 corner of section 31.
POD is 3155 ft. S. and 2333 ft. W. from the NE 1/16 corner of section 31.

RECEIVED

JAN 26 2010

WATER RESOURCES DEPT
SALEM, OREGON