

NA

CORRECTED ADJUSTED
APPROX SCALE
1" = 13.20 FEET


287578

T. 7 S., R. 46 E., W.M.

RECEIVED

JUL - 1 1993

WATER RESOURCES DEPT.
SALEM, OREGON

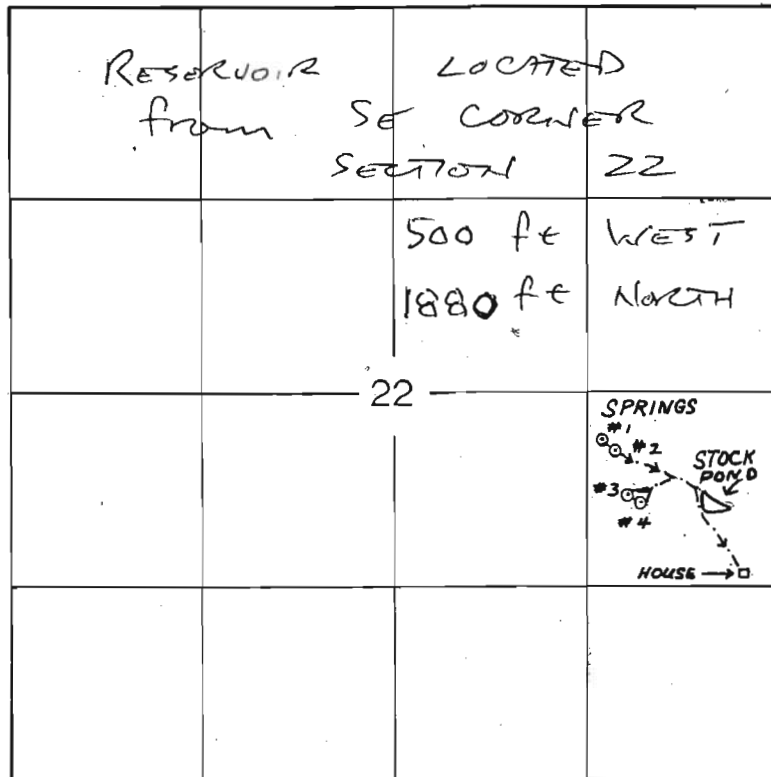

1" = 1320'

POD - 1 - 2320' N. & 1210' W., POD - 2 - 2255' N.
& 1155' W., POD - 3 - 1910' N. & 1045' W.,
POD - 4 - 1870' N. & 990' W., ALL FROM THE
S.E. CORNER, SECTION 22.

FINAL PROOF SURVEY

UNDER

Application No. 52434 Permit No. 39435
IN NAME OF

Surveyed 8-13, 1990, by K. KEMP

12-87578

Drafted 6-4-93 J.M. 41001-179-55R

