


WASHINGTON County
 2N 4W 13
 SCALE 1" = 400'

G-17305

WORK
 COPY

SEE MAP
 2N 4 12

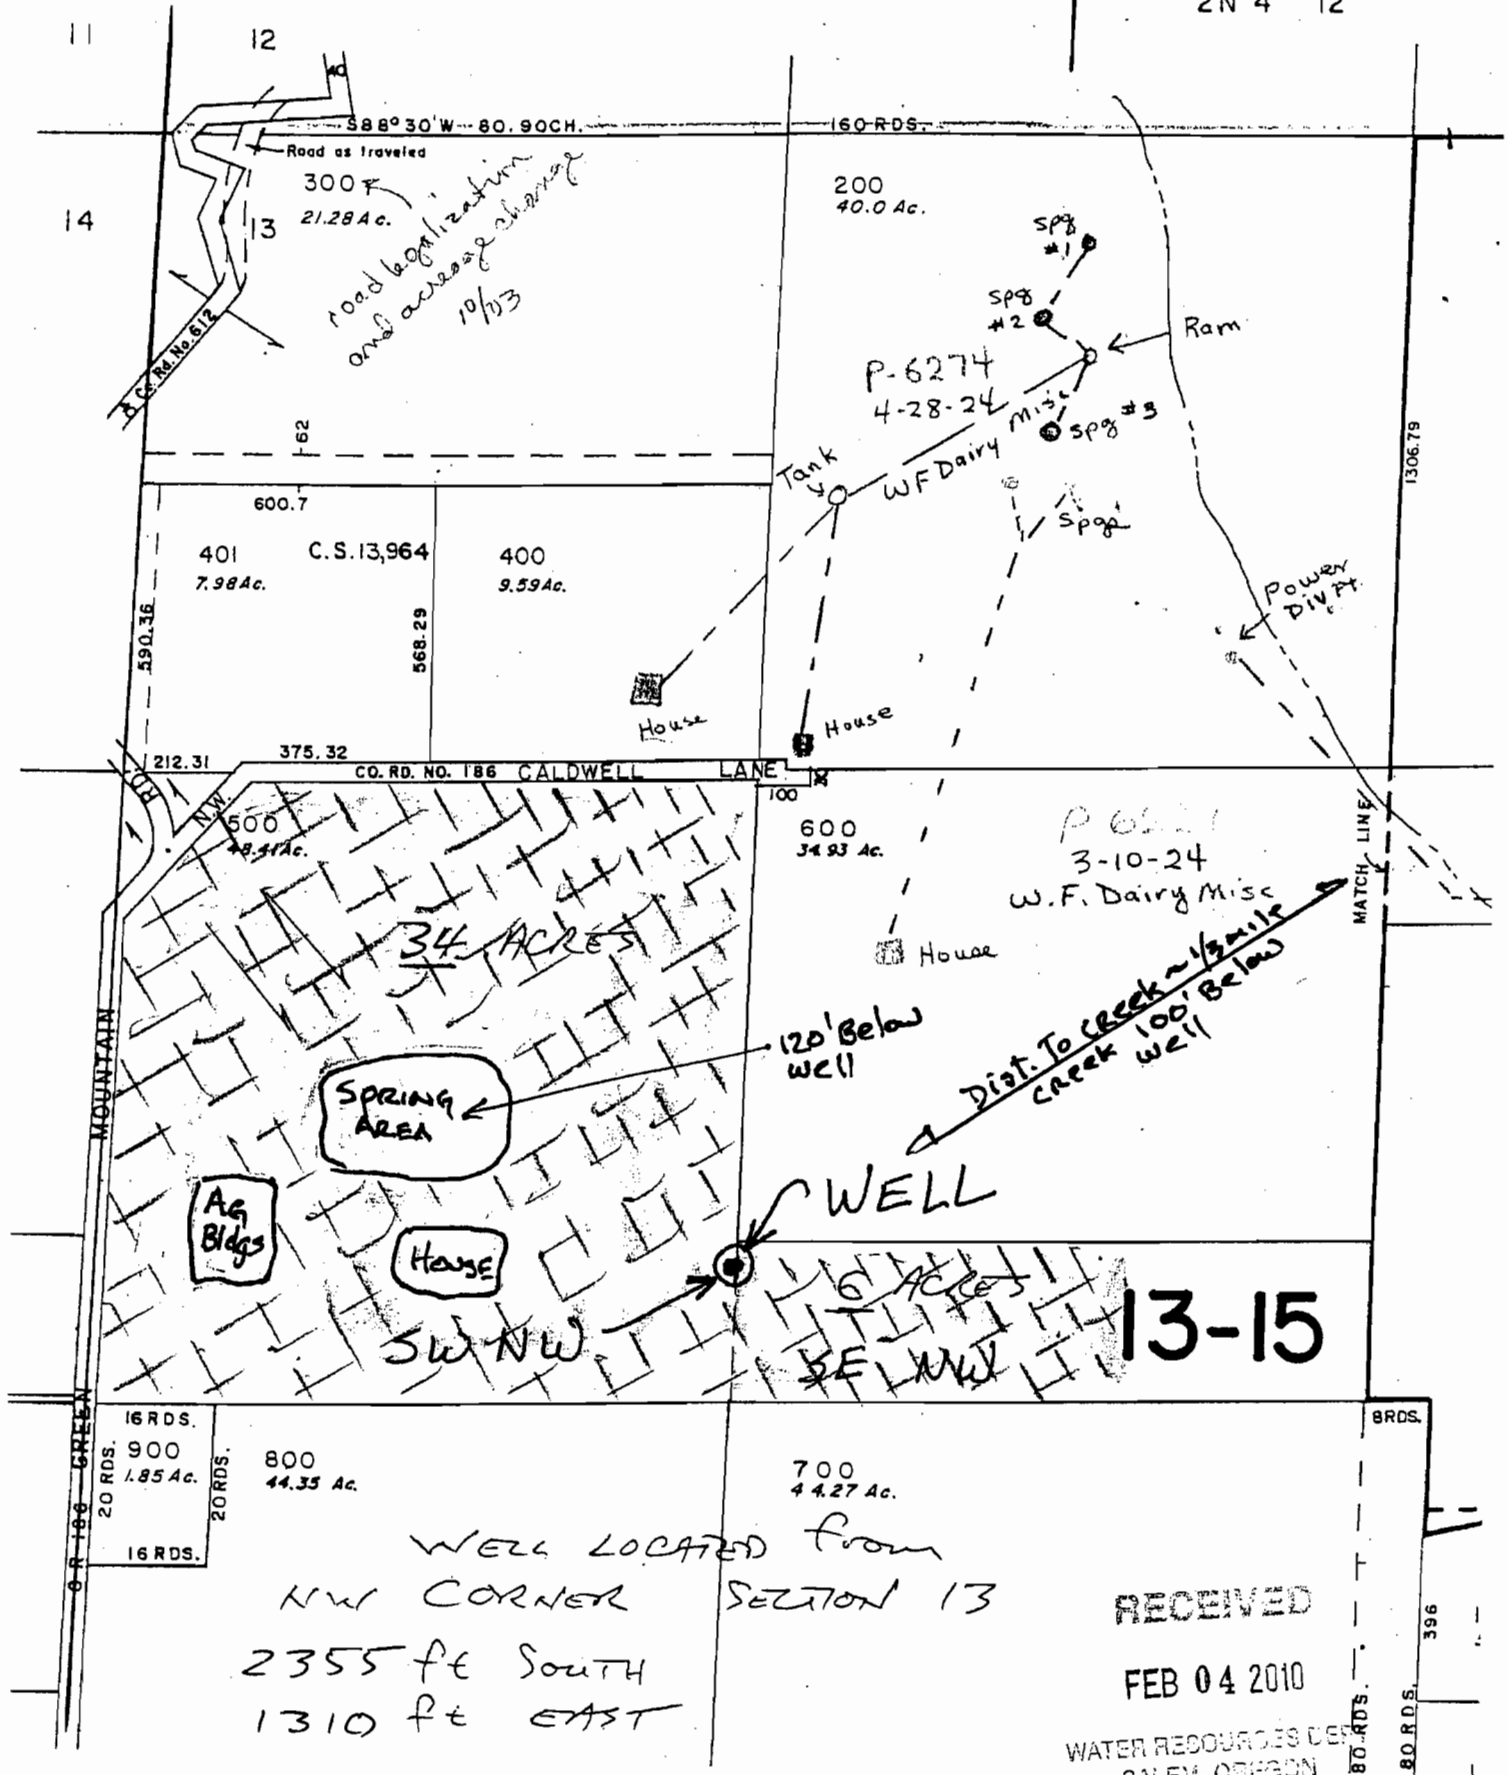

WASHINGTON County
 2N 4W 13
 SCALE 1"=400'

Gr-17305

SEE MAP
 2N 4 12

