


measures shall have validity on record or payments of water...

34



Compliments of
FIRST AMERICAN TITLE
This sketch is furnished
to assist in property
location and the com-
pany assumes no liabi-
lity for inaccuracies.

T21 R46

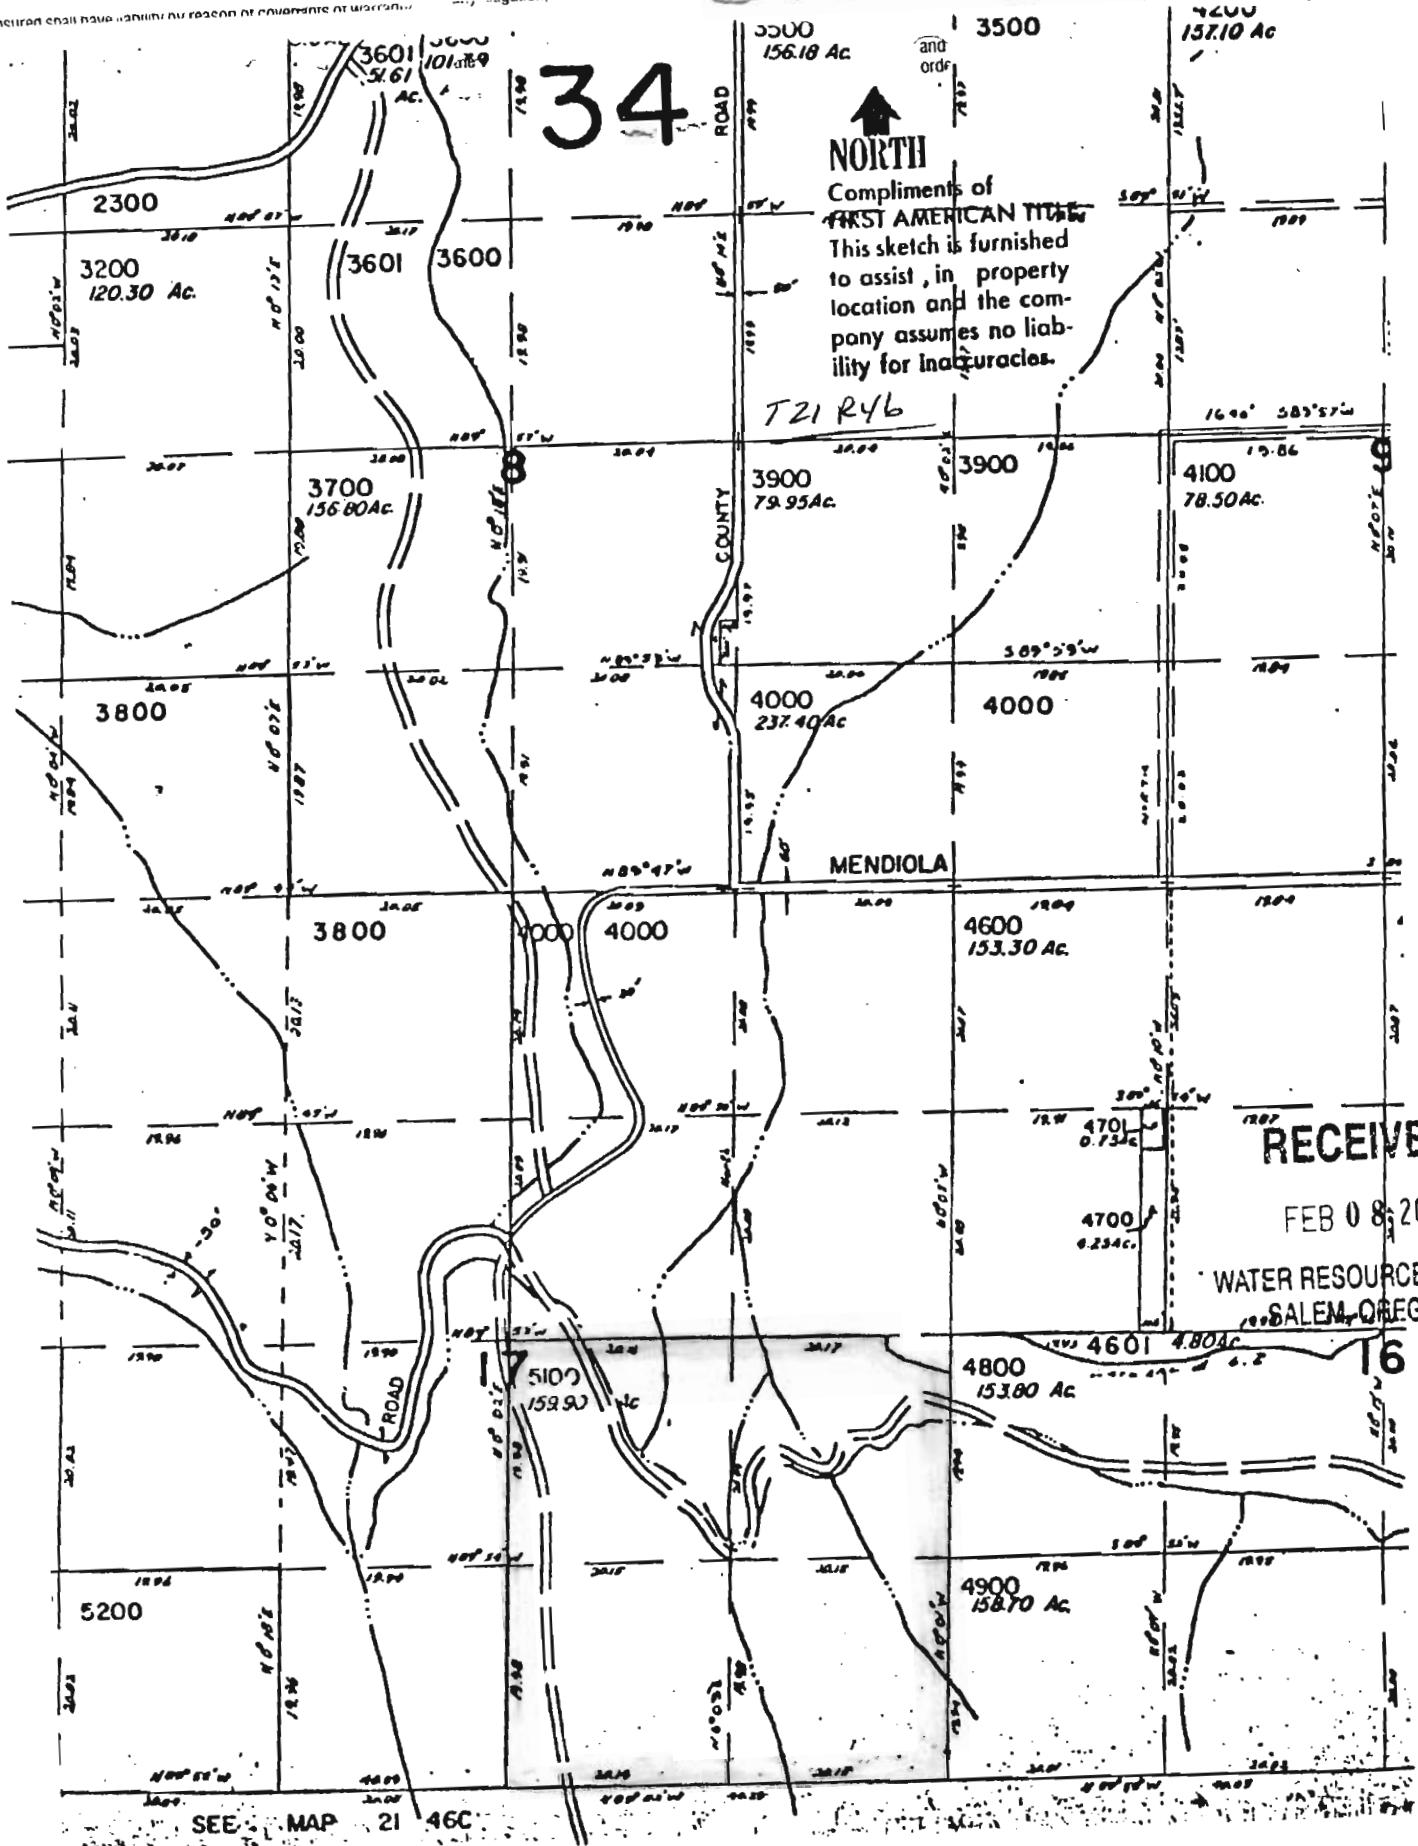

RECEIVED


FEB 08 2010

WATER RESOURCES DEPT
SALEM, OREGON

SEE MAP 21 46C


OWYHEE IRRIGATION DISTRICT

MAP #1
Water Legend

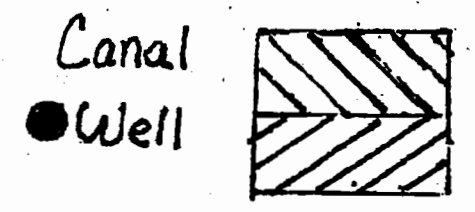


Acres Irrigated
in 1/4, 1/4, ~~2x~~
51 Total

SCALE: 1" = 600' APPROXIMATE

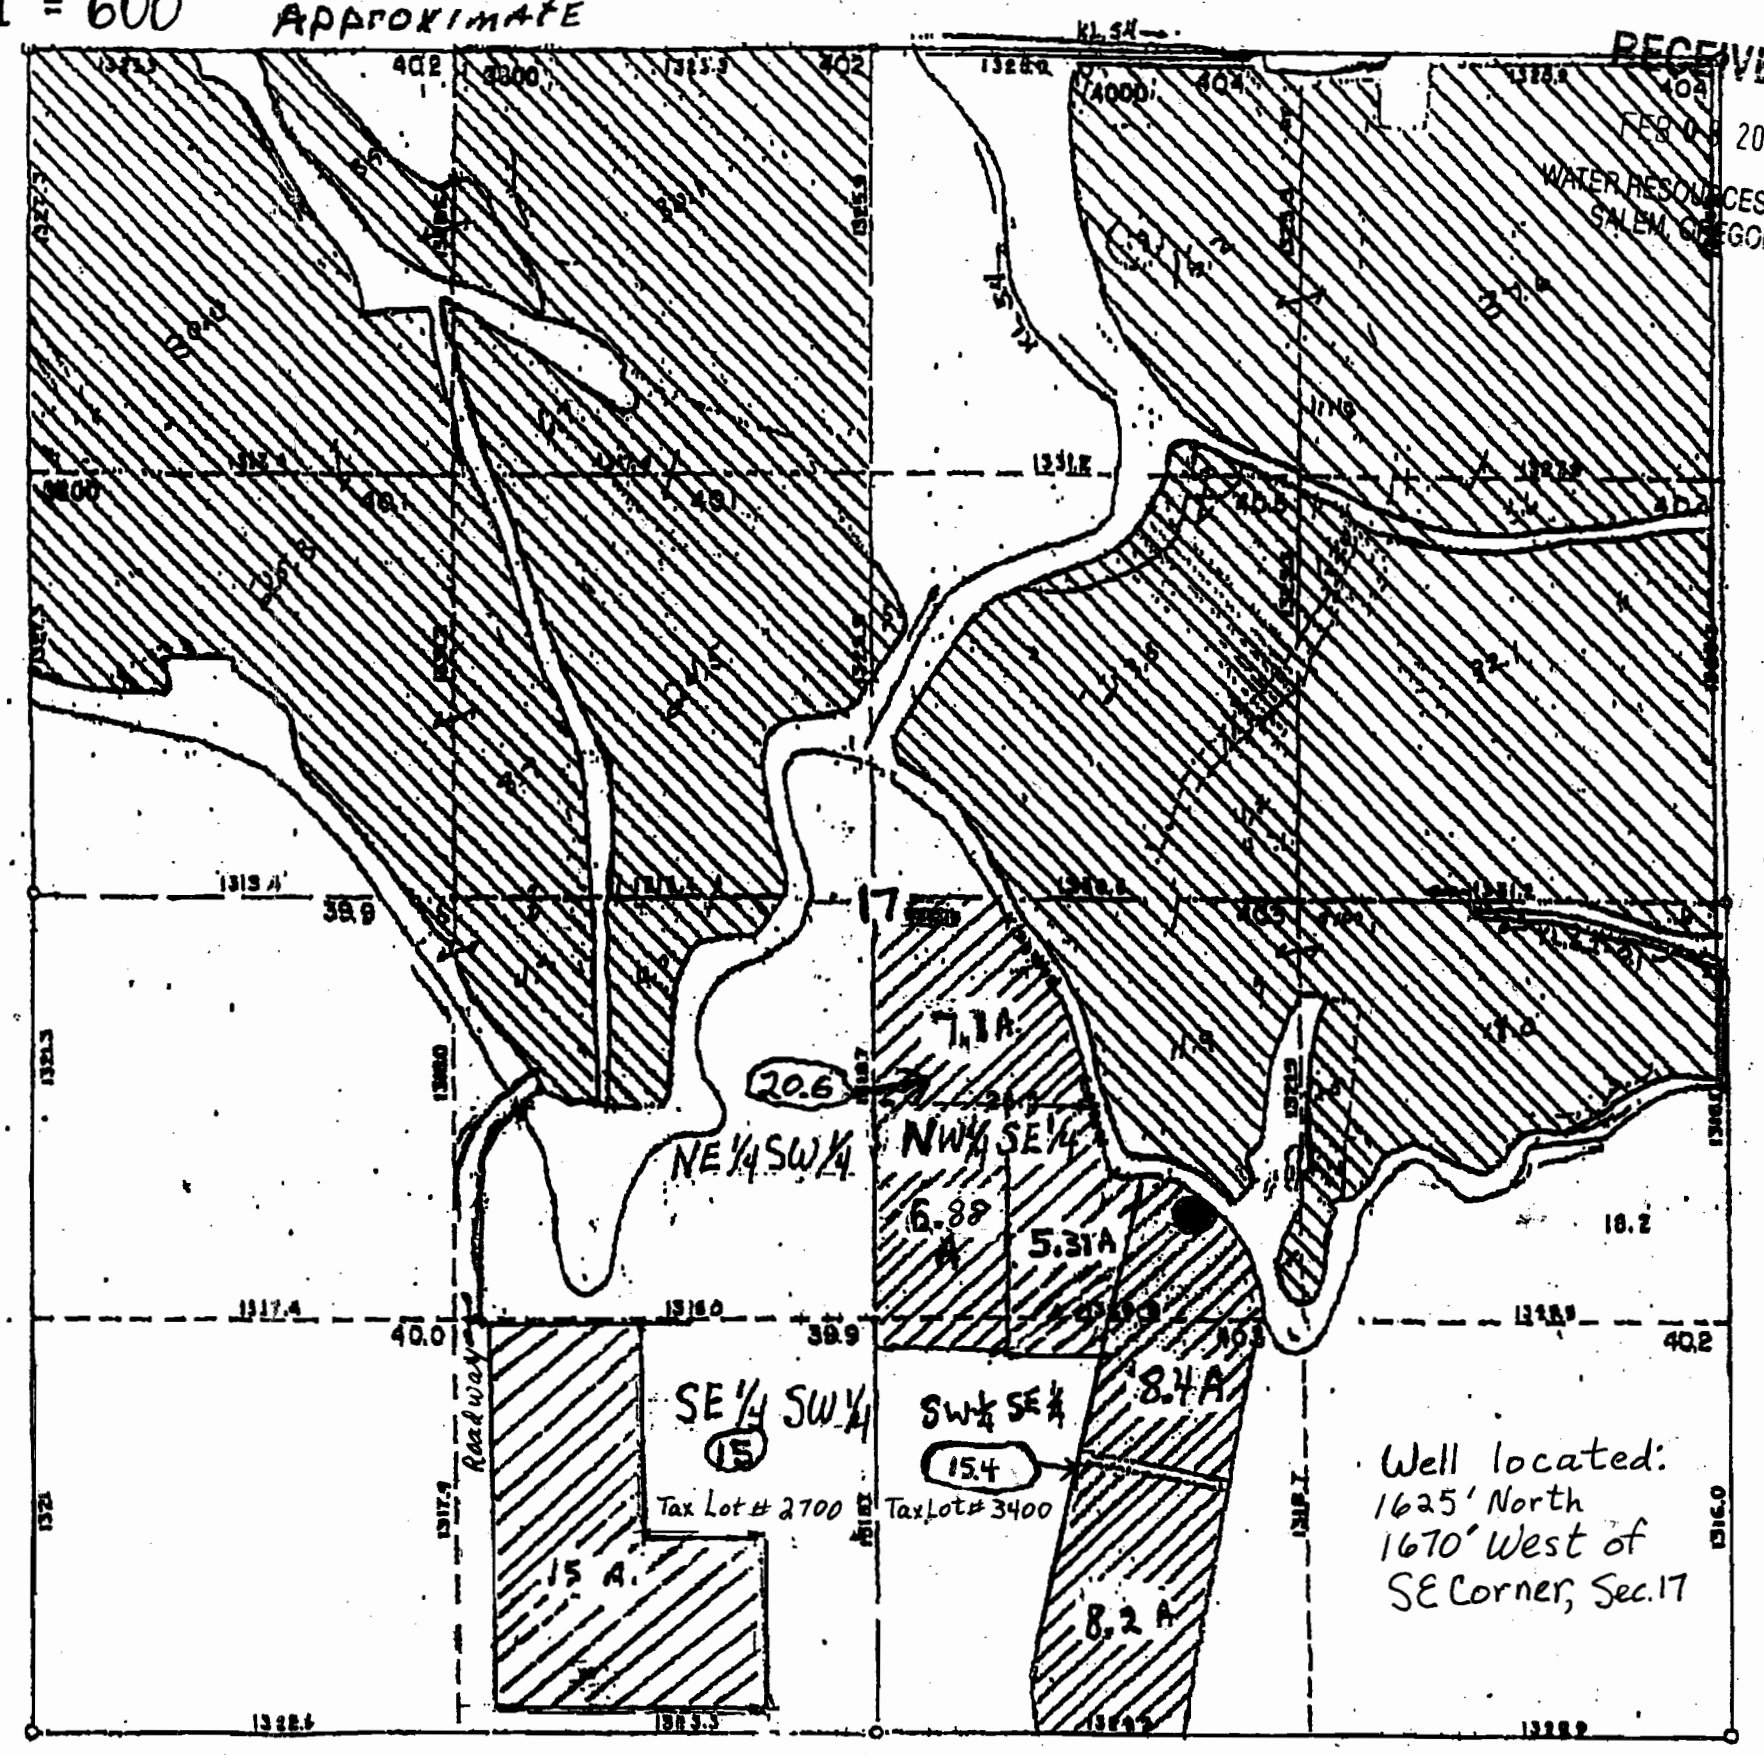

RECEIVED
FEB 09 2010
WATER RESOURCES DEPT
SALEM, OREGON

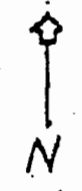

Well located:
1625' North
1670' West of
SE Corner, Sec. 17

SEC. 17 - T. 21 S. - R. 46 E.
18-M-1844

REVISED: JAN 2010 - Feb. 4, 2010 M.T.