


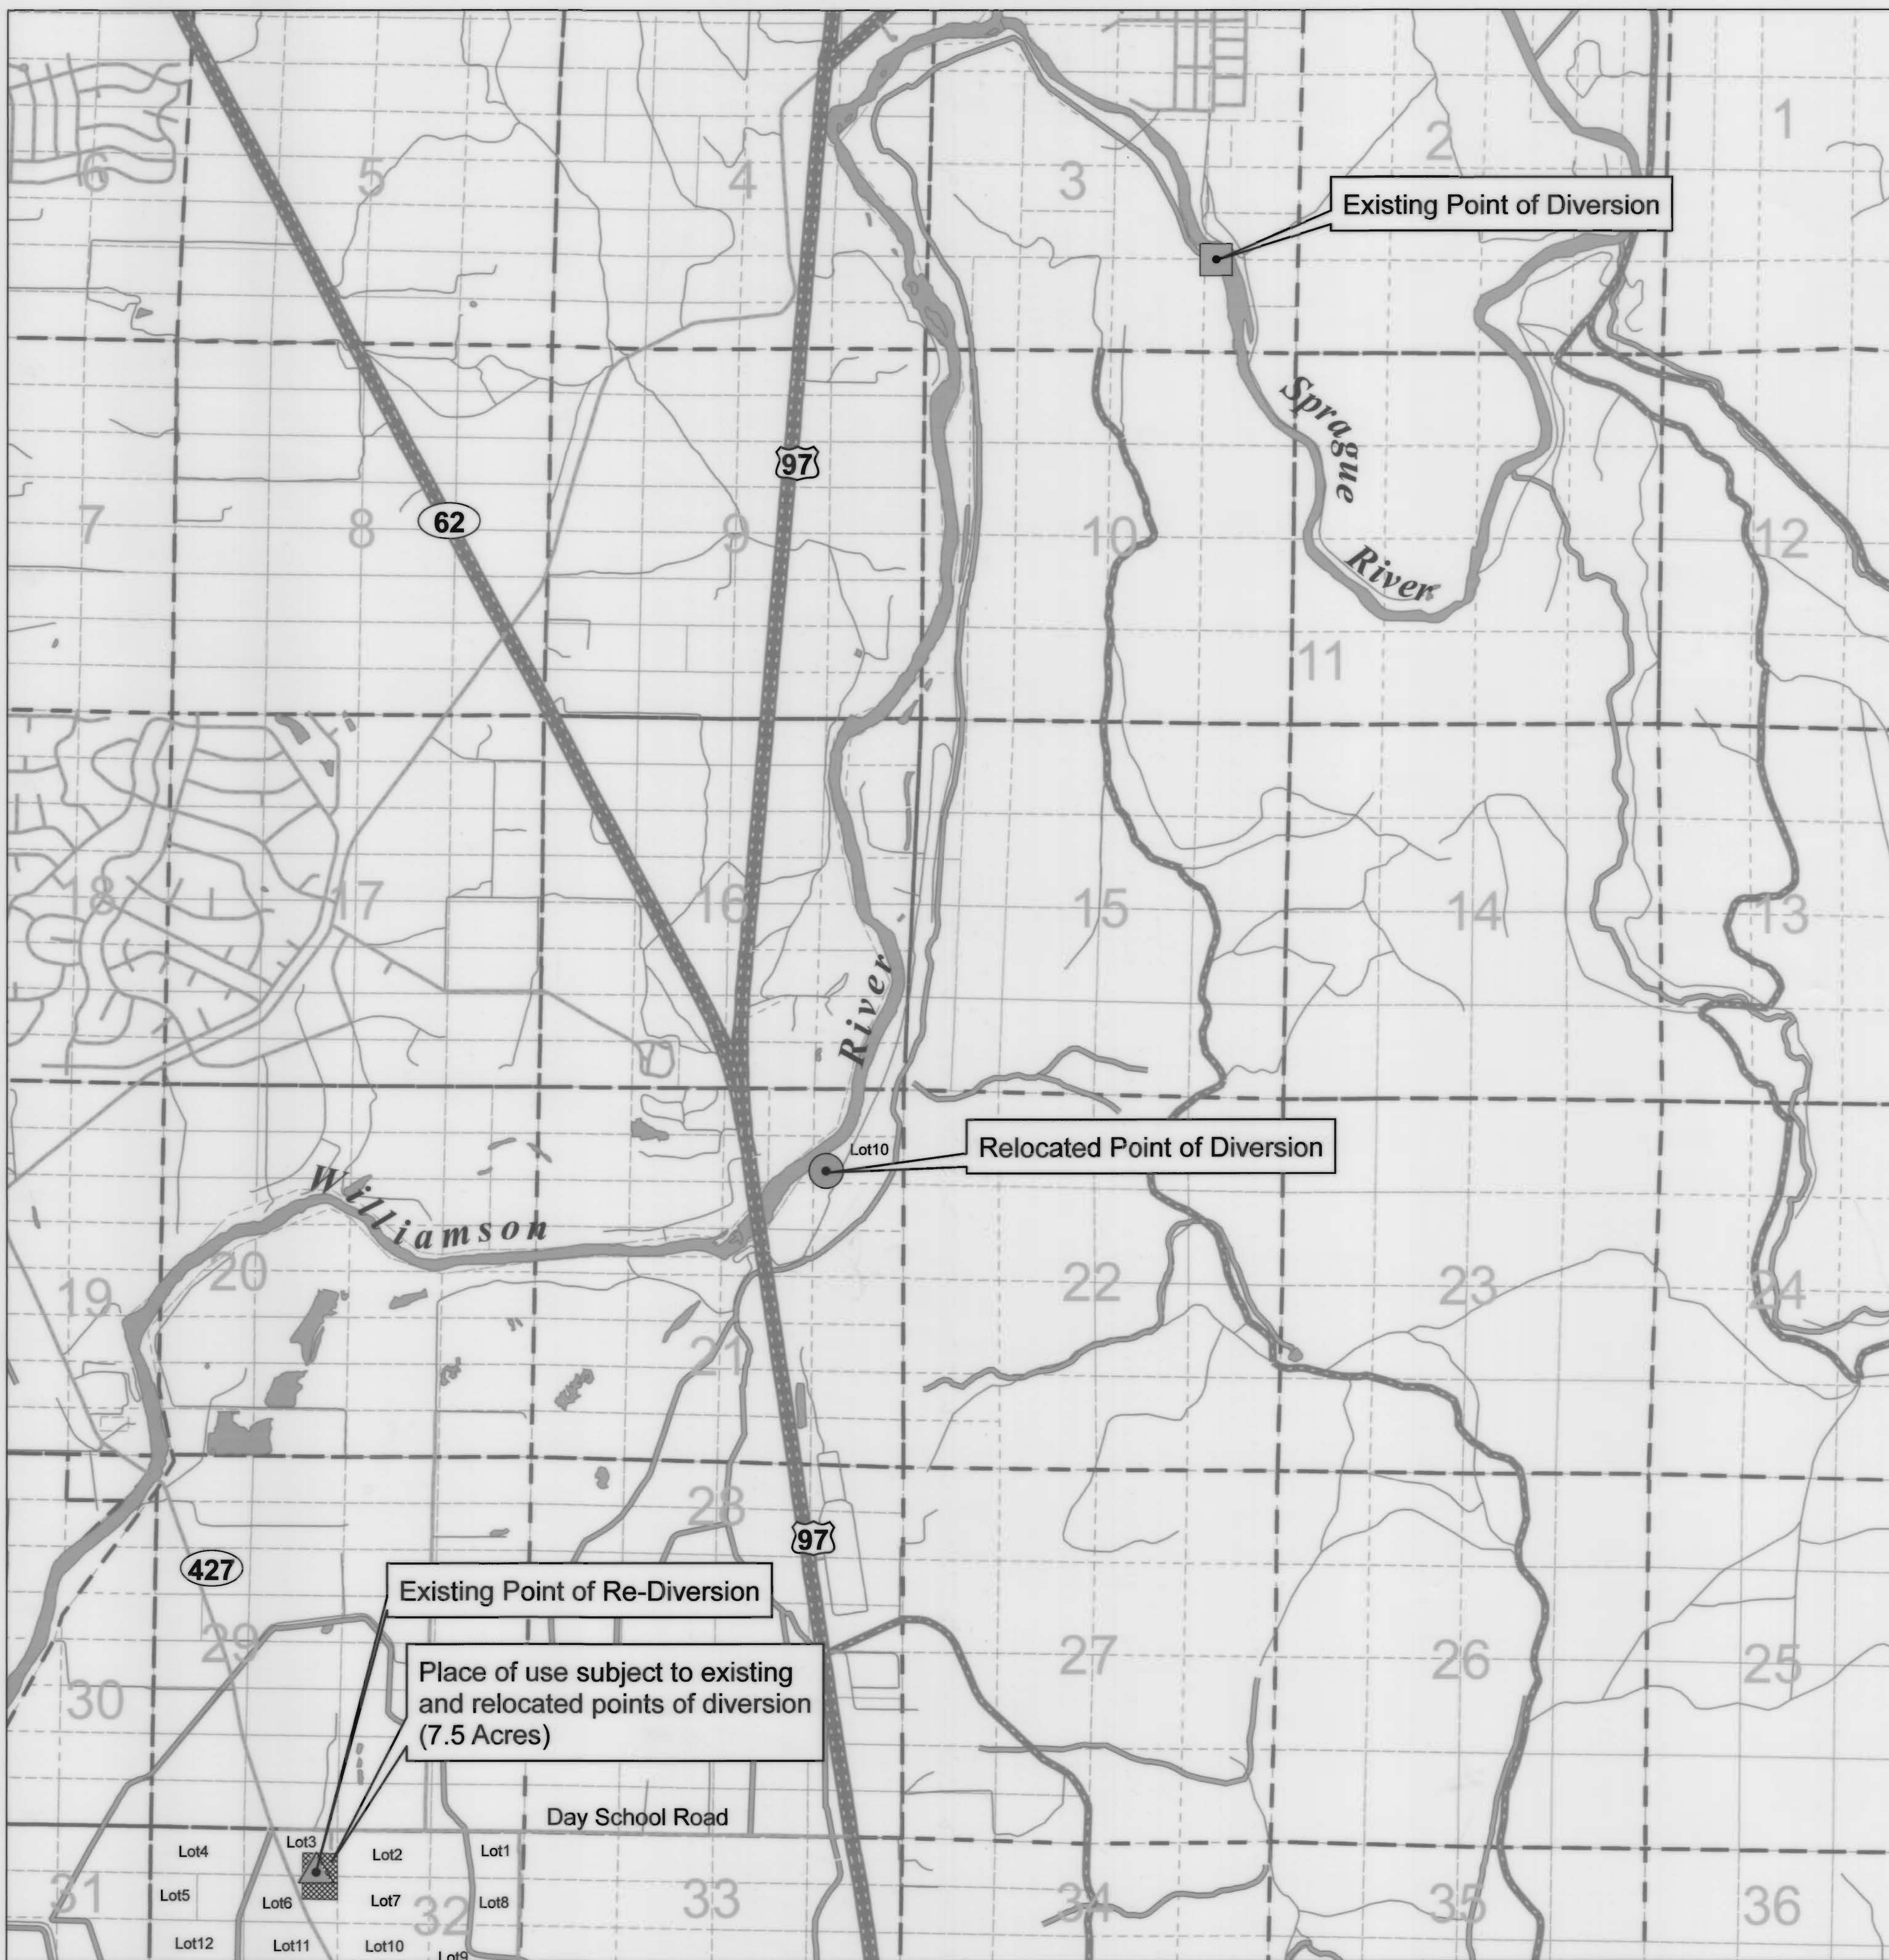

EXISTING POINTS OF DIVERSION

Point of Diversion	T35S R7E S3 SESE	125' East of the NW corner of the SESE of section 3
Point of Re-Diversion	T35S R7E S32 NENW	250' south and 250' west of the NE corner of the NENW of section 32, Lot 3

RELOCATED POINT OF DIVERSION

Point of Diversion	T35S R7E S21 NENE	180' north and 180' east of the SW corner of the NENE of section 21, Lot 10
--------------------	-------------------	---

PLACE OF USE SUBJECT TO EXISTING AND RELOCATED POD

T	R	SECTION	1/4 1/4	AREA (AC)	Lot #
35S	7E	32	NENW	7.5	Lots 3&6


LEGEND

- Existing Point of Diversion
- Existing Point of Re-Diversion
- Relocated Point of Diversion
- Water Bodies
- Streams and Canals
- Roads
- Sections
- Quarter, Quarter Sections
- Place of Use*
- * Place of Use subject to existing and relocated POD



0 1,320 2,640 Feet

Disclaimer:
This map was prepared for the purpose of identifying the location of a water right only, and is not intended to provide legal dimensions or locations of property ownership lines.

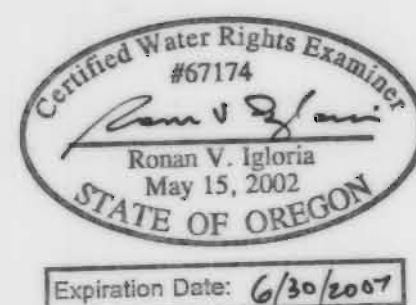

RECEIVED

NOV 29 2006
WATER RESOURCES DEPT
SALEM, OREGON

Certified Water Right Examiner

Ronan Igloria, PE CWRE
1001 SW 5th Ave. Suite 1800
Portland, Oregon 97204
Oregon Certificate Number: 67174WRE

Map for Alteration to Water Rights Claim #619 Relocated Point of Diversion Klamath Basin Adjudication

Township 35 South, Range 7 East, W.M.
Klamath County, Oregon

United States Bureau of Indian Affairs
911 NE 11th Ave.
Portland, Oregon 97232



HDR Engineering Inc.
October 28, 2006