





EXISTING POINTS OF DIVERSION		
Point of Diversion	T35S R7E S3 SESE	125' East of the NW corner of the SESE of section 3

RELOCATED POINT OF DIVERSION		
Point of Diversion	T35S R7E S21 NENE	180' north and 180' east of the SW corner of the NENE of section 21, Lot 10

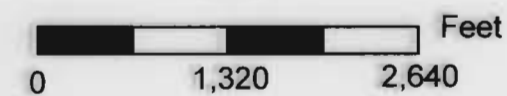

*Disclaimer:*  
This map was prepared for the purpose of identifying the location of a water right only, and is not intended to provide legal dimensions or locations of property ownership lines.

LEGEND	
	Existing Point of Diversion
	Relocated Point of Diversion
	Water Bodies
	Streams and Canals
	Roads
	Sections
	Quarter, Quarter Sections

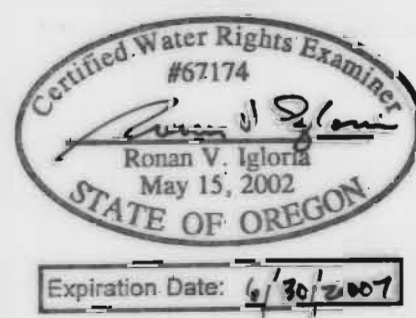

**RECEIVED**  
DEC 01 2006  
WATER RESOURCES DEPT  
SALEM OREGON

Certified Water Rights Examiner  
**Roman Igloria, PE CWRE**  
1001 SW 5<sup>th</sup> Ave. Suite 1800  
Portland, Oregon 97204  
Oregon Certificate Number: 67174WRE

**Map for Alteration to Water Rights Claim #241**  
**Relocated Point of Diversion**  
Klamath Basin Adjudication  
Township 35 South, Range 7 East, W.M.  
Klamath County, Oregon  
**Maryetta Gentry**  
P.O. Box 552  
Chiloquin, OR 97624  
**HDR** HDR Engineering Inc.  
October 28, 2006