



EXISTING POINTS OF DIVERSION		
Point of Diversion	T35S R7E S3 SESE	125' East of the NW corner of the SESE of section 3

RELOCATED POINT OF DIVERSION		
Point of Diversion	T35S R7E S21 NENE	180' north and 180' east of the SW corner of the NENE of section 21, Lot 10

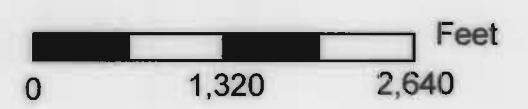

Disclaimer:
This map was prepared for the purpose of identifying the location of a water right only, and is not intended to provide legal dimensions or locations of property ownership lines.

LEGEND	
	Existing Point of Diversion
	Relocated Point of Diversion
	Water Bodies
	Streams and Canals
	Roads
	Sections
	Quarter, Quarter Sections

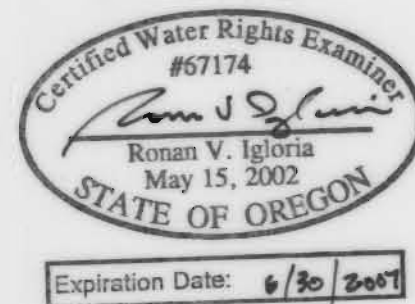

Certified Water Right Examiner

RECEIVED Ronan Igloria, PE CWRE
DEC 01 2006 1001 SW 5th Ave. Suite 1800
Portland, Oregon 97204
WATER RESOURCES DEPT Oregon Certificate Number: 67174WRE
SALEM OREGON

**Map for Alteration to Water Rights Claim #702
Relocated Point of Diversion
Klamath Basin Adjudication**

Township 35 South, Range 7 East, W.M.
Klamath County, Oregon

Mary Sheppard/Marilyn Sheppard
P.O. Box 1279
Chiloquin, OR 97624



HDR Engineering Inc.
November 22, 2006