



EXISTING POINTS OF DIVERSION		
Point of Diversion	T35S R7E S3 SESE	125' East of the NW corner of the SESE of section 3

RELOCATED POINT OF DIVERSION		
Point of Diversion	T35S R7E S21 NENE	180' north and 180' east of the SW corner of the NENE of section 21, Lot 10

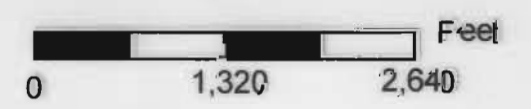

Disclaimer:
This map was prepared for the purpose of identifying the location of a water right only, and is not intended to provide legal dimensions or locations of property ownership lines.

LEGEND	
	Existing Point of Diversion
	Relocated Point of Diversion
	Water Bodies
	Streams and Canals
	Roads
	Sections
	Quarter, Quarter Sections

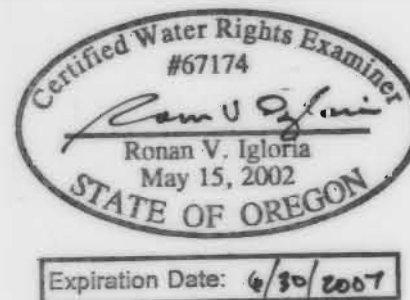

Certified Water Rights Examiner

Ronan Igloria, PE CWR#
1001 SW 5th Ave. Suite 1800
Portland, Oregon 97204
Oregon Certificate Number: 67174WR#

RECEIVED
DEC 01 2006
WATER RESOURCES DEPT
SALEM, OREGON

Map for Alteration to Water Rights #688
Relocated Point of Diversion
Klamath Basin Adjudication

Township 35 South, Range 7 East, W.1/4
Klamath County, Oregon

Leroy Hicks
Representative of
Harry Clarkson Estate

HDR HDR Engineering Inc.
October 28, 2006