



| EXISTING POINTS OF DIVERSION | | |
|------------------------------|------------------|---|
| Point of Diversion | T35S R7E S3 SESE | 125' East of the NW corner of the SESE of section 3 |

| RELOCATED POINT OF DIVERSION | | |
|------------------------------|-------------------|---|
| Point of Diversion | T35S R7E S21 NENE | 180' north and 180' east of the SW corner of the NENE of section 21, Lot 10 |

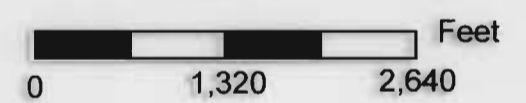

Disclaimer:
 This map was prepared for the purpose of identifying the location of a water right only, and is not intended to provide legal dimensions or locations of property ownership lines.

| LEGEND | |
|--------|------------------------------|
| | Existing Point of Diversion |
| | Relocated Point of Diversion |
| | Water Bodies |
| | Streams and Canals |
| | Roads |
| | Sections |
| | Quarter, Quarter Sections |

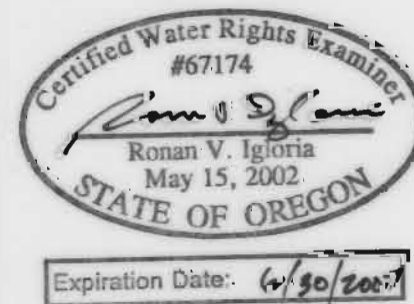

Certified Water Right Examiner

Ronan Igloria, PE CWRE
 1001 SW 3rd Ave. Suite 1800
 Portland, Oregon 97204
 Oregon Certificate Number: 67174WRE

RECEIVED
 DEC 01 2006
 WATER RESOURCES DEPT
 SALEM, OREGON

Map for Alteration to Water Rights Claim #269
Relocated Point of Diversion
 Klamath Basin Adjudication

Township 35 South, Range 7 East, W.M.
 Klamath County, Oregon

Mary Sheppard/Marilyn Sheppard
 P.O. Box 1279
 Chiloquin, OR 97624

HDR HDR Engineering Inc.
 October 28, 2006