





EXISTING POINTS OF DIVERSION	
Point of Diversion	T35S R7E S3 SESE 125' East of the NW corner of the SESE of section 3

RELOCATED POINT OF DIVERSION	
Point of Diversion	T35S R7E S21 NE1E 180' north and 180' east of the SW corner of the NE1E of section 21, Lot 10

LEGEND	
	Existing Point of Diversion
	Relocated Point of Diversion
	Water Bodies
	Streams and Canals
	Roads
	Sections
	Quarter, Quarter Sections

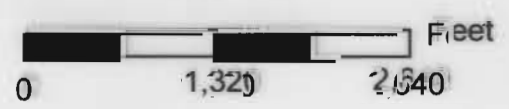

Disclaimer:
This map was prepared for the purpose of identifying the location of a water right only, and is not intended to provide legal dimensions or locations of property ownership lines.

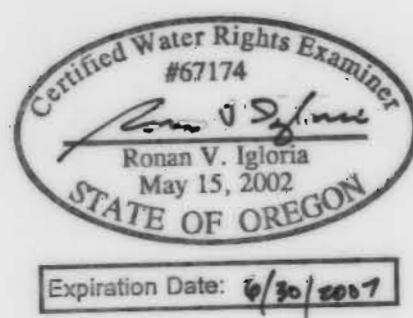

Certified Water Right Examiner
Ronan Igloria, PE CWRE
 1001 SW 5th Ave, Suite 1800
 Portland, Oregon 97204
 Oregon Certificate Number: 6717410RE

RECEIVED
 DEC 01 2006
 WATER RESOURCES DEPT
 SALEM OREGON

**Map for Alteration to Water Rights Claim #266
 Relocated Point of Diversion
 Klamath Basin Adjudication**

Township 35 South, Range 7 East, W.M.
 Klamath County, Oregon

Nancy Kidenour
 25857 Modoc Point Road
 Chiloquin, OR 97524

