


EXISTING POINTS OF DIVERSION		
Point of Diversion	T35S R7E S3 SESE	125' East of the NW corner of the SESE of section 3

RELOCATED POINT OF DIVERSION		
Point of Diversion	T35S R7E S21 NENE	180' north and 180' east of the SW corner of the NENE of section 21, Lot 10



*Disclaimer:*  
 This map was prepared for the purpose of identifying the location of a water right only, and is not intended to provide legal dimensions or locations of property ownership lines.

LEGEND	
	Existing Point of Diversion
	Relocated Point of Diversion
	Water Bodies:
	Streams and Canals
	Roads
	Sections
	Quarter, Quarter Sections

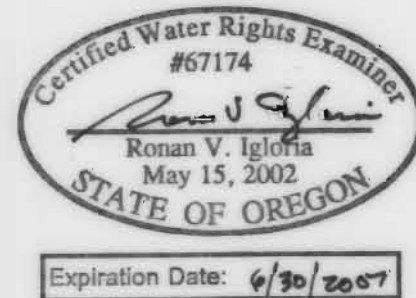

**RECEIVED**  
 DEC 01 2006  
 WATER RESOURCES DEPT  
 SALEM OREGON

*Certified Water Right Examiner*  
**Ronan Igloria, PE CWRE**  
 1001 SW 5<sup>th</sup> Ave. Suite 1800  
 Portland, Oregon 97204  
 Oregon Certificate Number: 67174WRE

**Map for Alteration to Water Rights Claim #260**  
**Relocated Point of Diversion**  
 Klamath Basin Adjudication

Township 35 South, Range 7 East, W.M.  
 Klamath County, Oregon

**Stephen and Beverly Lang**  
 2902 1/2 Oak Road  
 Chiloquin, OR 97624

**HDR** HDR Engineering, Inc.  
 October 28, 2006