


SEC.4 T.29S. R.7W. W.M.
DOUGLAS COUNTY
Scale 1" = 1000'

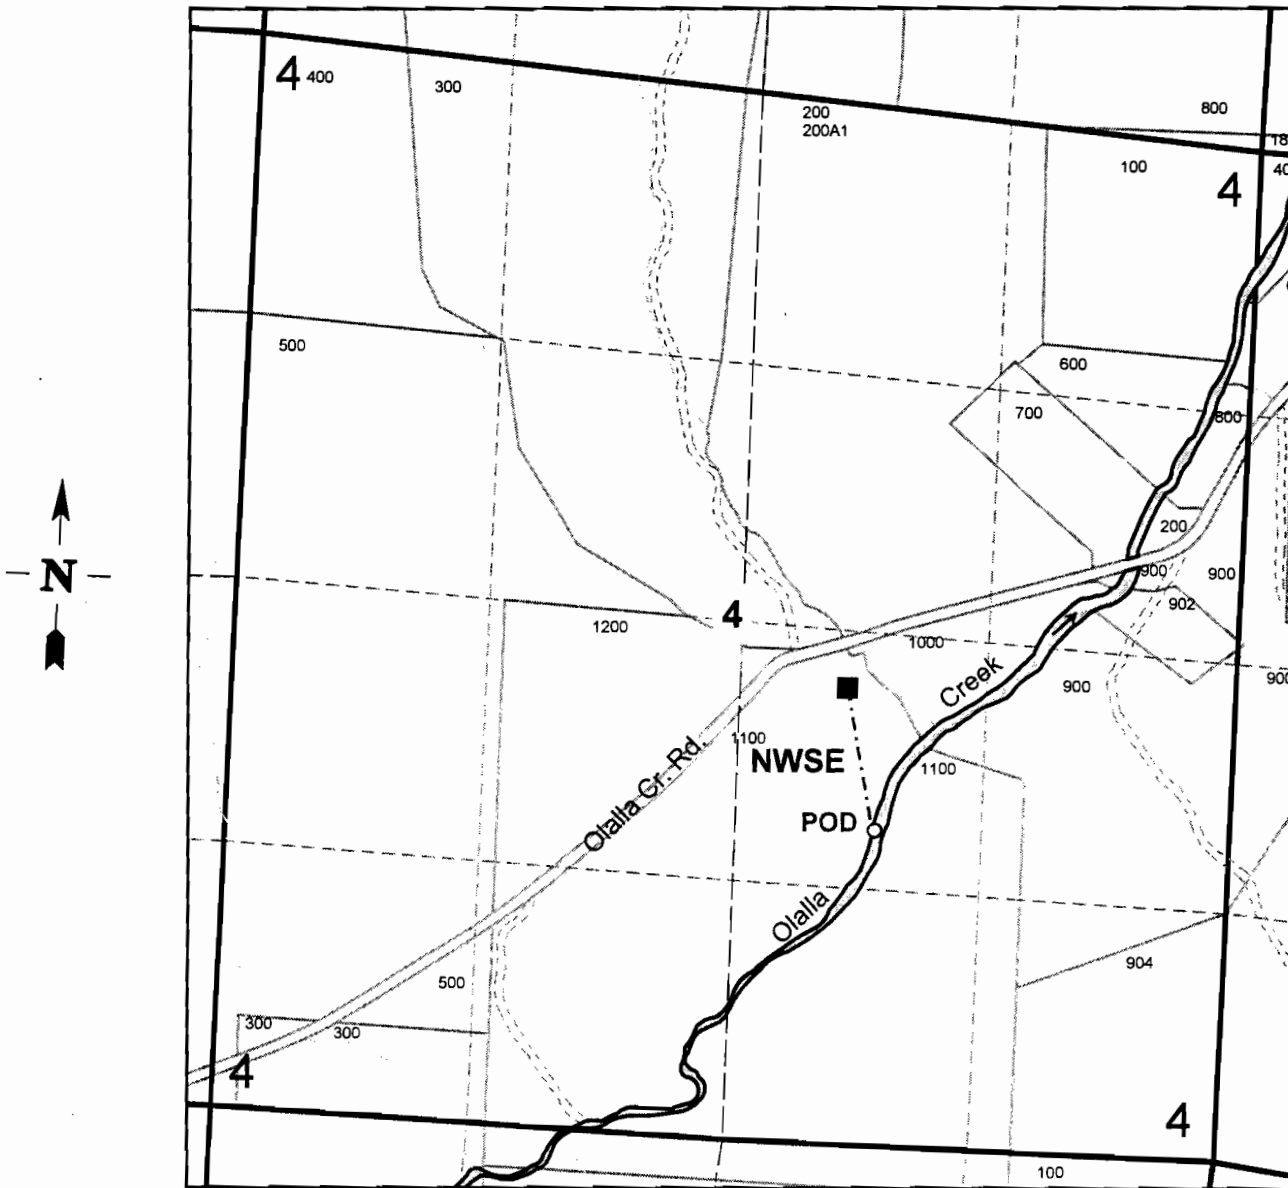

POD: 1637 ft. N.1839 ft. W. from the SE corner of Sec. 4

RECEIVED

FEB 16 2010

WATER RESOURCES DEPT
SALEM, OREGON