
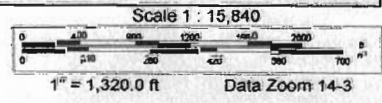


RECEIVED
MAY 03 2010
WATER RESOURCES DEPT
SALEM, OREGON

Data use subject to license.
© 2006 DeLorme, Topo USA® 6.0.
www.delorme.com

R-2
04/29/10

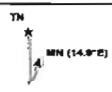

App G-17310

COLLECTED ADJUSTED
APPX SCALE
1" = 600 FEET

200 ft to nearest water - French Gulch Elev 4955 ft

French Gulch Wash Pla

WELL LOCATED FROM
KNEE CORNER SECTION 20
170 ft SOUTH
2550 ft EAST

WELL #1 P

500 ft - 6" hose to Wash Pla

Well Head Elev. 4960 ft
Tank at Well Head


HUMBOLT SHAFT

N44° 25' 46.11"
W117° 36' 5.41"



Well Water Use Area
Approx 157 acres (Shaded Area)

5780 ft of 6" hose to California Gulch Site


SECTION 20

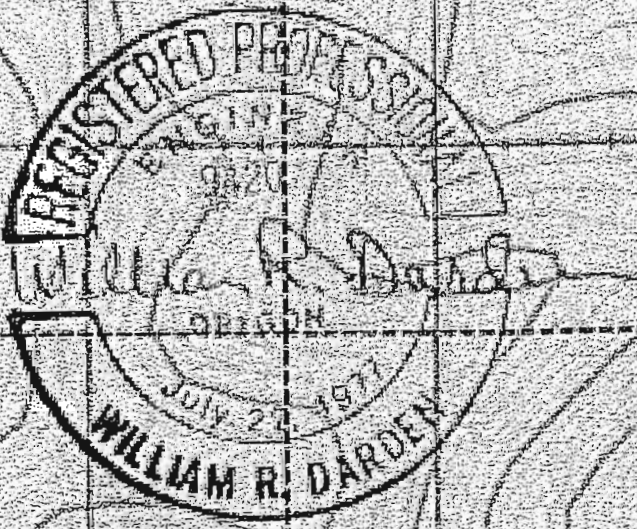

0151-17310

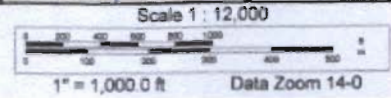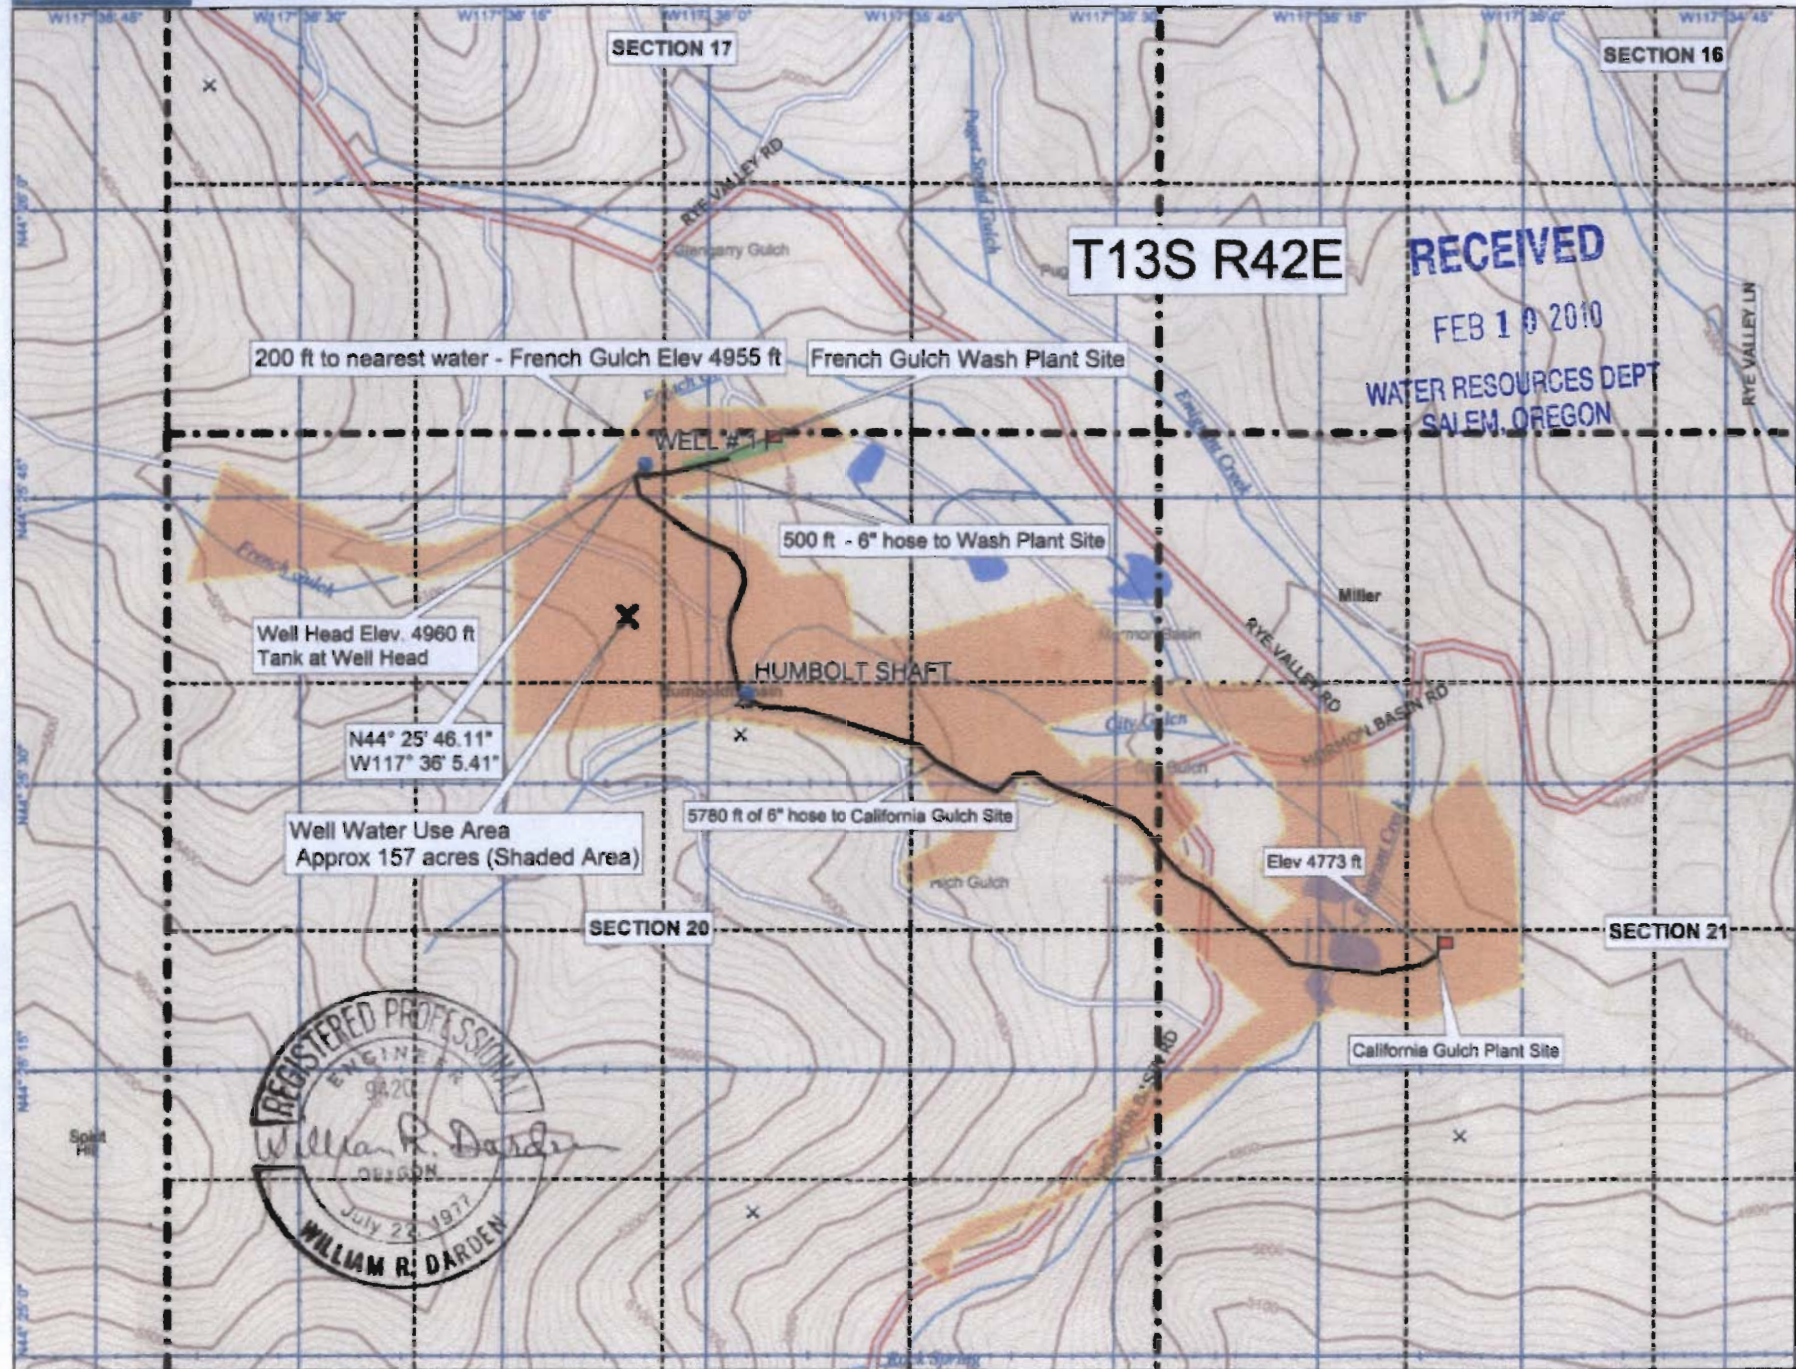

G-17710


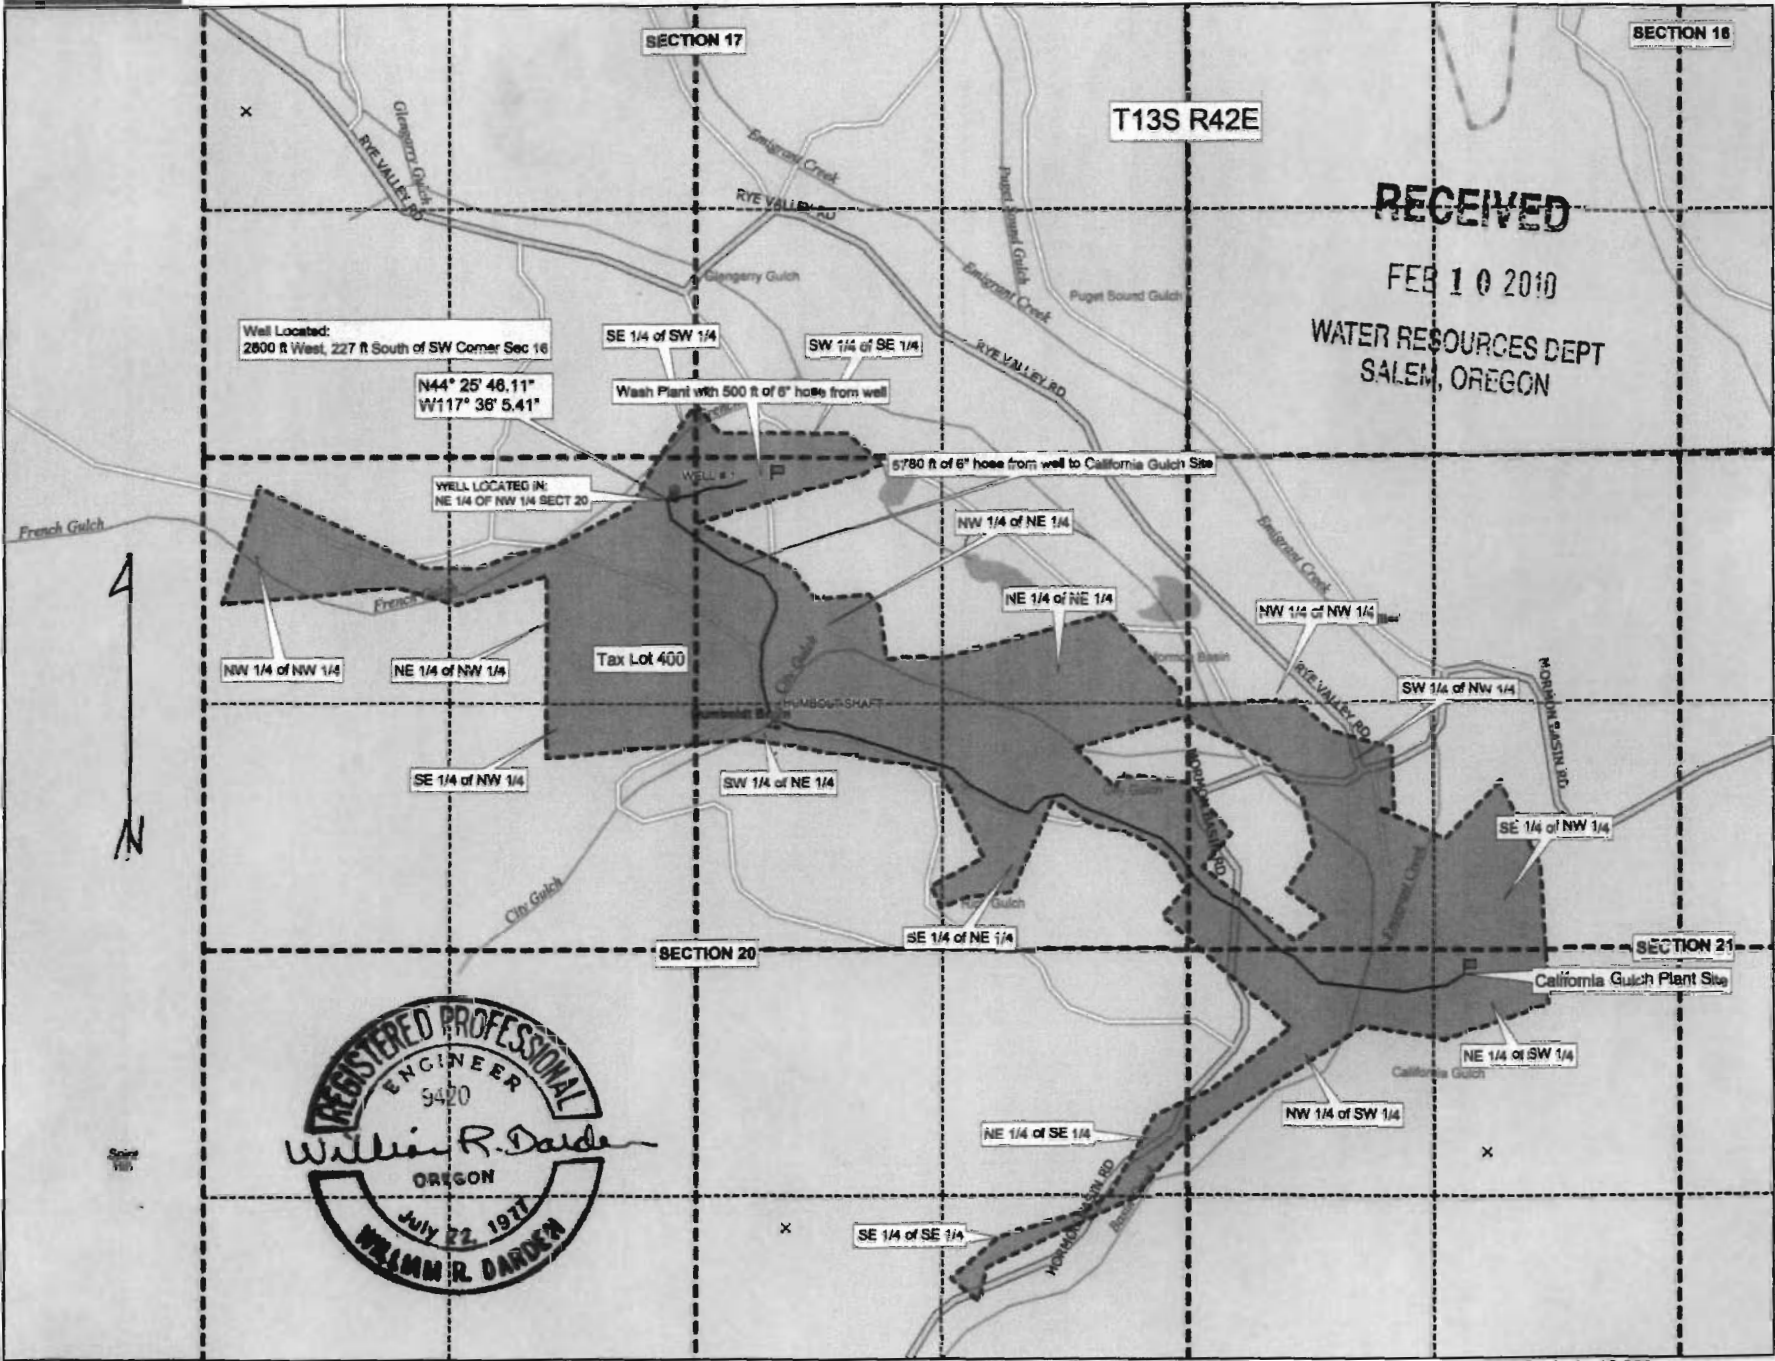


RECEIVED
 FEB 10 2010
 WATER RESOURCES DEPT
 SALEM, OREGON



Data use subject to license.
 © 2006 DeLorme. Topo USA® 6.0.
 www.delorme.com

R-1

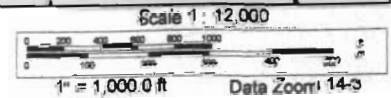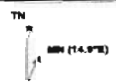



RECEIVED
FEB 10 2010
WATER RESOURCES DEPT
SALEM, OREGON