

RECEIVED  
T-5962  
V41 P.495

JUN 22 1987

T. 12 S., R. 26 E., W.M.

TRANSFER APPLICATION MAP FOR

WATER RESOURCES DEPT  
SALEM, OREGON


JERALD F. CLAUSEN

T-5962




SCALE

4" = 1 mi

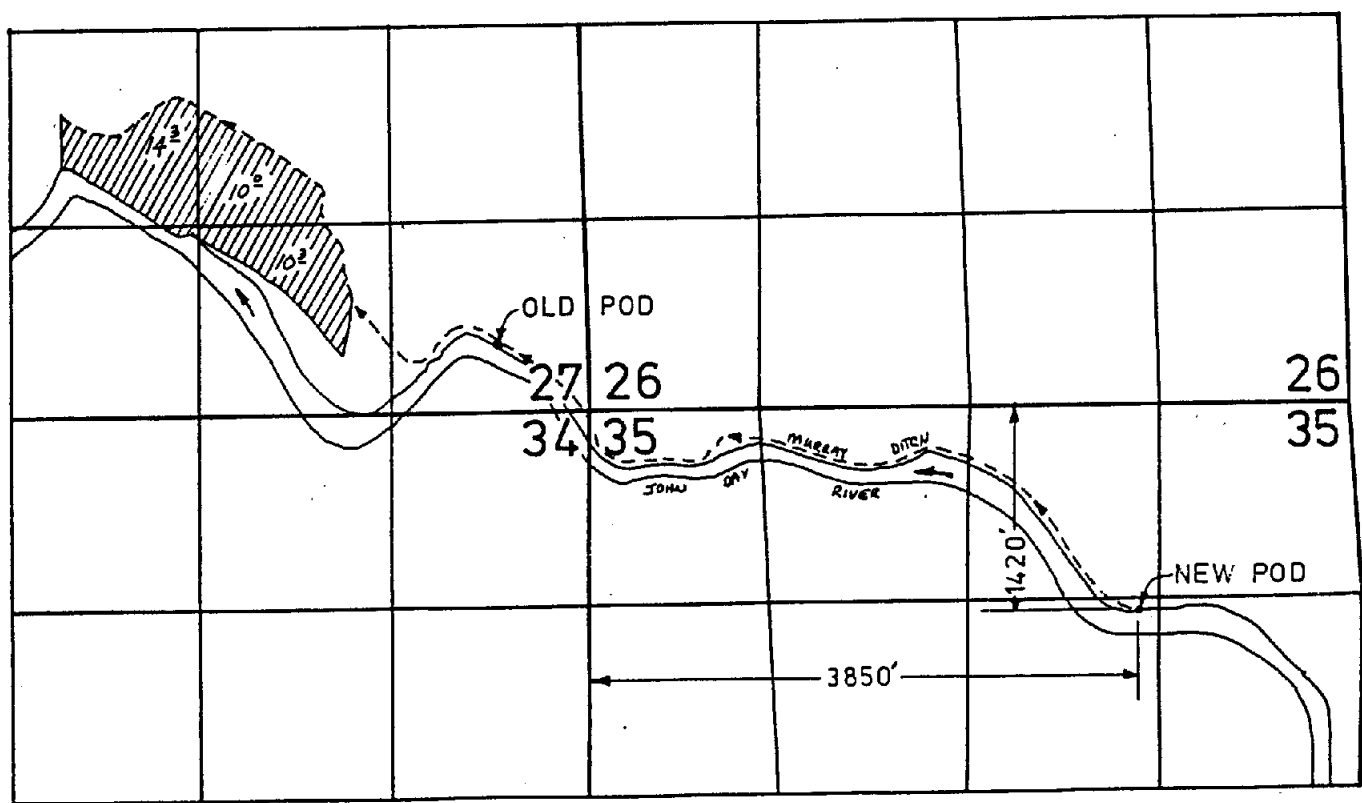

Old Div. - 450' N & 620' W from the  
SE corner of Sec. 27

T12S R. 26E W. 4.  
 Adj. indicated Washer Right Map

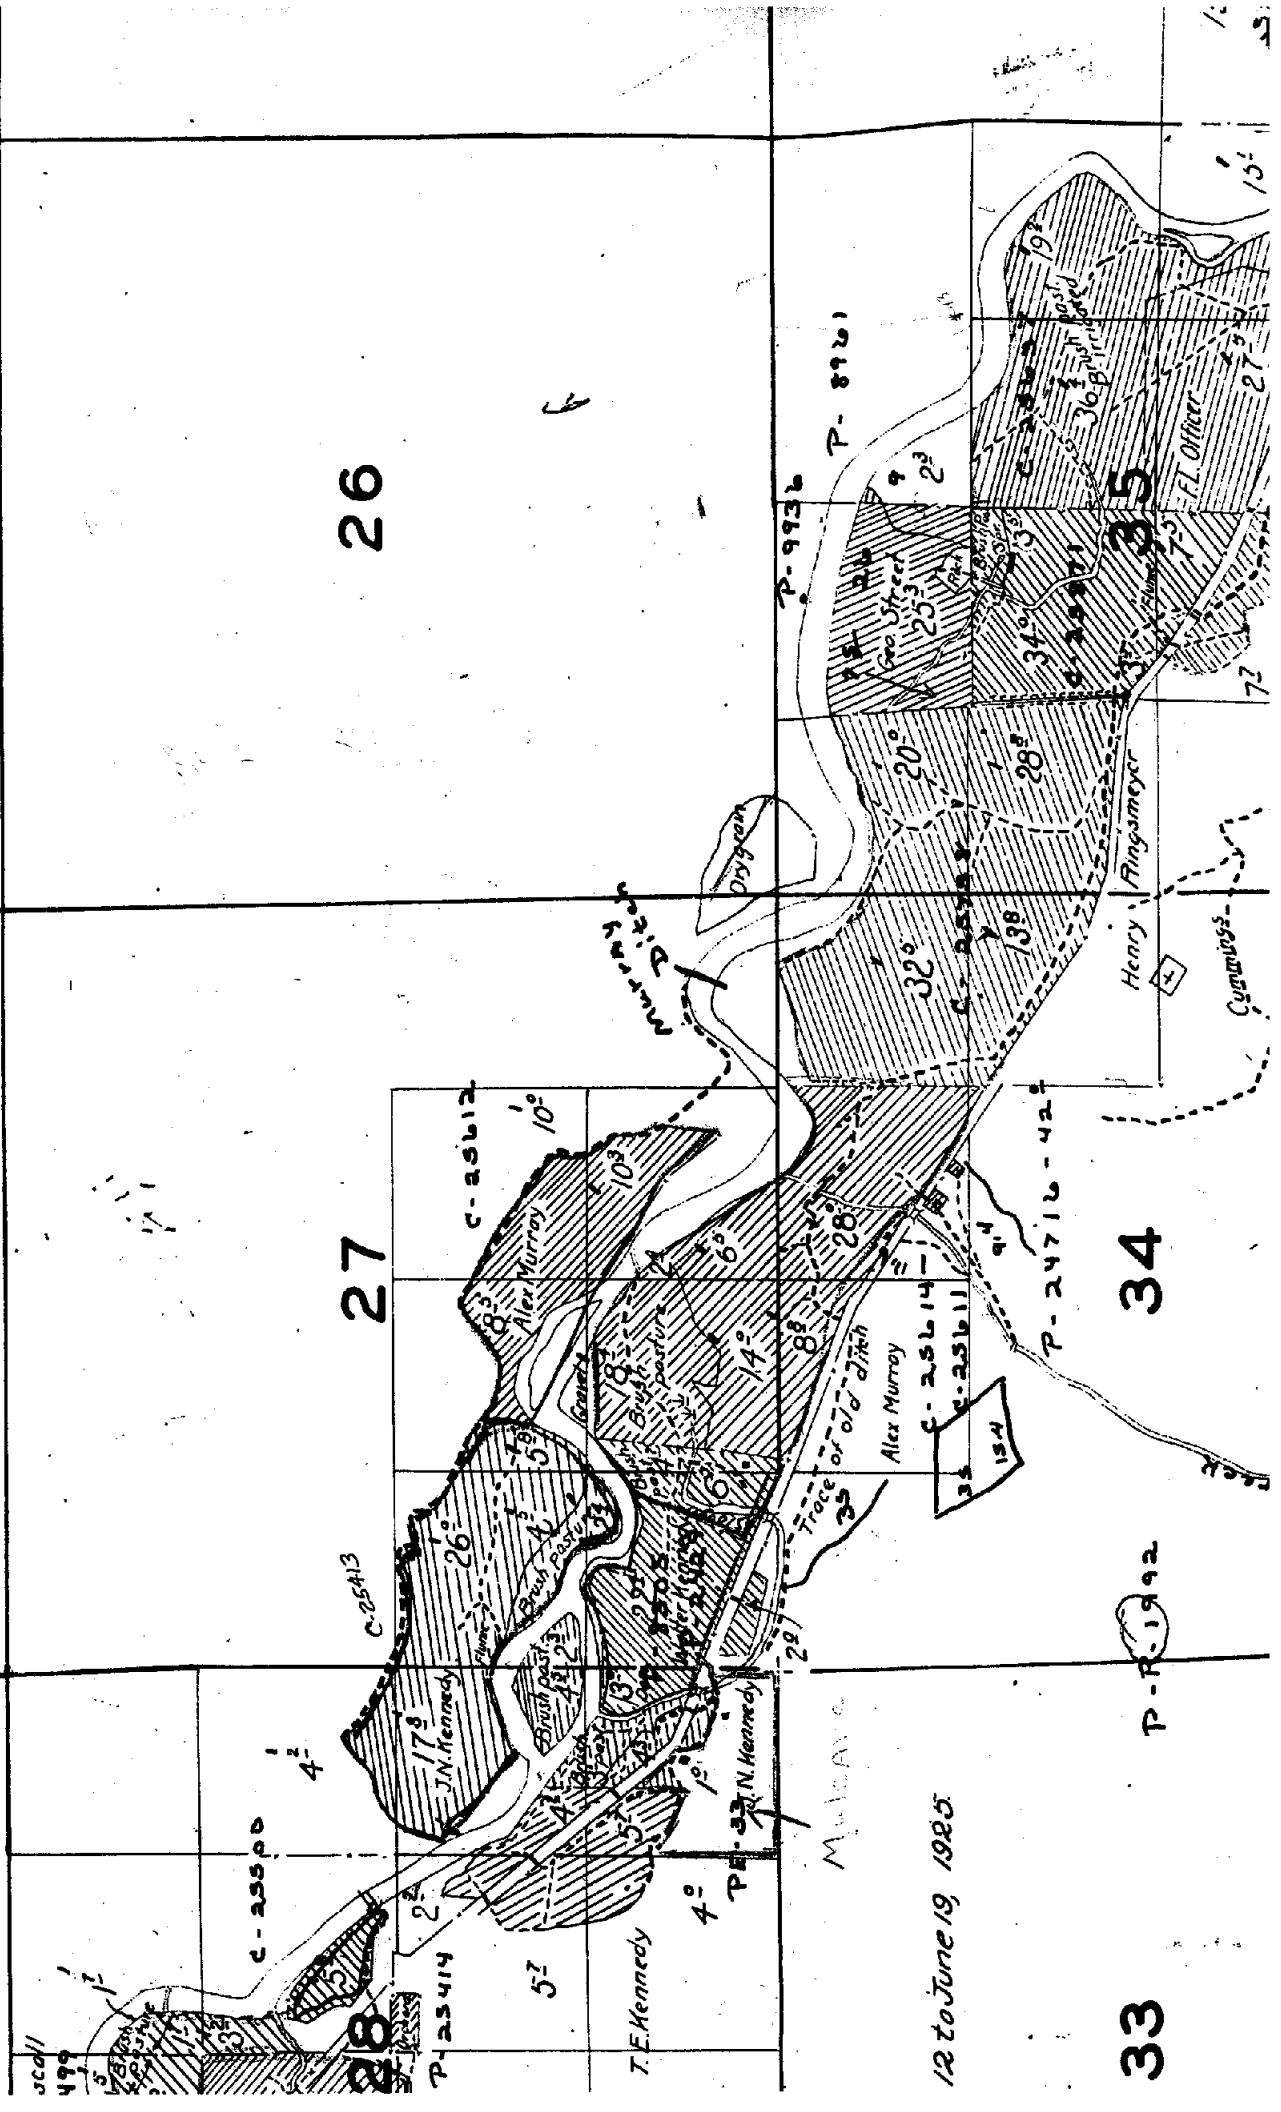

26

27

34

35

12 to June 19, 1925

P-1992

33

1/2

15'

72'

Commission

PREK

MURRAY

15'

15'