


SEC.18 T.28S. R.6W. W.M.
DOUGLAS COUNTY
Scale 1" = 1000'

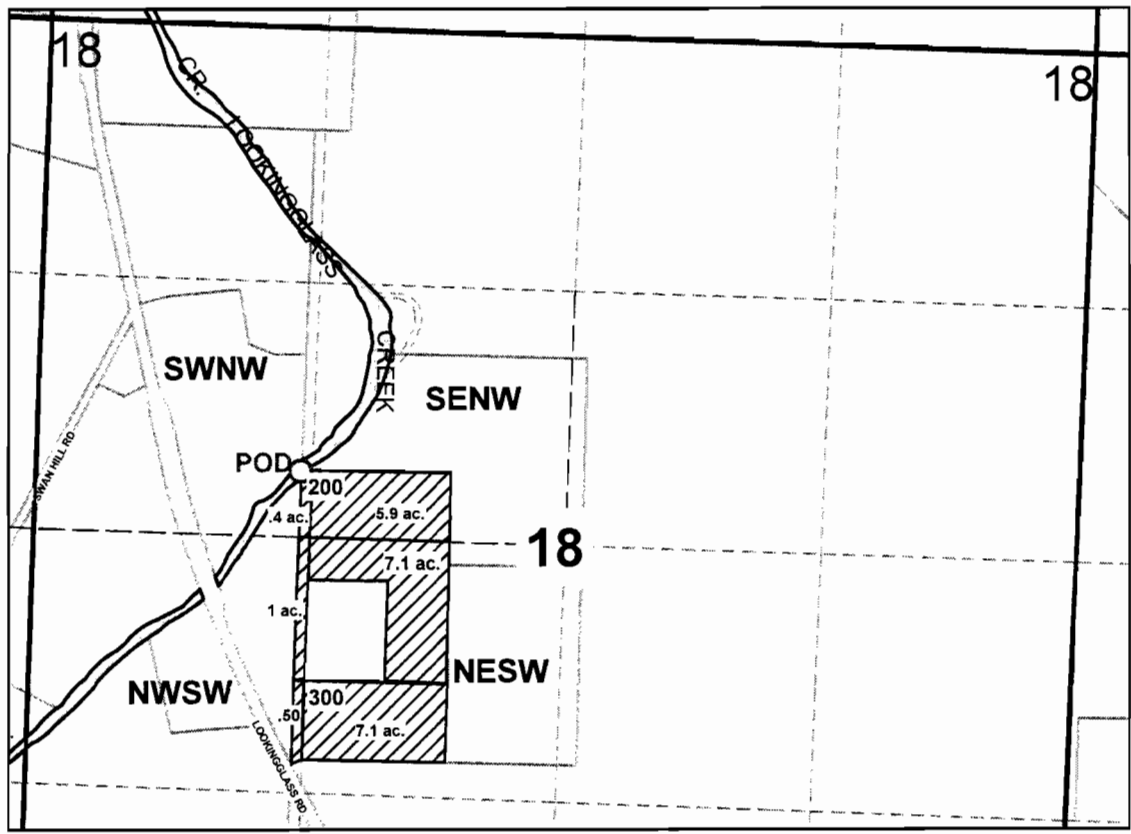

POD located 2340 ft. South and 1400 ft. East from the NW 1/4 corner of Section 18.

RECEIVED
FEB 17 2010
WATER RESOURCES DEPT
SALEM, OREGON