


SECTION 23 T.2N. R.10E. W.M.  
HOOD RIVER COUNTY

1" = 400'

2N 10 23

THIS MAP WAS PREPARED FOR  
ASSESSMENT PURPOSE ONLY

CANCELLED NO.  
500  
1200  
1802  
2000  
3701  
4000  
4100

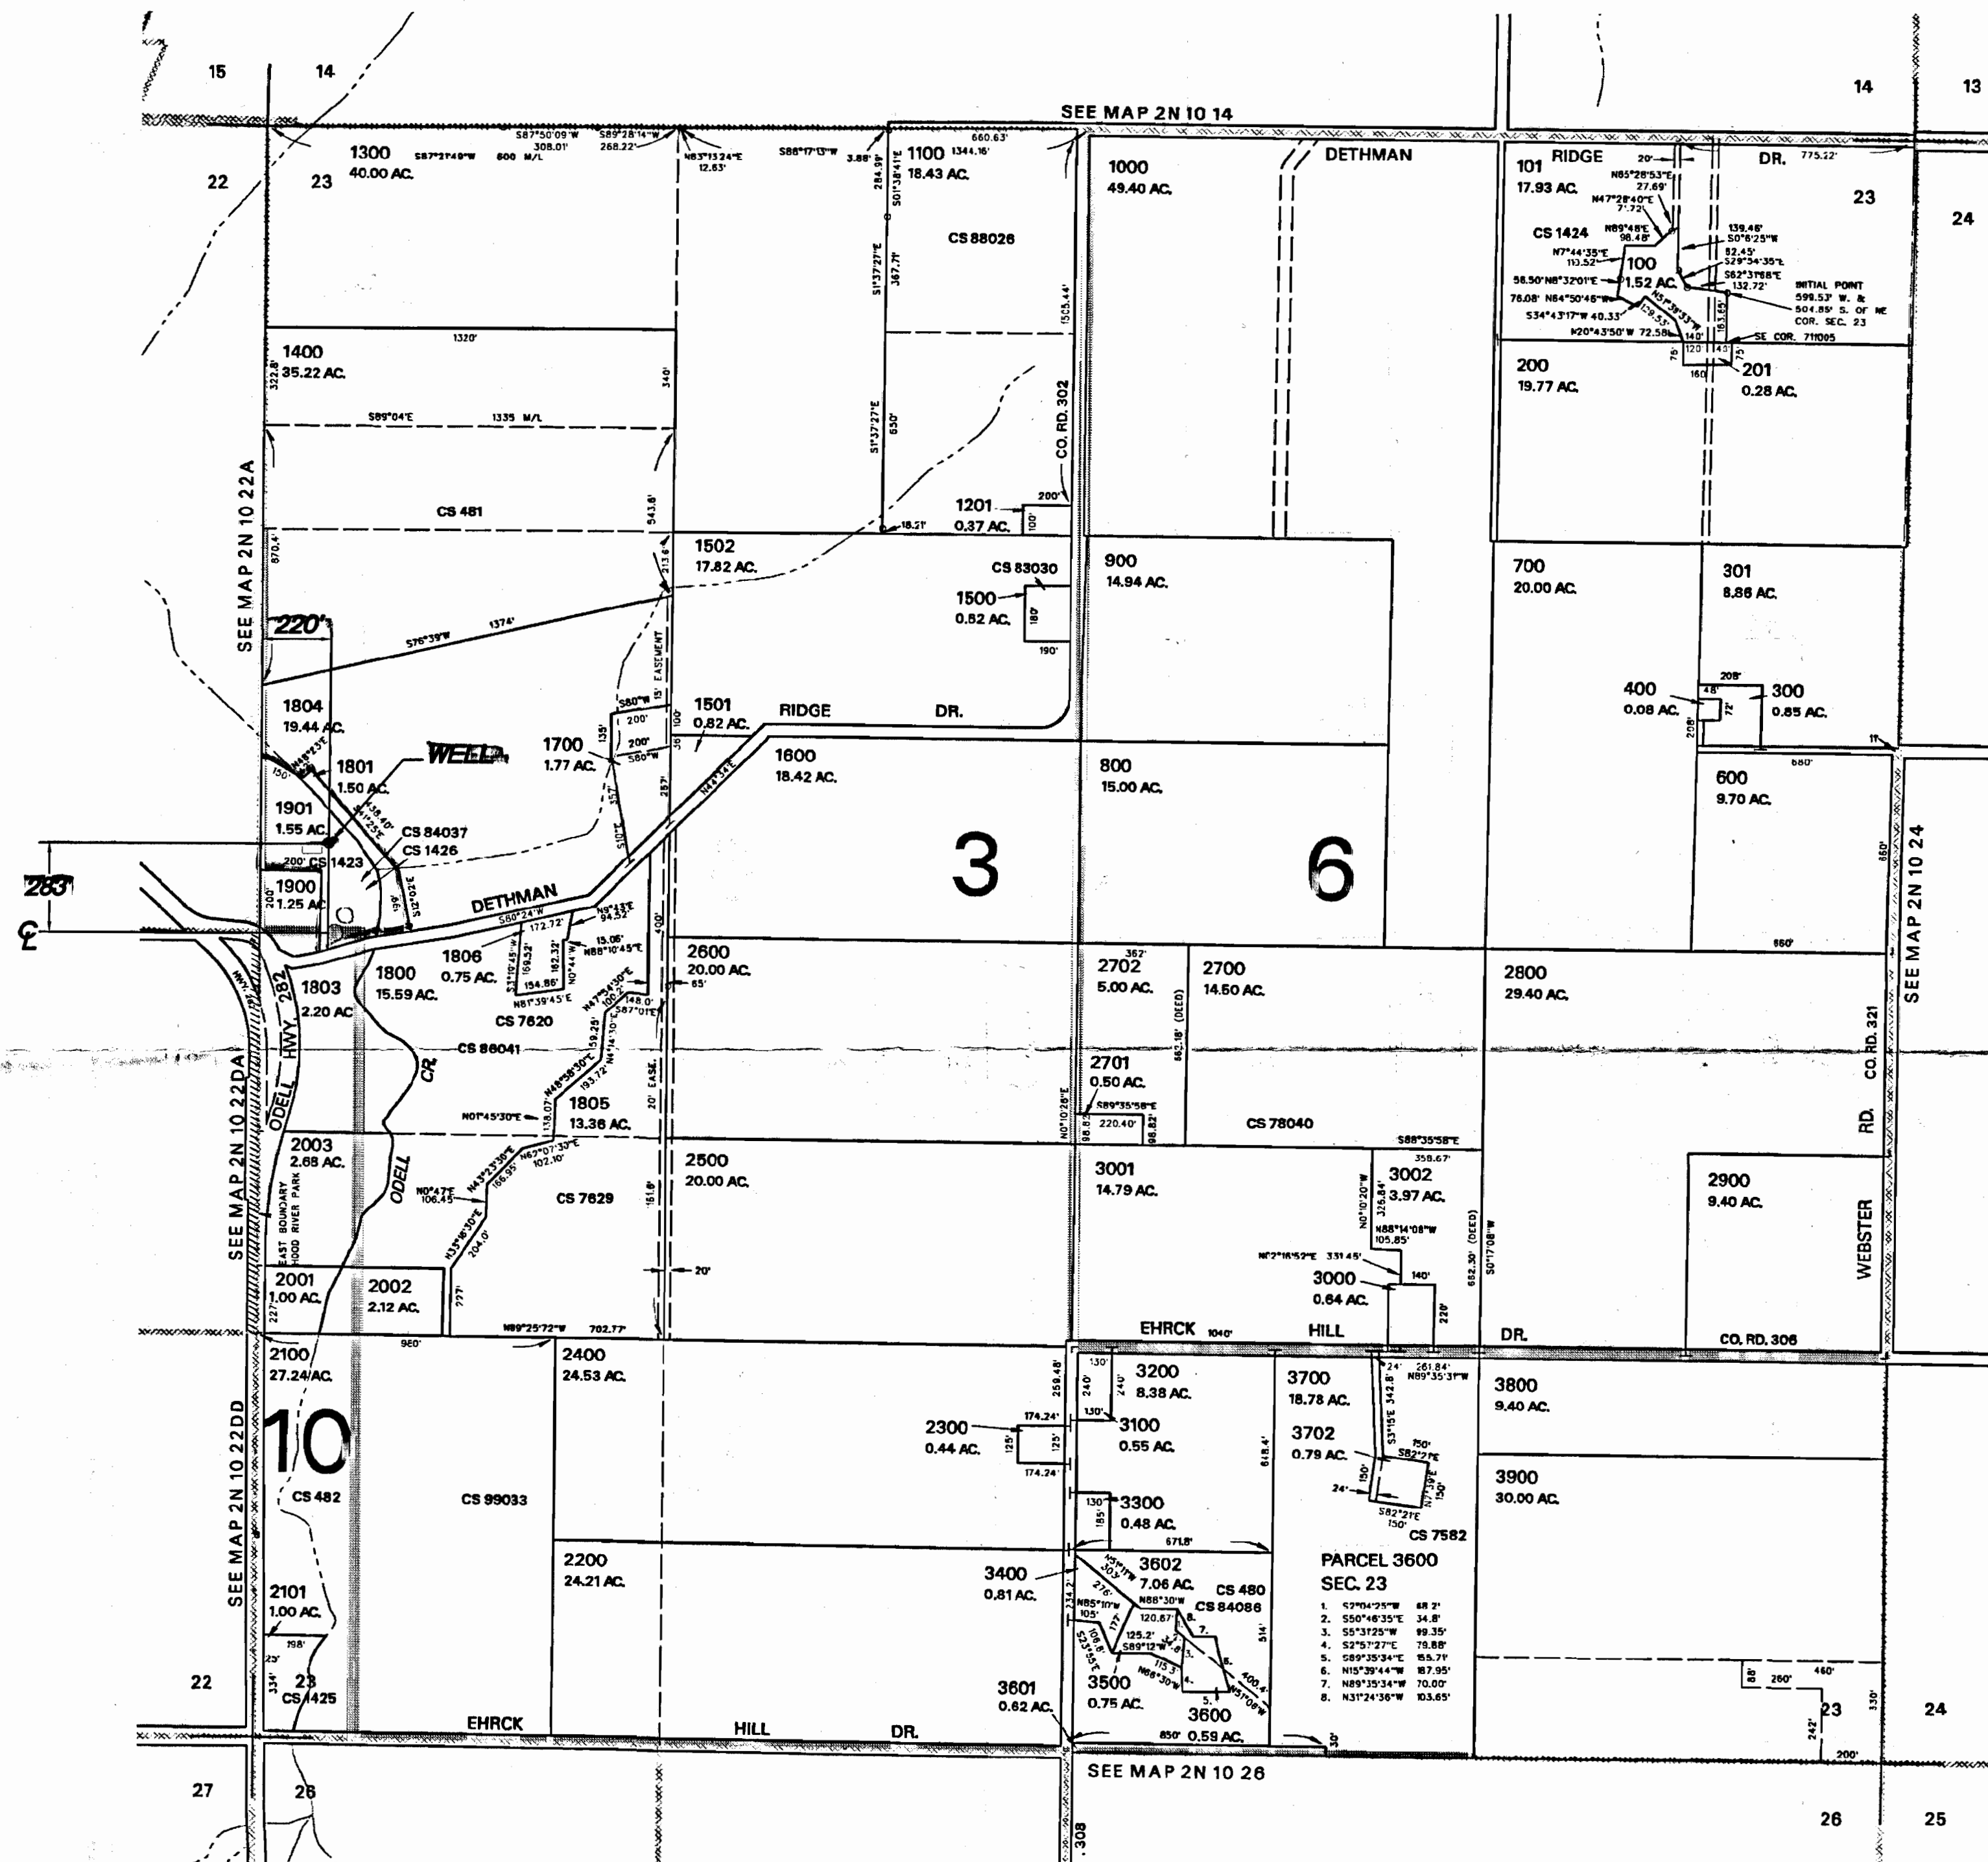

**NOTE:**  
THIS MAP IS NOT INTENDED TO  
PROVIDE LEGAL DIMENSIONS OR  
LOCATIONS OF PROPERTY  
OWNERSHIP LINES.

REVISED: JD  
11/19/02

2N 10 23



**WELL LOCATION MAP**  
SCALE: 1" = 400'

RECEIVED  
SEP 10 2007  
WATER RESOURCES DEPT  
SALEM, OREGON

BAR IS ONE INCH ON  
ORIGINAL DRAWING.  
ADJUST SCALE  
AS SHOWN  
ACCORDINGLY.

REV.	DESCRIPTION	REVISED BY	DATE

REVISIONS

CURRAN-McLEOD, INC.  
CONSULTING ENGINEERS

6655 SW. HAMPTON ST., SUITE 210  
PORTLAND, OREGON 97223  
PHONE (503) 684-3478

ODELL SANITARY DISTRICT

WELL LOCATION MAP  
WASTEWATER TREATMENT FACILITY IMPROVEMENTS  
HOOD RIVER COUNTY, OREGON

JULY 2007  
1436

Appno G-16925

1  
OF  
1