


T13S, R1W, Sec. 13

tax lot 140

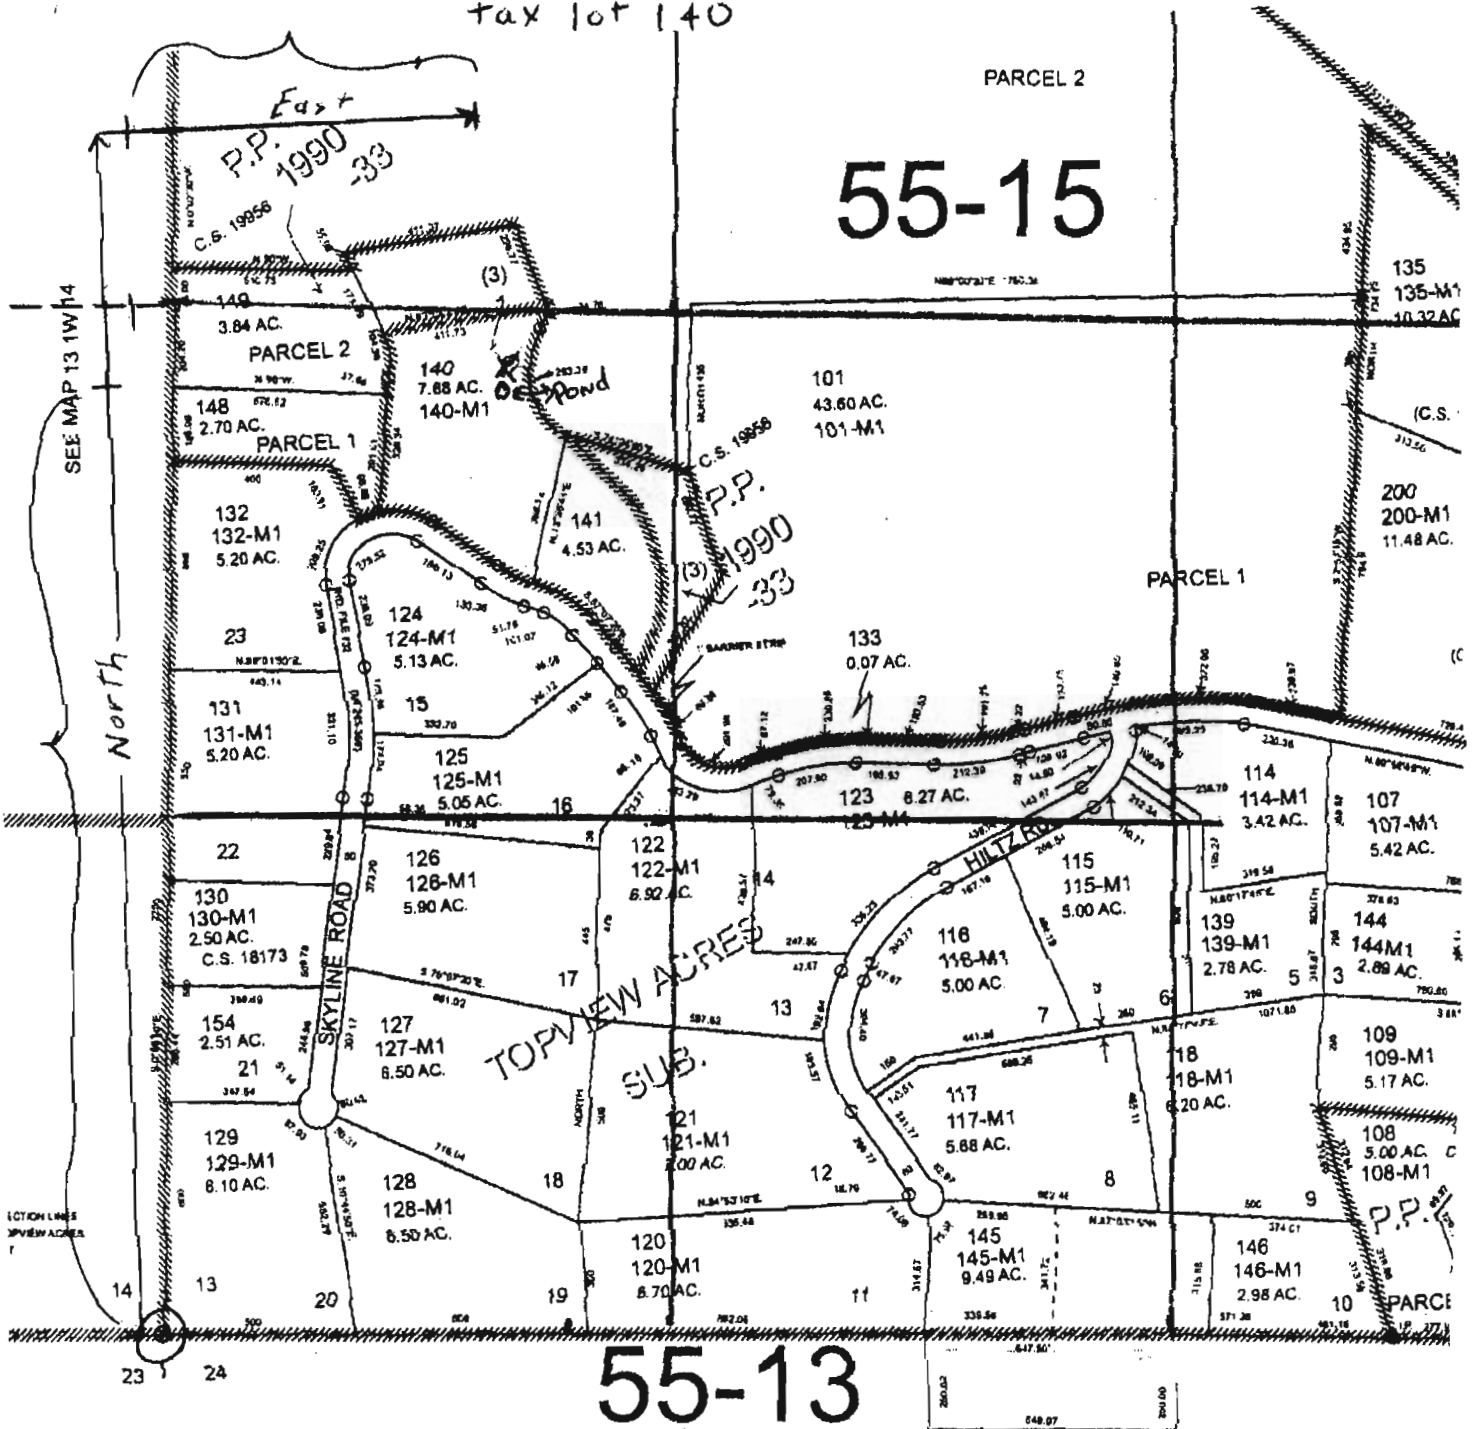

Pond in NW 1/4, SW 1/4 Sec 13

2,200 ft. North and 4000 ft. East from SW Corner

RECEIVED

FEB 26 2010

WATER RESOURCES DEPT
SALEM, OREGON

1" = 500'