


T. 5 S., R. 21 E., W. M.

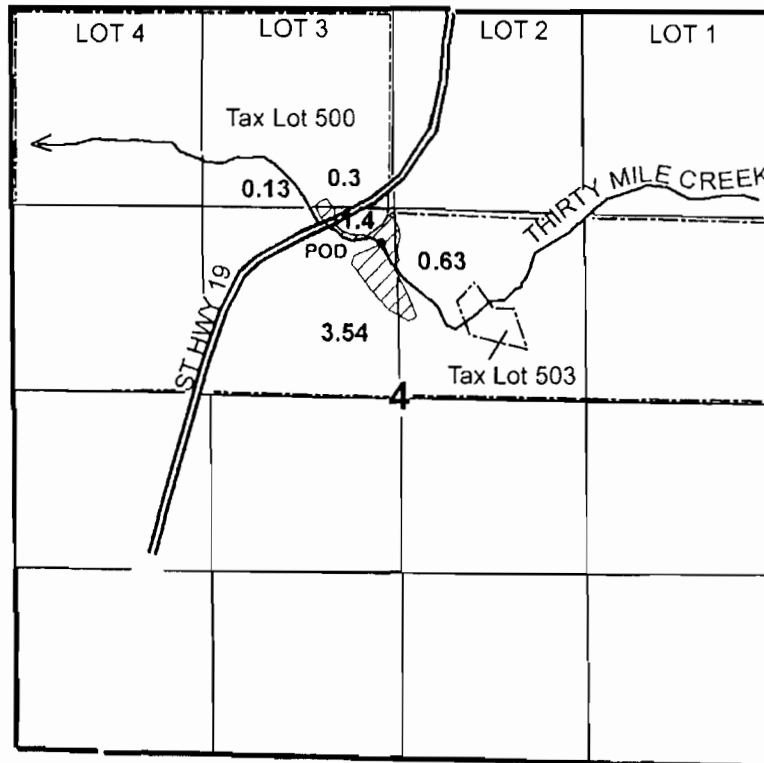

1 inch = 1,320 feet

POD 1710' S., & 110' W. from N $\frac{1}{4}$ Corner, Section 4.
LAT.= N. 45.16527° LONG.= W. -120.20646°

Legend


	irrigation abandoned	1.7 acres
	irrigation	4.3 acres

WATER RIGHT RESURVEY AND MAPPING
(CLARIFICATION OF WATER RIGHT)
UNDER
Permit 23130

IN THE NAME OF
ARTHUR D. HARDIE, REVOCABLE TRUST
% DONNA HARDIE

Surveyed 10/15/2009 By J. Miller

T. 5 S., R. 21 E., W. M.

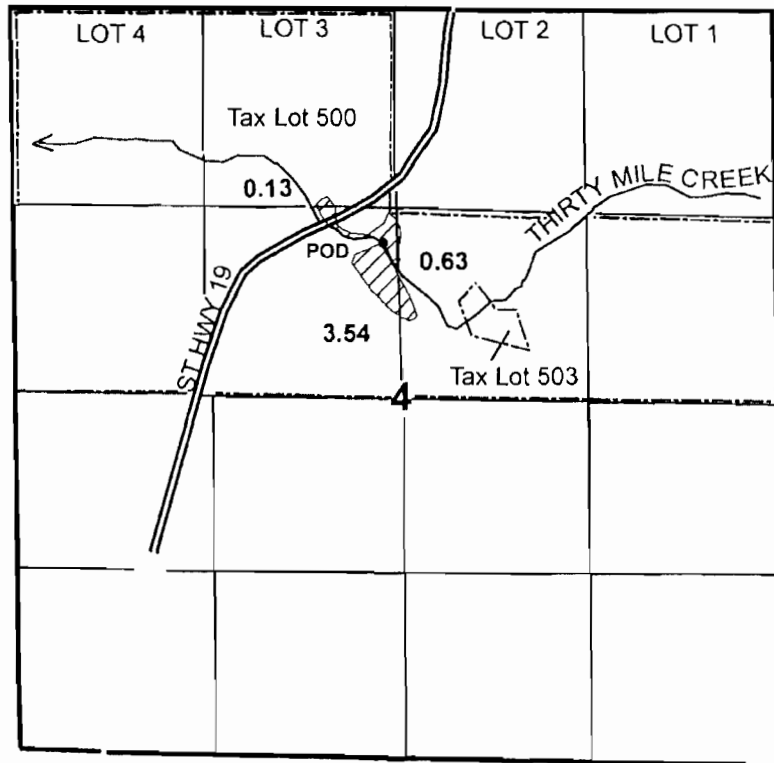

1 inch = 1,320 feet

POD 1710' S., & 110' W. from N $\frac{1}{4}$ Corner, Section 4.
LAT.= N. 45.16527° LONG.= W. -120.20646°

Legend

 irrigation 4.3 acres

WATER RIGHT RESURVEY AND MAPPING
(CLARIFICATION OF WATER RIGHT)
UNDER
Permit 23130

IN THE NAME OF
ARTHUR D. HARDIE, REVOCABLE TRUST
% DONNA HARDIE

Surveyed 10/15/2009 By J. Miller