


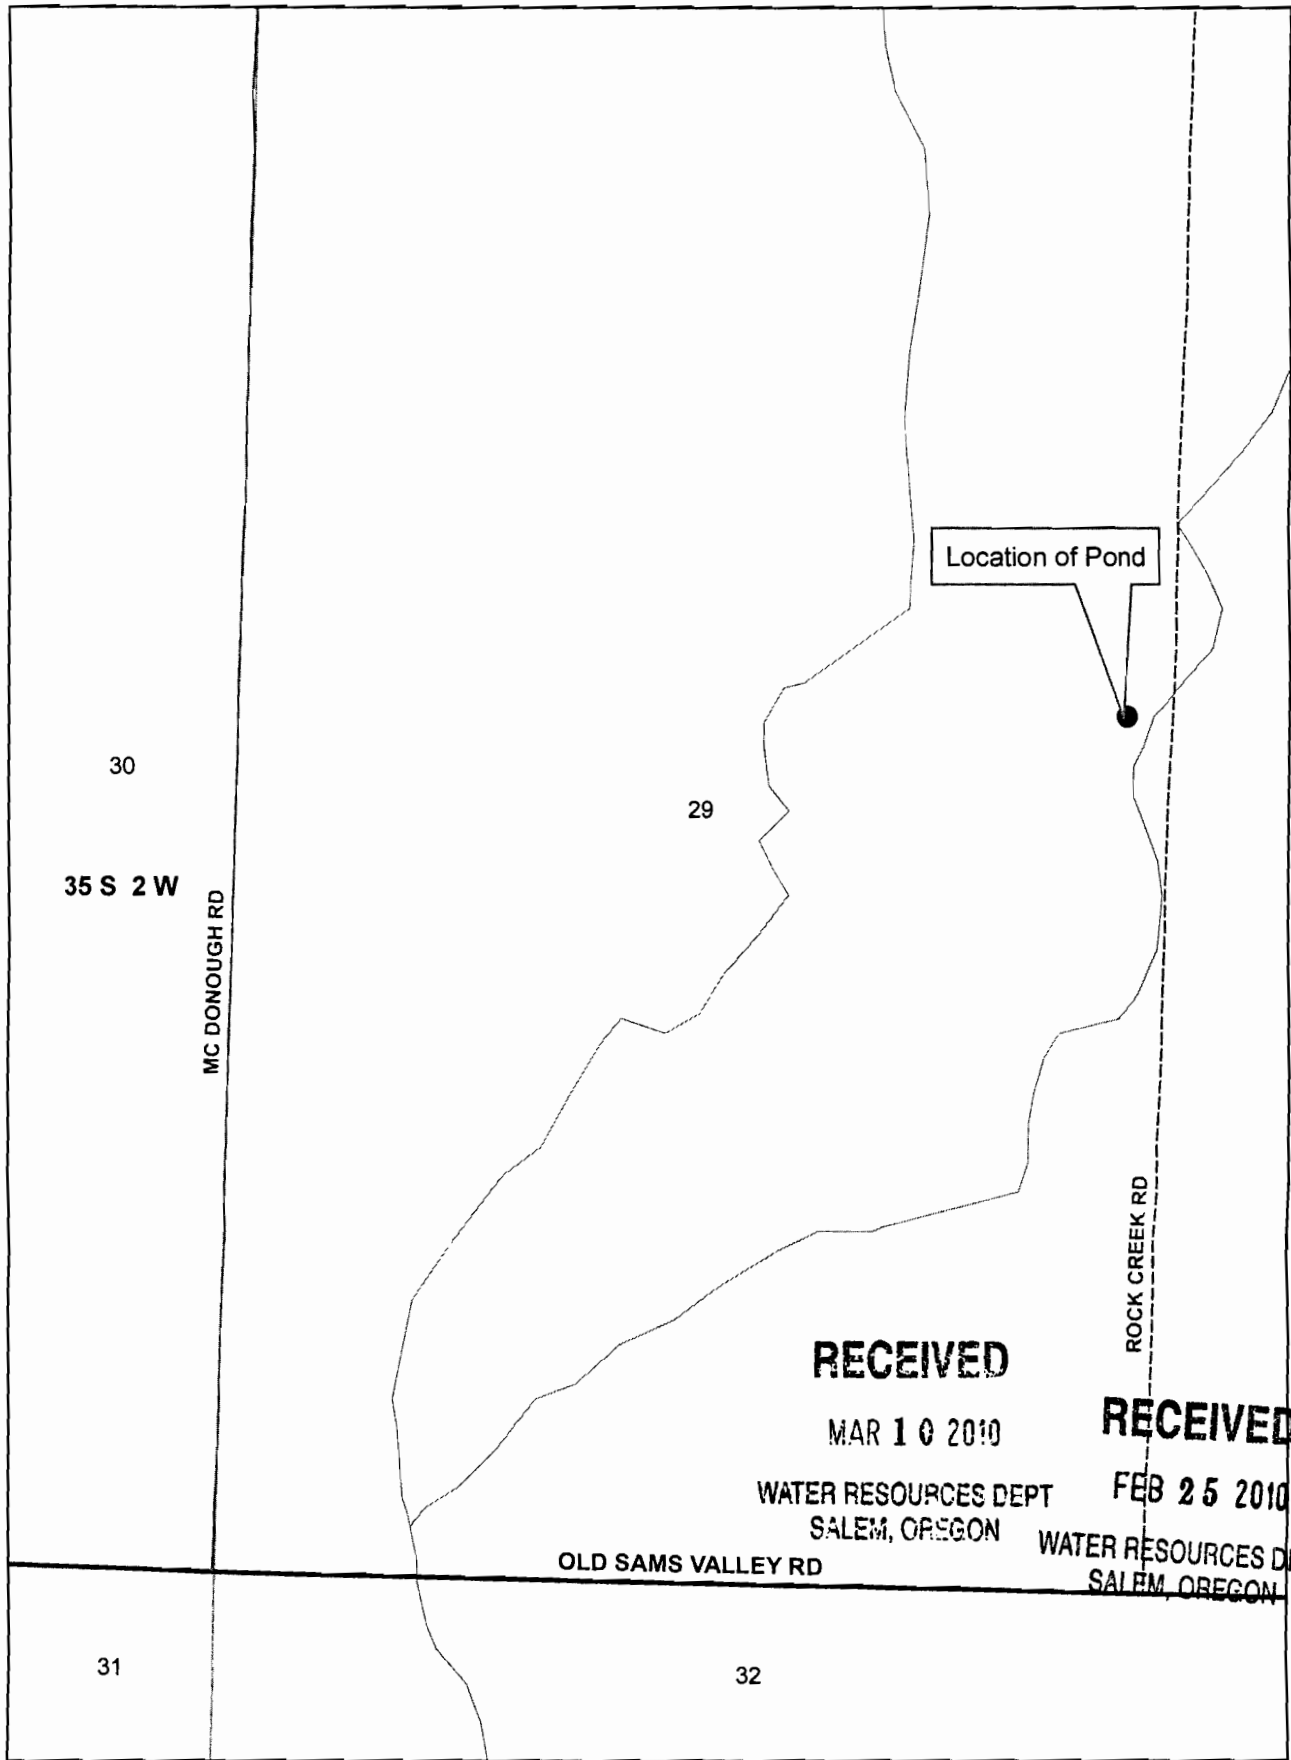

35 S 2 W

MC DONOUGH RD

ROCK CREEK RD

OLD SAMS VALLEY RD

RECEIVED


MAR 10 2010

WATER RESOURCES DEPT
SALEM, OREGON

RECEIVED

FEB 25 2010

WATER RESOURCES DEPT
SALEM, OREGON

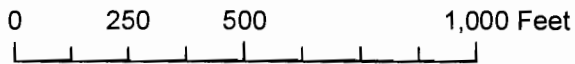

R-87589

Pond is located 1850 ft North
and 1950 Ft East
from the SW corner of Section 29