


SEC.3 T.28S. R.6W. W.M.
DOUGLAS COUNTY
Scale 1" = 200'

RECEIVED

MAR 23 2010

WATER RESOURCES DEPT
SALEM, OREGON

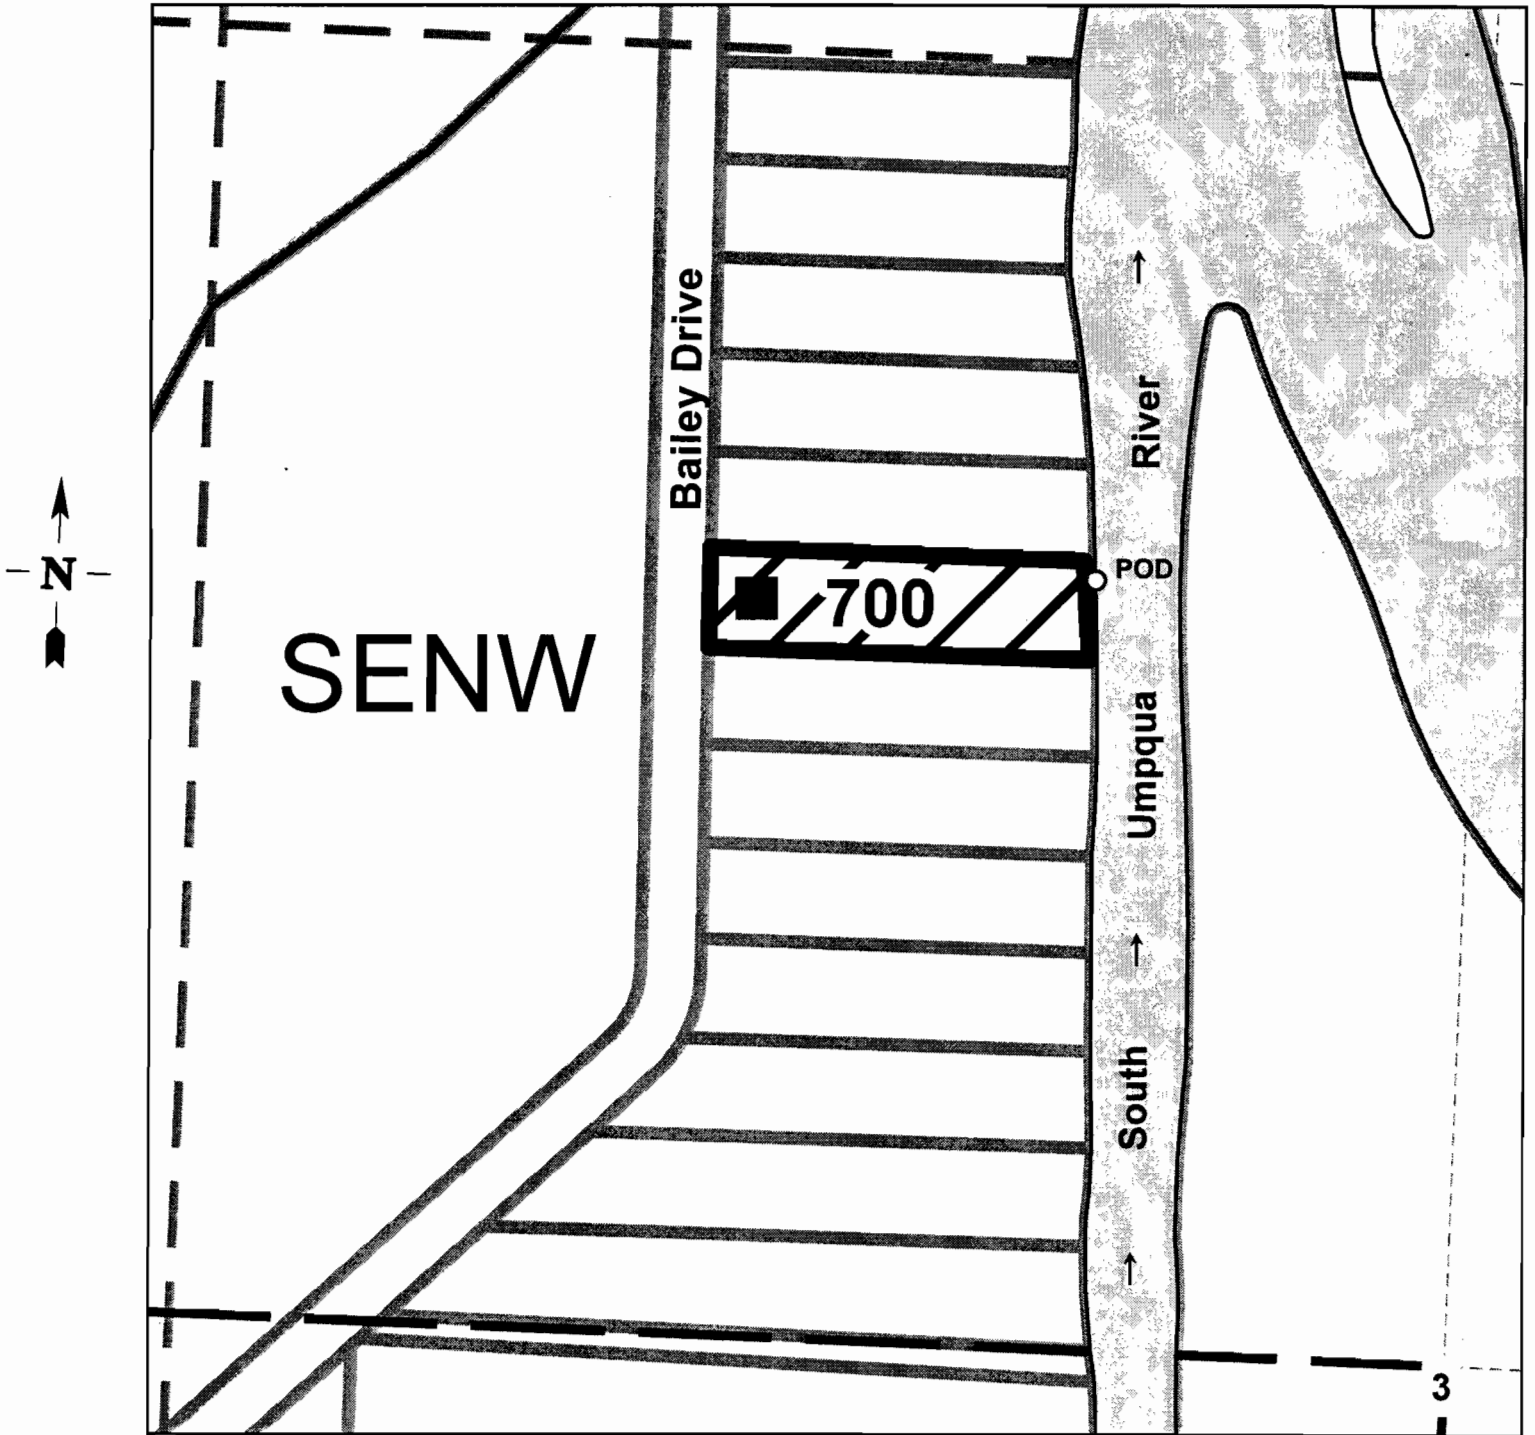

POD: 800 ft. N. and 390 ft. W. from the Center of Sec. 3

S 87594