

STATE ENGINEER
Salem, Oregon

Polk
1566 Well Record

STATE WELL NO. 7/3W40
COUNTY Polk
APPLICATION NO. GR-1790

GR-1732

app-
6-6481

Point G-6103

OWNER: Leonard Kinkaid


MAILING ADDRESS: 3555 River Bend Rd.

LOCATION OF WELL: Owner's No. _____

CITY AND STATE: Salem, Oregon

SW $\frac{1}{4}$ SE $\frac{1}{4}$ Sec. 4 T. 7 S. R. 3 W., W.M.

Bearing and distance from section or subdivision
corner 563' N. & 580' E. from St. cor. Sec. 4

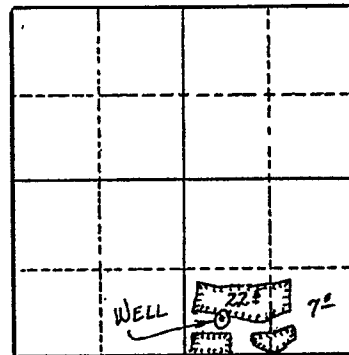

Altitude at well _____

TYPE OF WELL: Drilled Date Constructed 1936

Depth drilled 40' Depth cased 40'

Section 4

CASING RECORD:
8"

FINISH:

AQUIFERS:

WATER LEVEL:
2'

PUMPING EQUIPMENT: Type F. M. Cent. H.P. 10
Capacity 350 G.P.M.

WELL TESTS:
Drawdown 6 ft. after _____ hours 260 G.P.M.
Drawdown _____ ft. after _____ hours _____ G.P.M.


USE OF WATER Irrigation Temp. _____ °F. _____, 19____

SOURCE OF INFORMATION GR Record

DRILLER or DIGGER West Well Drilling

ADDITIONAL DATA:
Log N.A. Water Level Measurements _____ Chemical Analysis _____ Aquifer Test _____

REMARKS:
Irrigation of 29.5 acres.

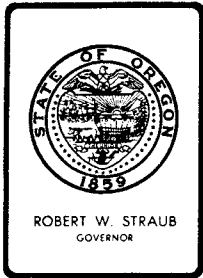

Water Resources Department

MILL CREEK OFFICE PARK

555 13th STREET N.E., SALEM, OREGON 97310

PHONE 378-8508

November 7, 1978

RIVERKAID FARMS, INC.
c/o Leonard Kinkaid
3555 River Bend Road N.W.
Salem, OR 97304

File No. G-6481

Dear Mr. Kinkaid:

Enclosed is the proof of appropriation of water under your water right permit number G-6103.

The data contained in the proof is based on an inspection and survey of your project made by a representative of this office. It defines the extent to which the water right has been completed within the terms of your permit. The proof should be carefully examined, dated and signed and returned to this office.

Upon receipt of the proof and the recording fee of \$2.00, a certificate of water right will be issued confirming the right and, after recording in the county records, will be forwarded to you.

You may keep the map print for your records.

Sincerely,

Bruce A. Estes, Supervisor
Survey-Certificate Section
Water Rights Division


Form 132

Also enclosed is the new application form for filing on the land without water rights on your farm. Please examine the application carefully to see that it is correct. The filing in this form depends on your approval of our survey of permit No. G-6103. The new form, when returned, requires your signature and a \$30.00 filing fee.

Larry M. Toll *LMT*
Water Rights Engineer



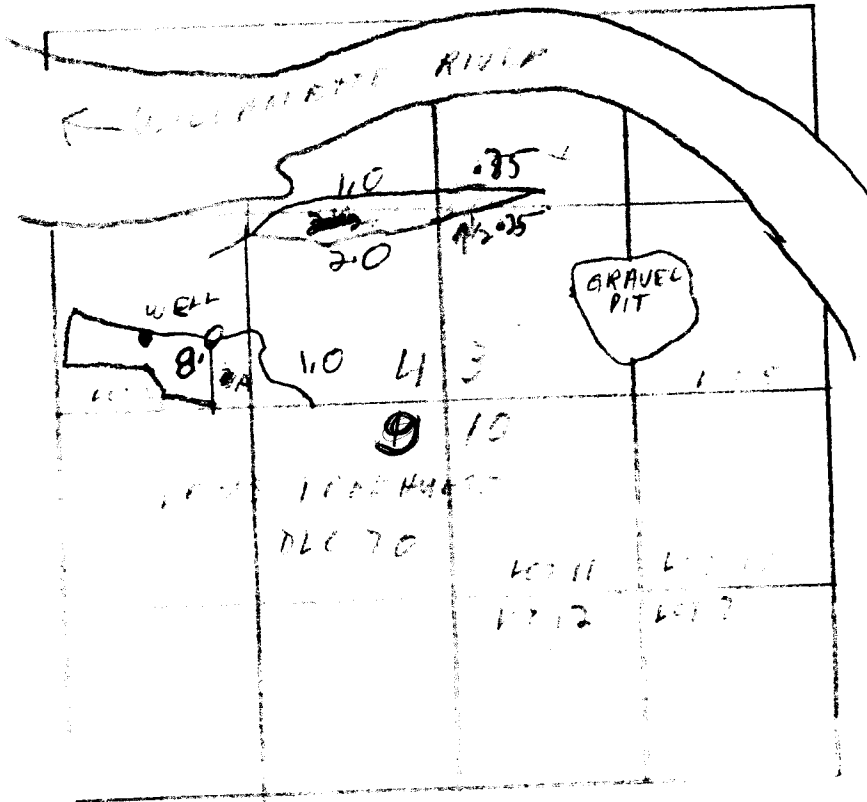

GRAVEL PIT DIVERSION
650' N + 50' E FROM THE S.E. CORNER
OF CORNER SW 1/4 SW 1/4 SEC 3 T 75 N R 11 W

WELL LOCATED 563' N + 580' E FROM S 1/4
CORNER SECTION 4 BEING WITHIN S W 1/4 SEC 4
SEC 4 TWP 75 N R 11 W

SCALE 4" EQUAL 1 MILE.

Application No. G 6481

Permit No. G 6103

Field Copy

June 16, 1994

FABERS RIVERBEND HOLSTEINS
3551 RIVERBEND ROAD NW
SALEM OR 97304

RE: USER-ID # 25912

With regard to the pump test requirements for the following well and its associated water right:

<u>POD-ID</u>	<u>Well</u>	<u>Application</u>	<u>Permit</u>	<u>Certificate</u>	<u>Status</u>
27794	Gravel Pit	G-6481	G-6103	47082	Exempt

The Water Resources Department has reviewed your request for an exemption from the pump test requirement. In your letter you indicate that your well is a gravel pit and cannot be tested.

Your request for an exemption is hereby granted. This exemption applies only to the well associated with the above water right.

We appreciate your cooperation in this program. If you have any questions, please contact Mike Zwart or Bill Ferber at the address below or by calling 378-8455.

Sincerely,

FRED LISSNER, Manager
Groundwater/Hydrology Section

cc: Water Rights Section

3425W

May 6, 1974

G-6481

Riverkaid Farm, Inc.
3555 River Bend Rd., N.W.
Salem, OR 97304

Gentlemen:

Your application for a permit to appropriate .16 cubic foot of water per second being .08 cubic foot of water per second from a pit and .08 cubic foot of water per second from a well for the irrigation of 13 acres has been received. We have also received a reproducible map, and the fees of \$25.00. Our receipt numbered 39265 was handed to you.

Your application has been filed as number G-6481 and is in satisfactory form for approval by the issuance of a permit.

Very truly yours,

THOMAS E. SHOOK
Assistant

TES: cdp