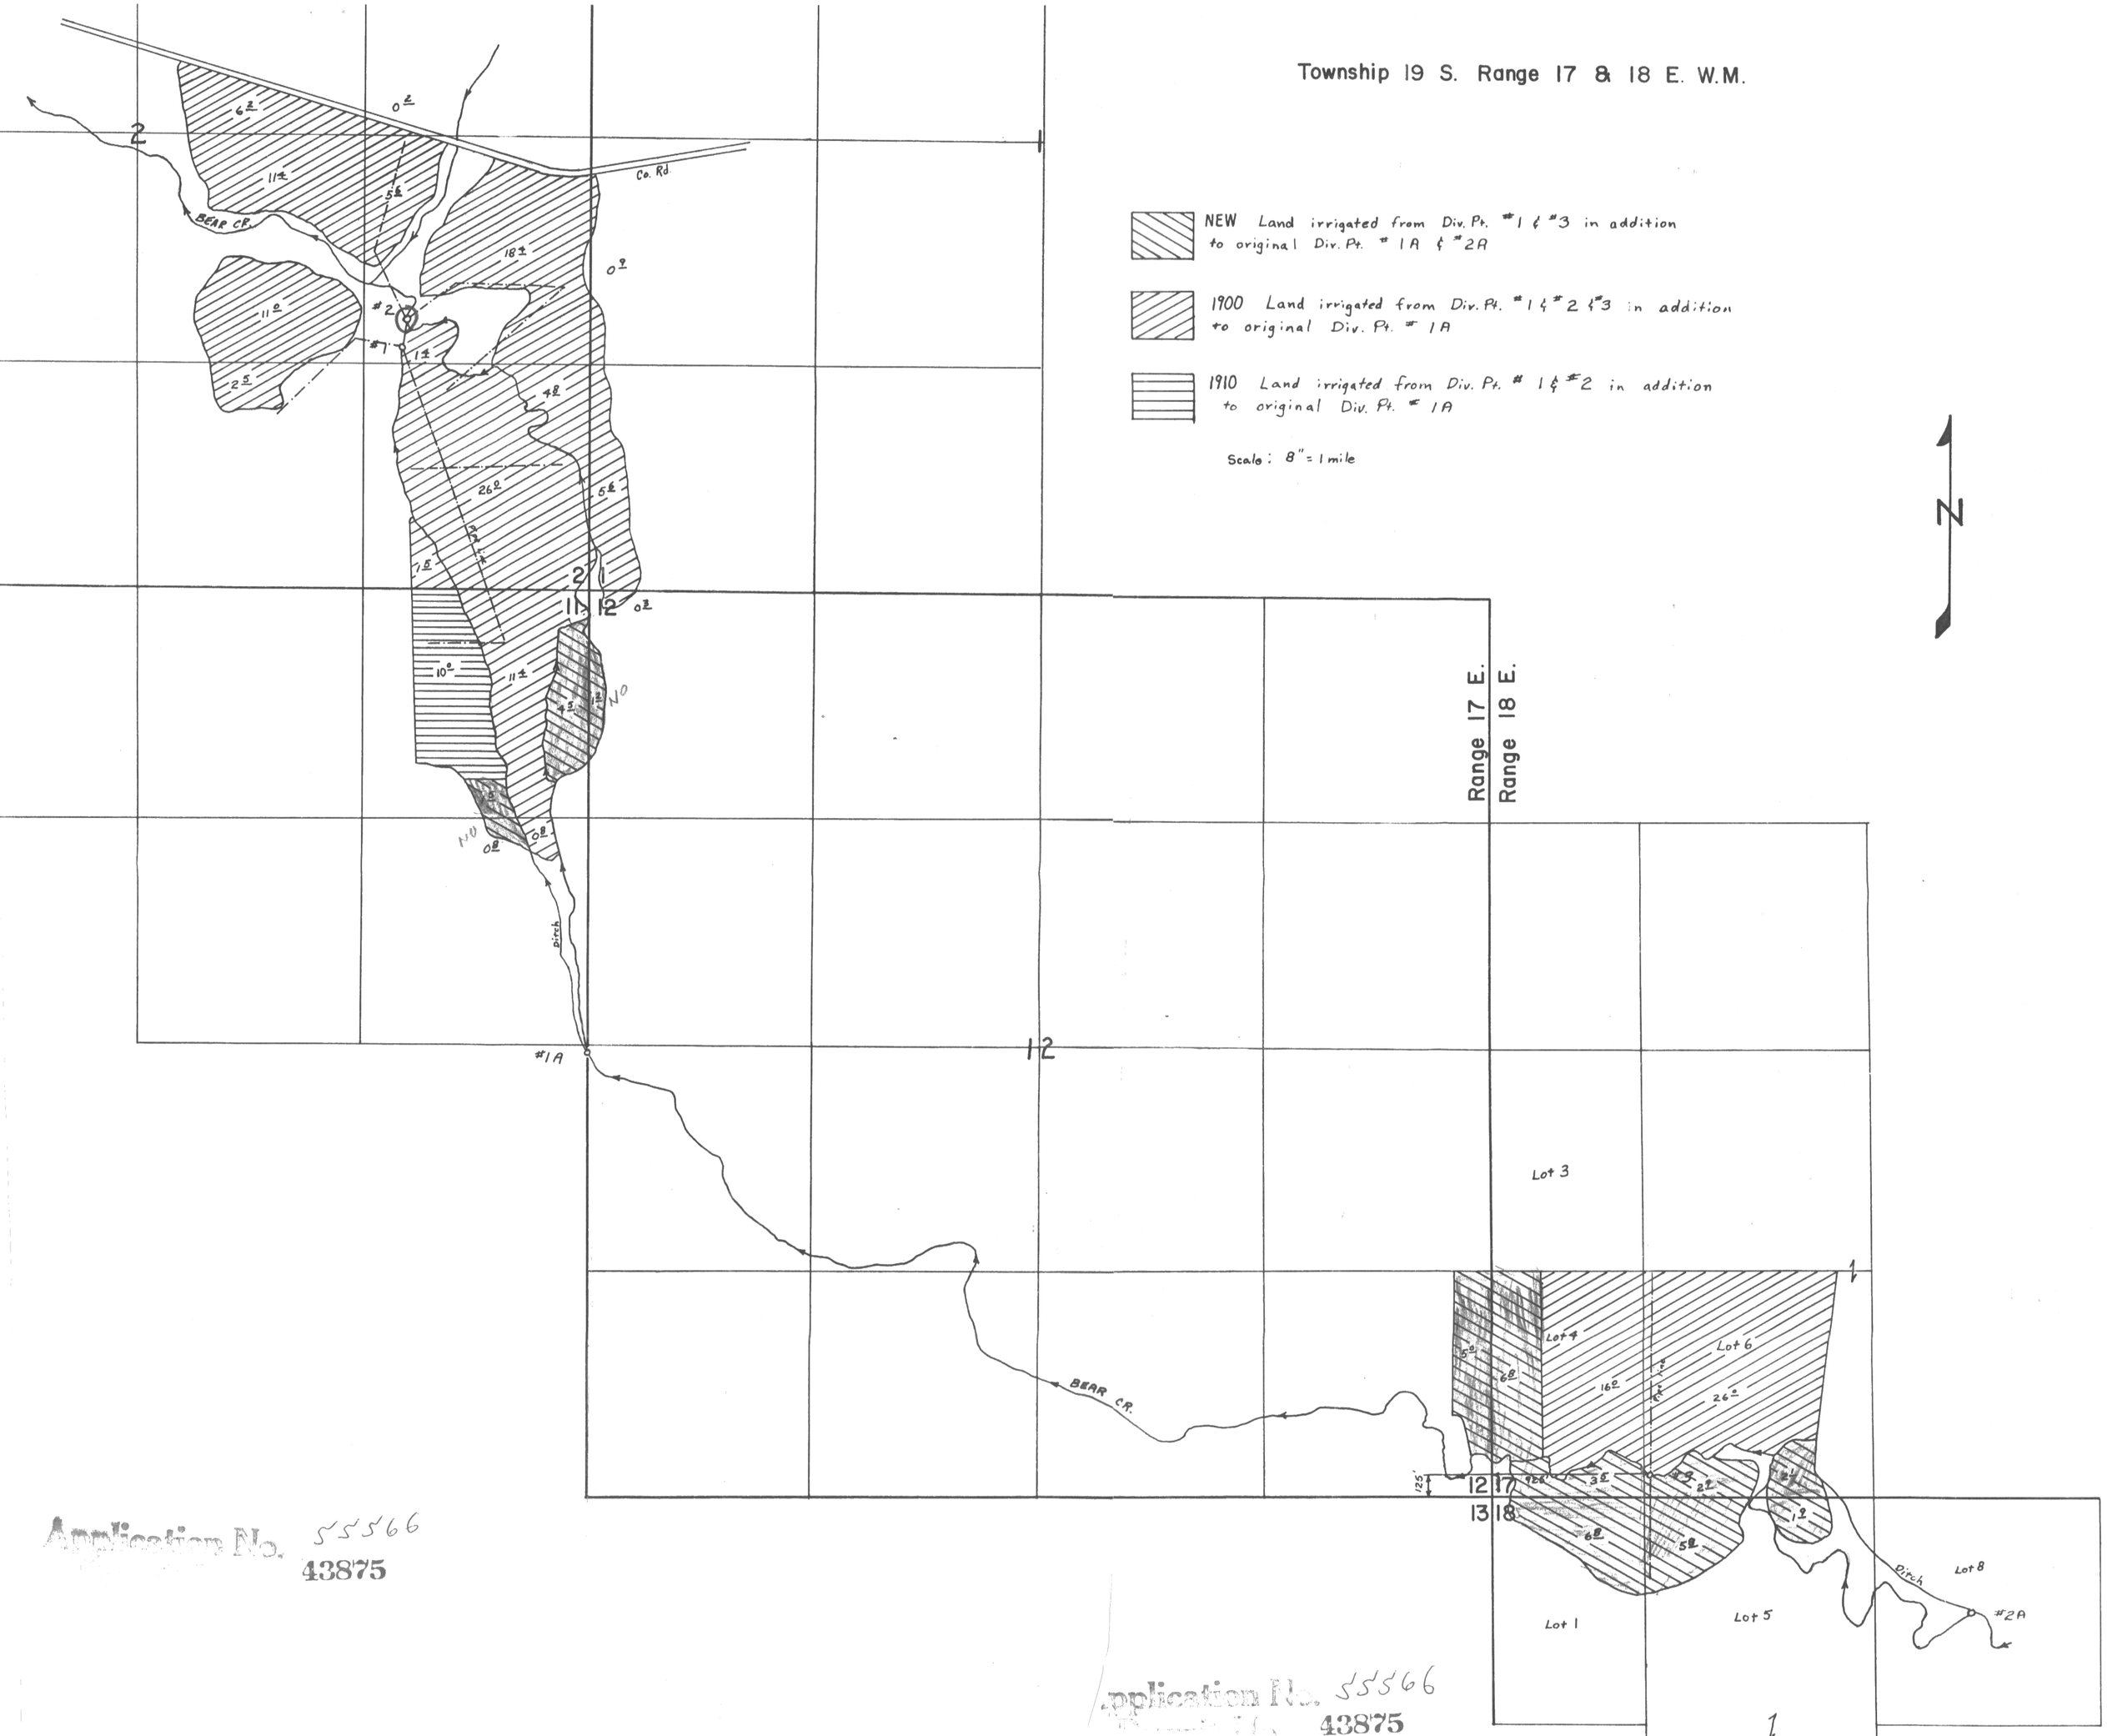

Application No. 55566
43875

Application No. 55566
43875