

RECEIVED

MAR 23 1987

WATER RESOURCES DEPT  
SALEM, OREGON


G10836

Low Inflow  
Thresh  
Adlow

25

36

379 225  
T4W  
T3N

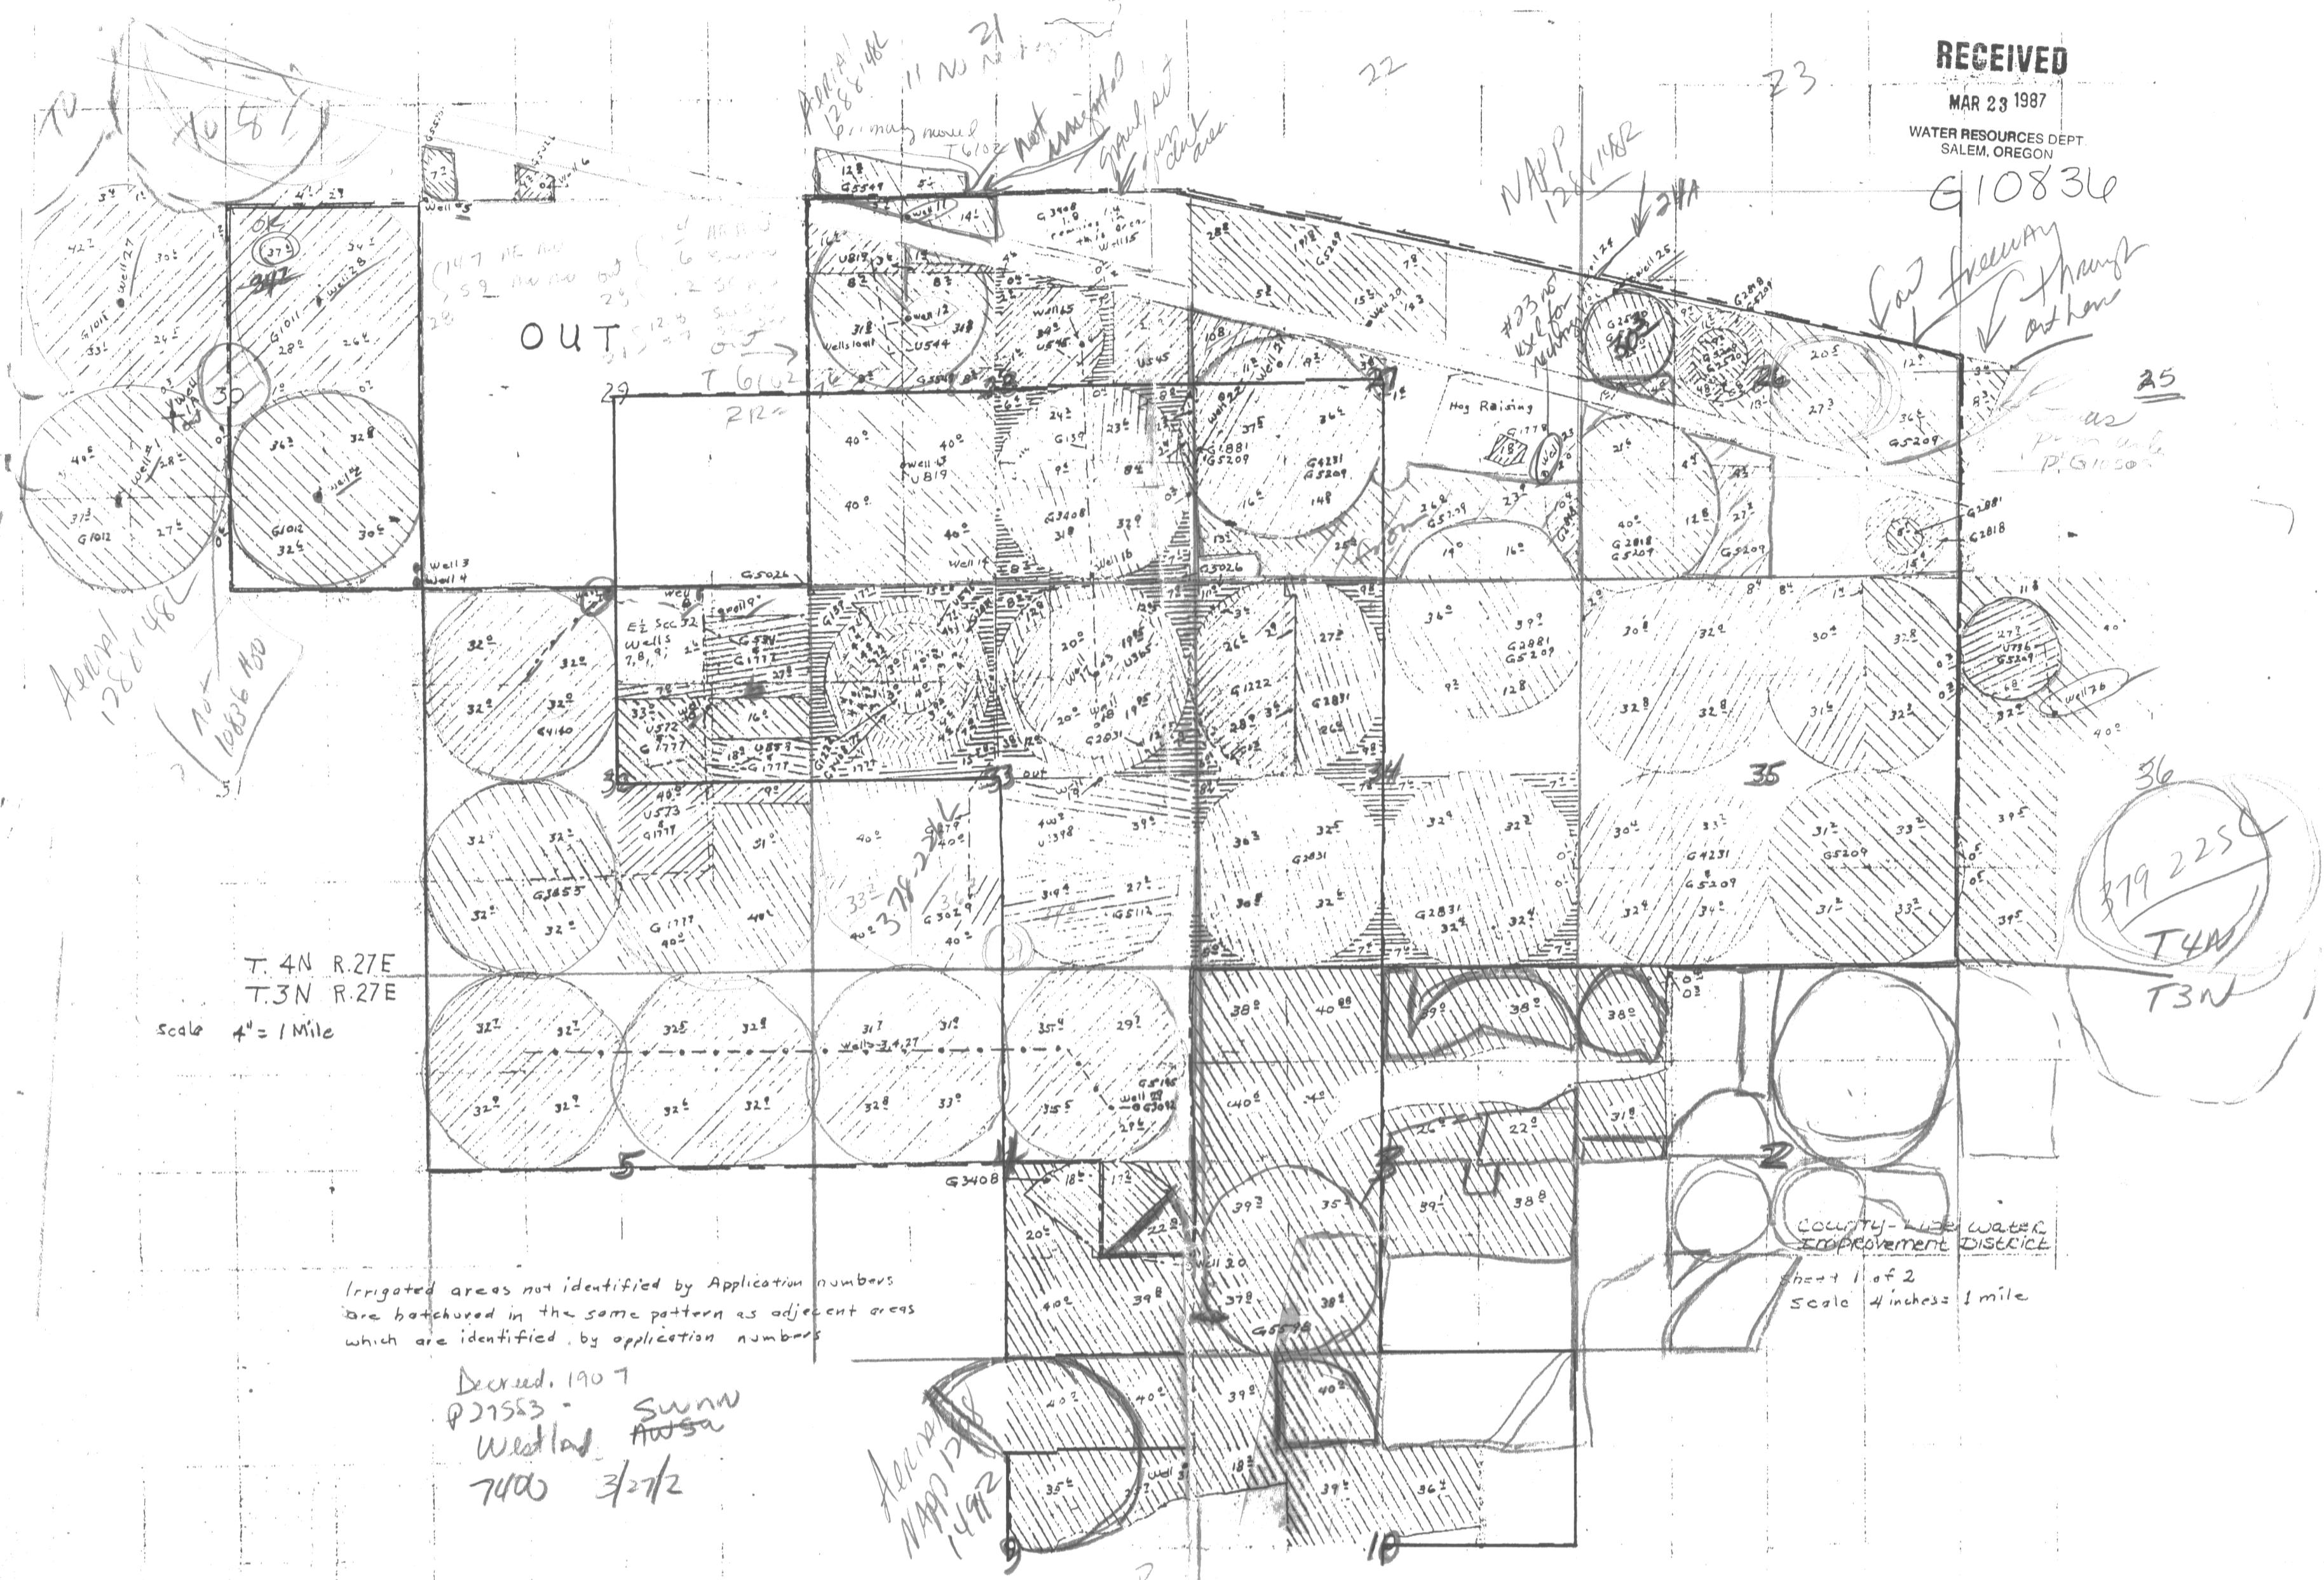

OUT

T. 4N R. 27E  
T. 3N R. 27E

Scale 4" = 1 Mile

Irrigated areas not identified by Application numbers  
are hatched in the same pattern as adjacent areas  
which are identified by application numbers

Dated 1907  
P29583 - Sunn  
Westland Area  
7400 3/7/2

Area  
MAP 128  
1492

378-1562

See  
PG 10451 263

4105  
4105  
4121