


T3S R30E W UMATILLA COL


SCALE 1" = 1000 FT.

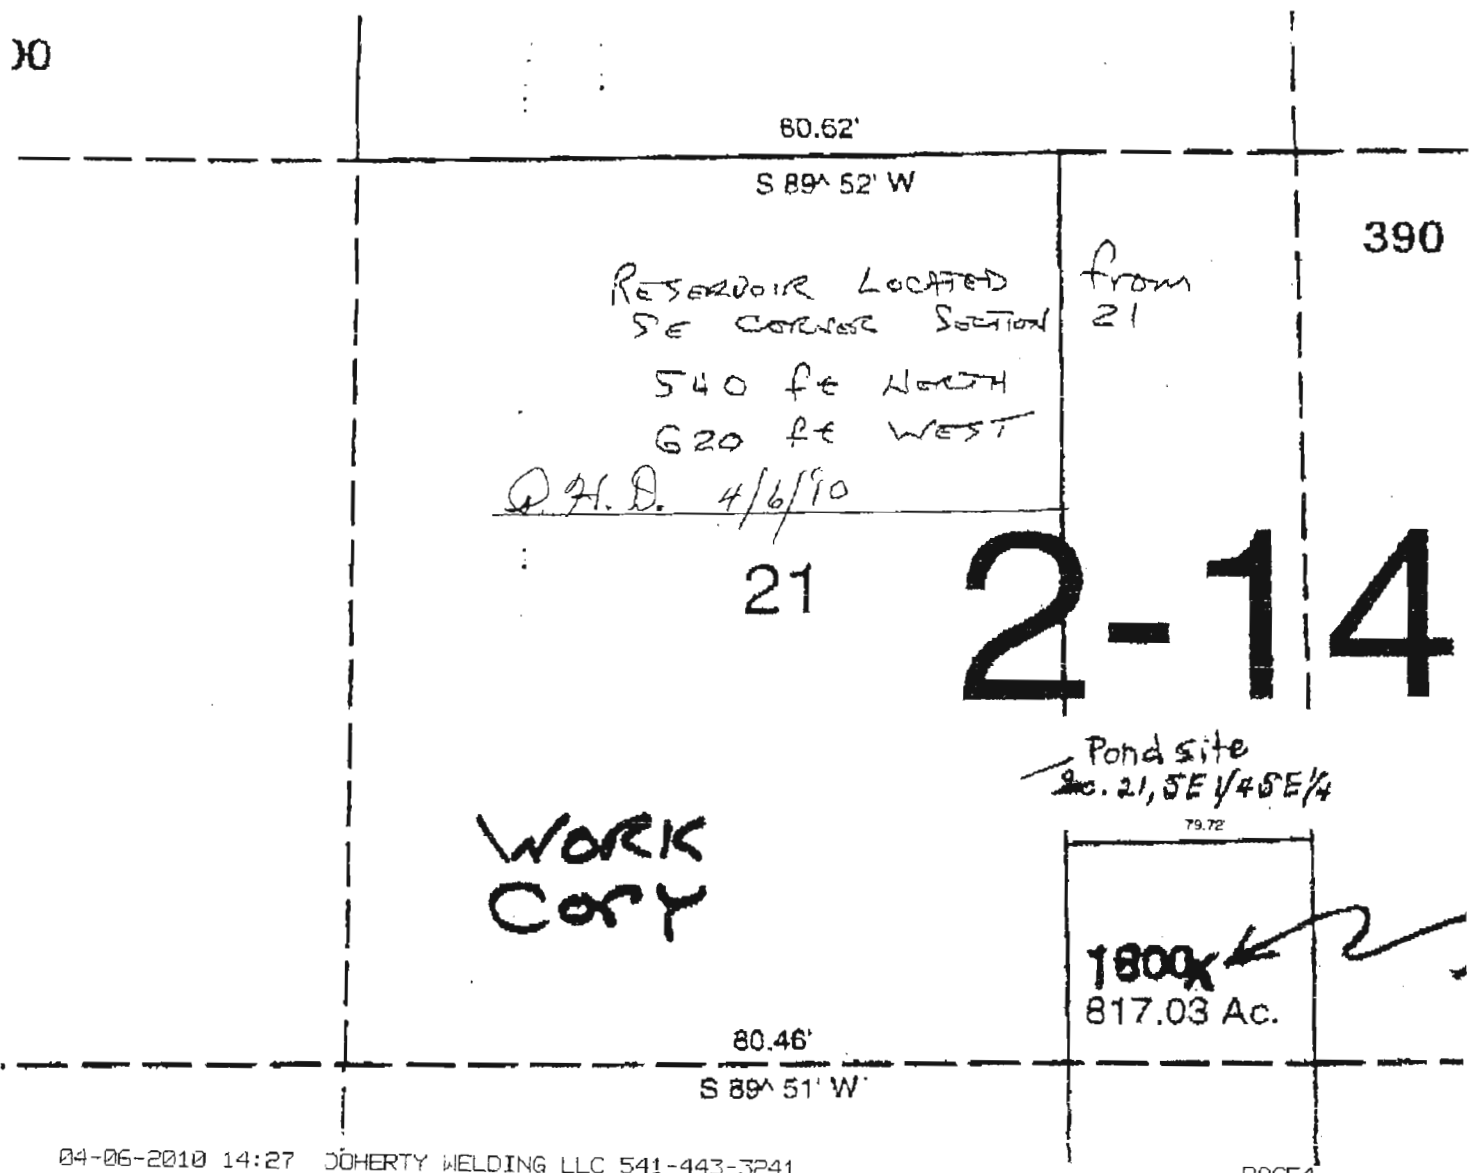



T3S R30E WM UMATILLA COUNTY

SCALE 1" = 2000'

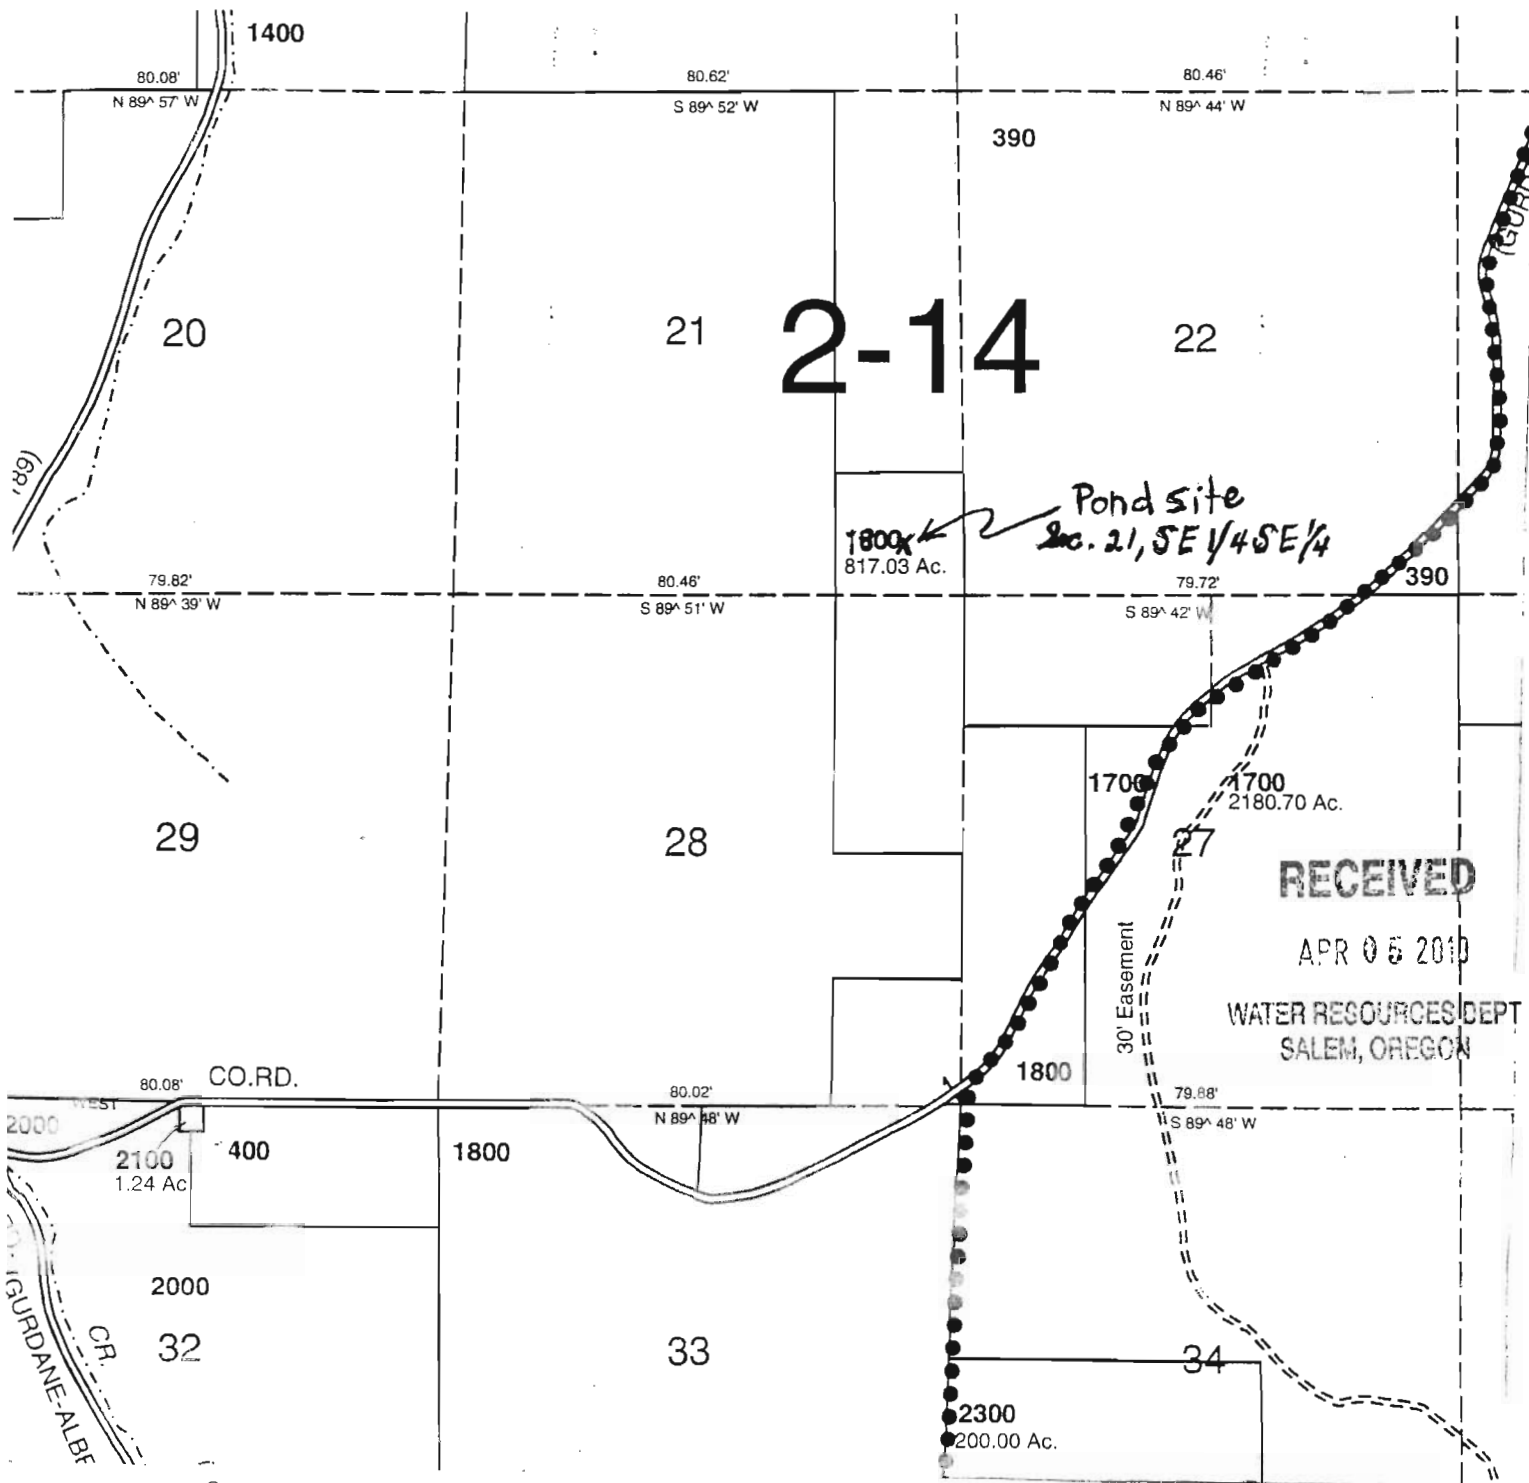

↑
North
R-87596

T3S R30E W UMATILLA COL

SCALE 1" = 1000 FT.

