

Bent

WATERMASTER DIVISION 33 APPLICATION WORK SHEET #16

Recommendations for Water Right Applications that may affect the Habitat of Sensitive, Threatened or Endangered Fish Species, OAR 690-33-310 through 340.

Please return by: August 8, 2002

Application # G-15752

Name: Wells Fargo Bank

SOURCE OF WATER: GROUNDWATER SURFACE WATER STORAGE

DESCRIPTION OF THE SOURCE: well #4
(A spring, well, sump, exempt pond, unnamed stream, etc.)

1) If from surface water, does the water at the proposed diversion location flow into another water body? N/A
 YES NO SOMETIMES

If sometimes, describe the time period, Between: _____ and _____.

2) Does the source ever go dry in the area of the proposed diversion?
 YES NO, not to my knowledge

3) To your knowledge, has the requested source of water been regulated because of insufficient flow to satisfy existing water rights including instream water rights?
 YES NO

If YES, please explain: _____

4) Do you agree with the period water is found to be available? N/A
 YES NO I DON'T KNOW

If NO, what period do you recommend and why: _____

5) Did you meet with staff from another agency to discuss this application? No
 YES NO

Who: _____ Agency: _____ Date: _____


6) Is mitigation an option?
 YES NO

If YES, please explain: _____


Comments: Can well be constructed to not impact Mountain View Creek? Site inspection 8.6.2002 found flow at 99 & Mountain View Rd crossings. Pools @ Lewisburg Rd crossing but no indication of flow. 1st unnamed drainage along Pettibone dry. Neighbor said unnamed drainage begins to flow around Nov 3 steps in Aug.

Name: Bill Felton Date: 8.7.2002 Title: WR #16

WRD Contact: Caseworker: Russell W. Klassen, Water Rights Division
503-378-8455 ext: 266 / Fax: 503-378-6203 / e-mail: Russell.W.KLASSEN@ wrd.state.or.us

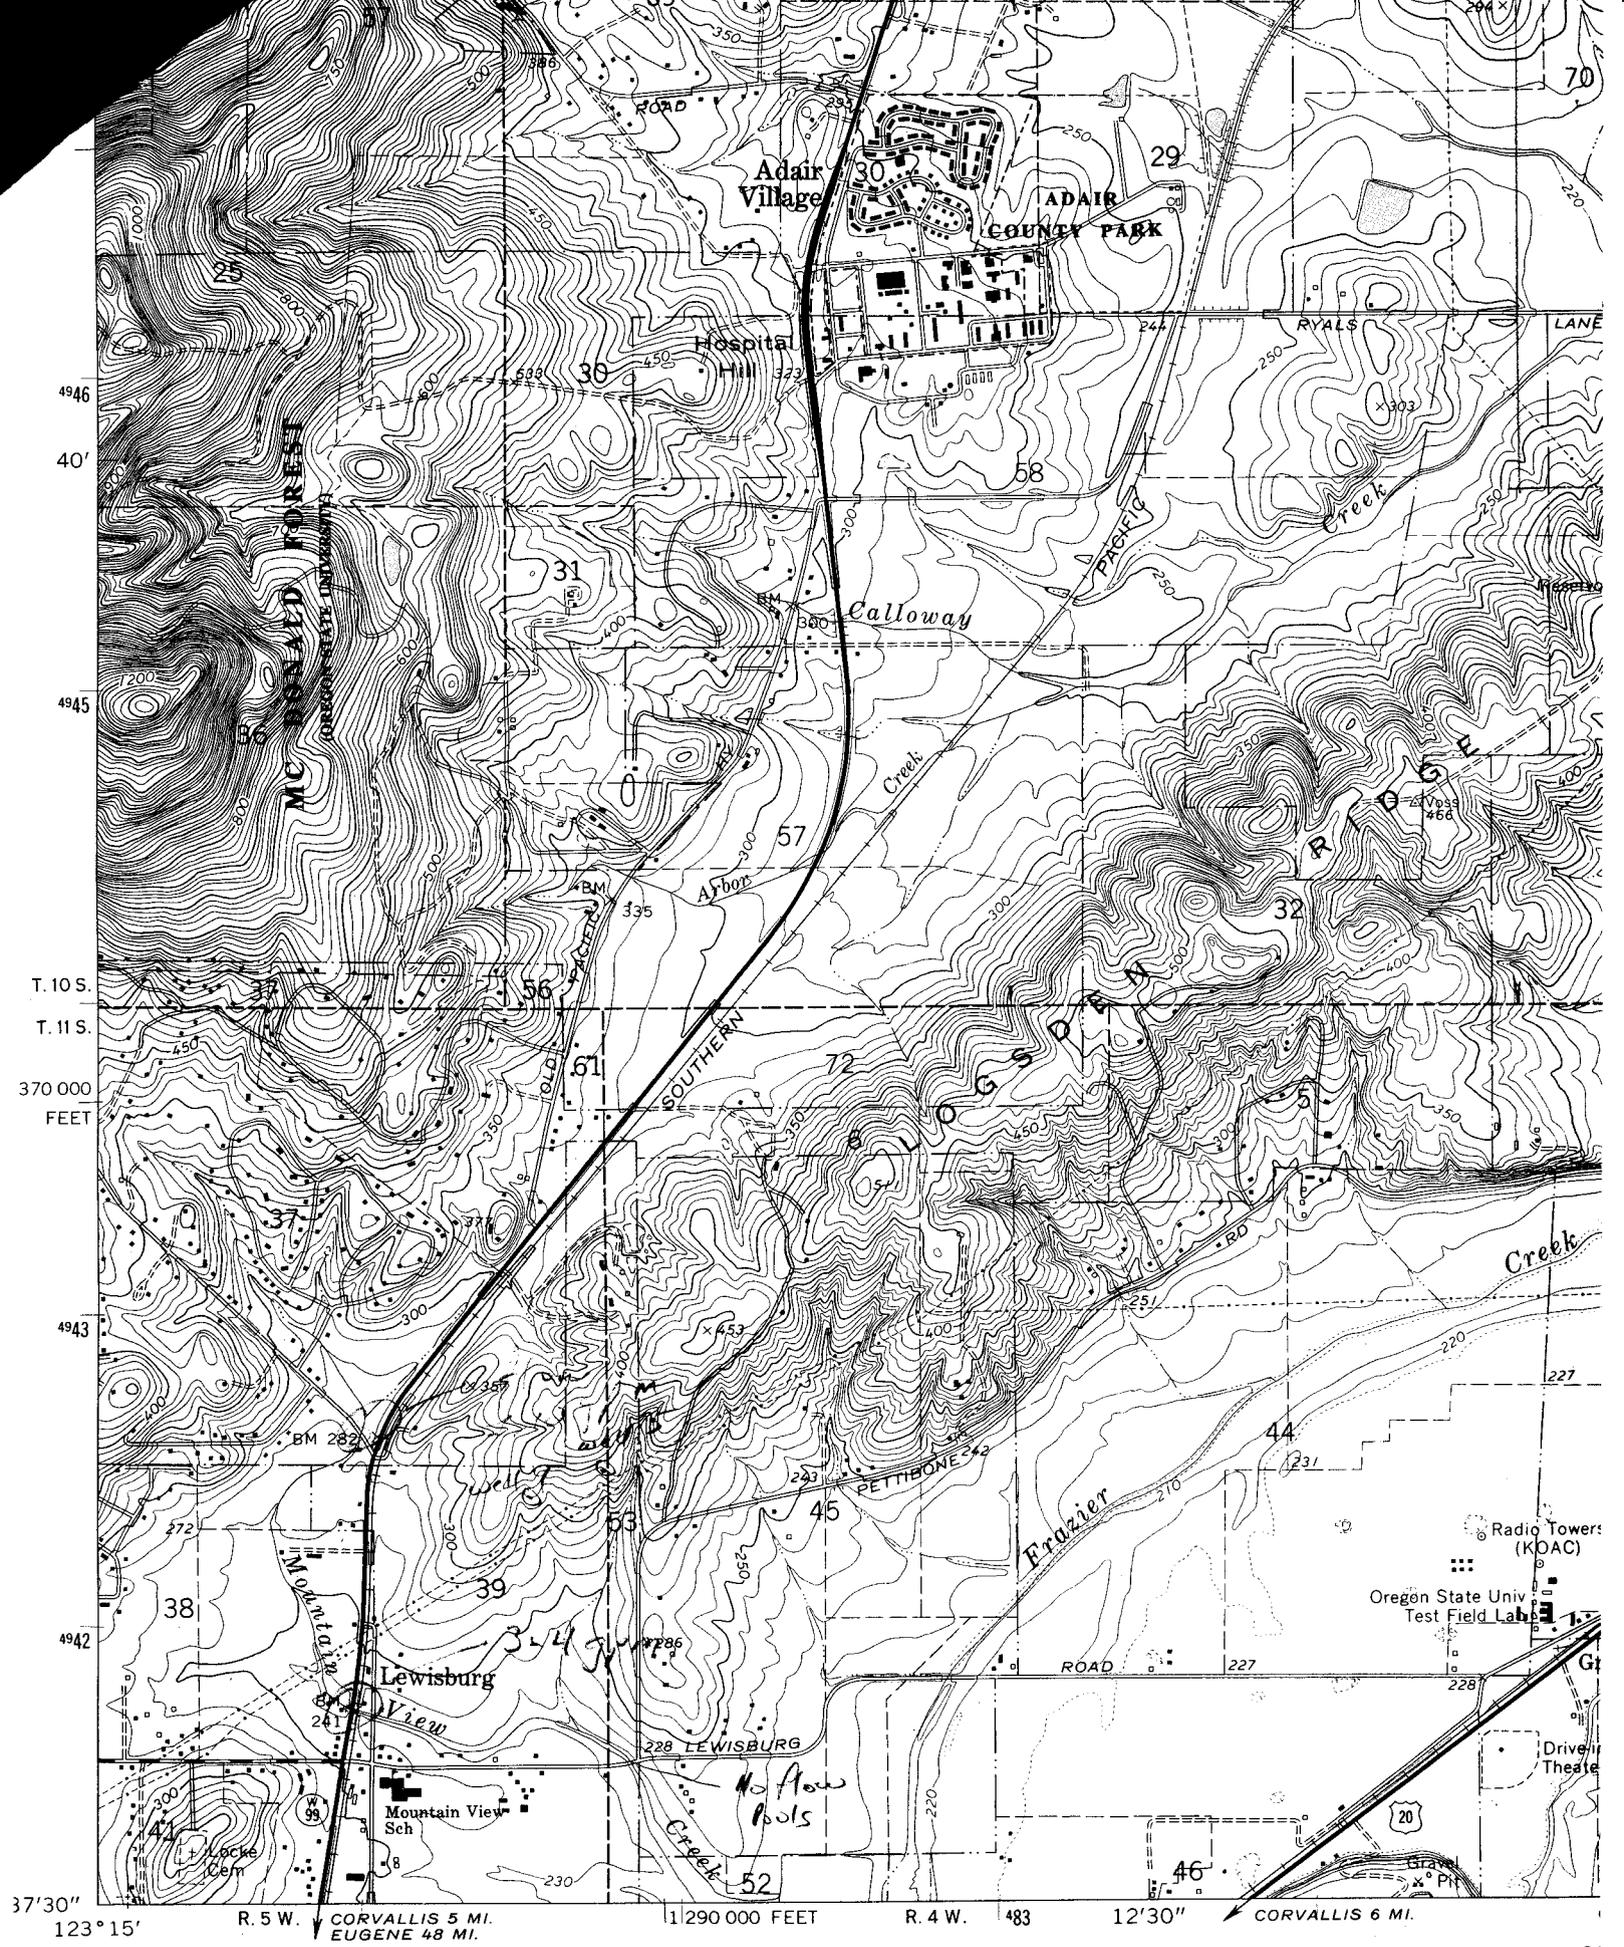

Mapped, edited, and published by the Geological Survey
 Control by USGS, USC&GS, and State of Oregon
 Topography by photogrammetric methods from aerial

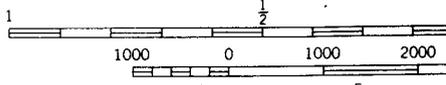

11 SE

SC