

SECTION PLAT


Section 30

Township 22-S

Range 33-E

County of Harney State of OR

NORTH

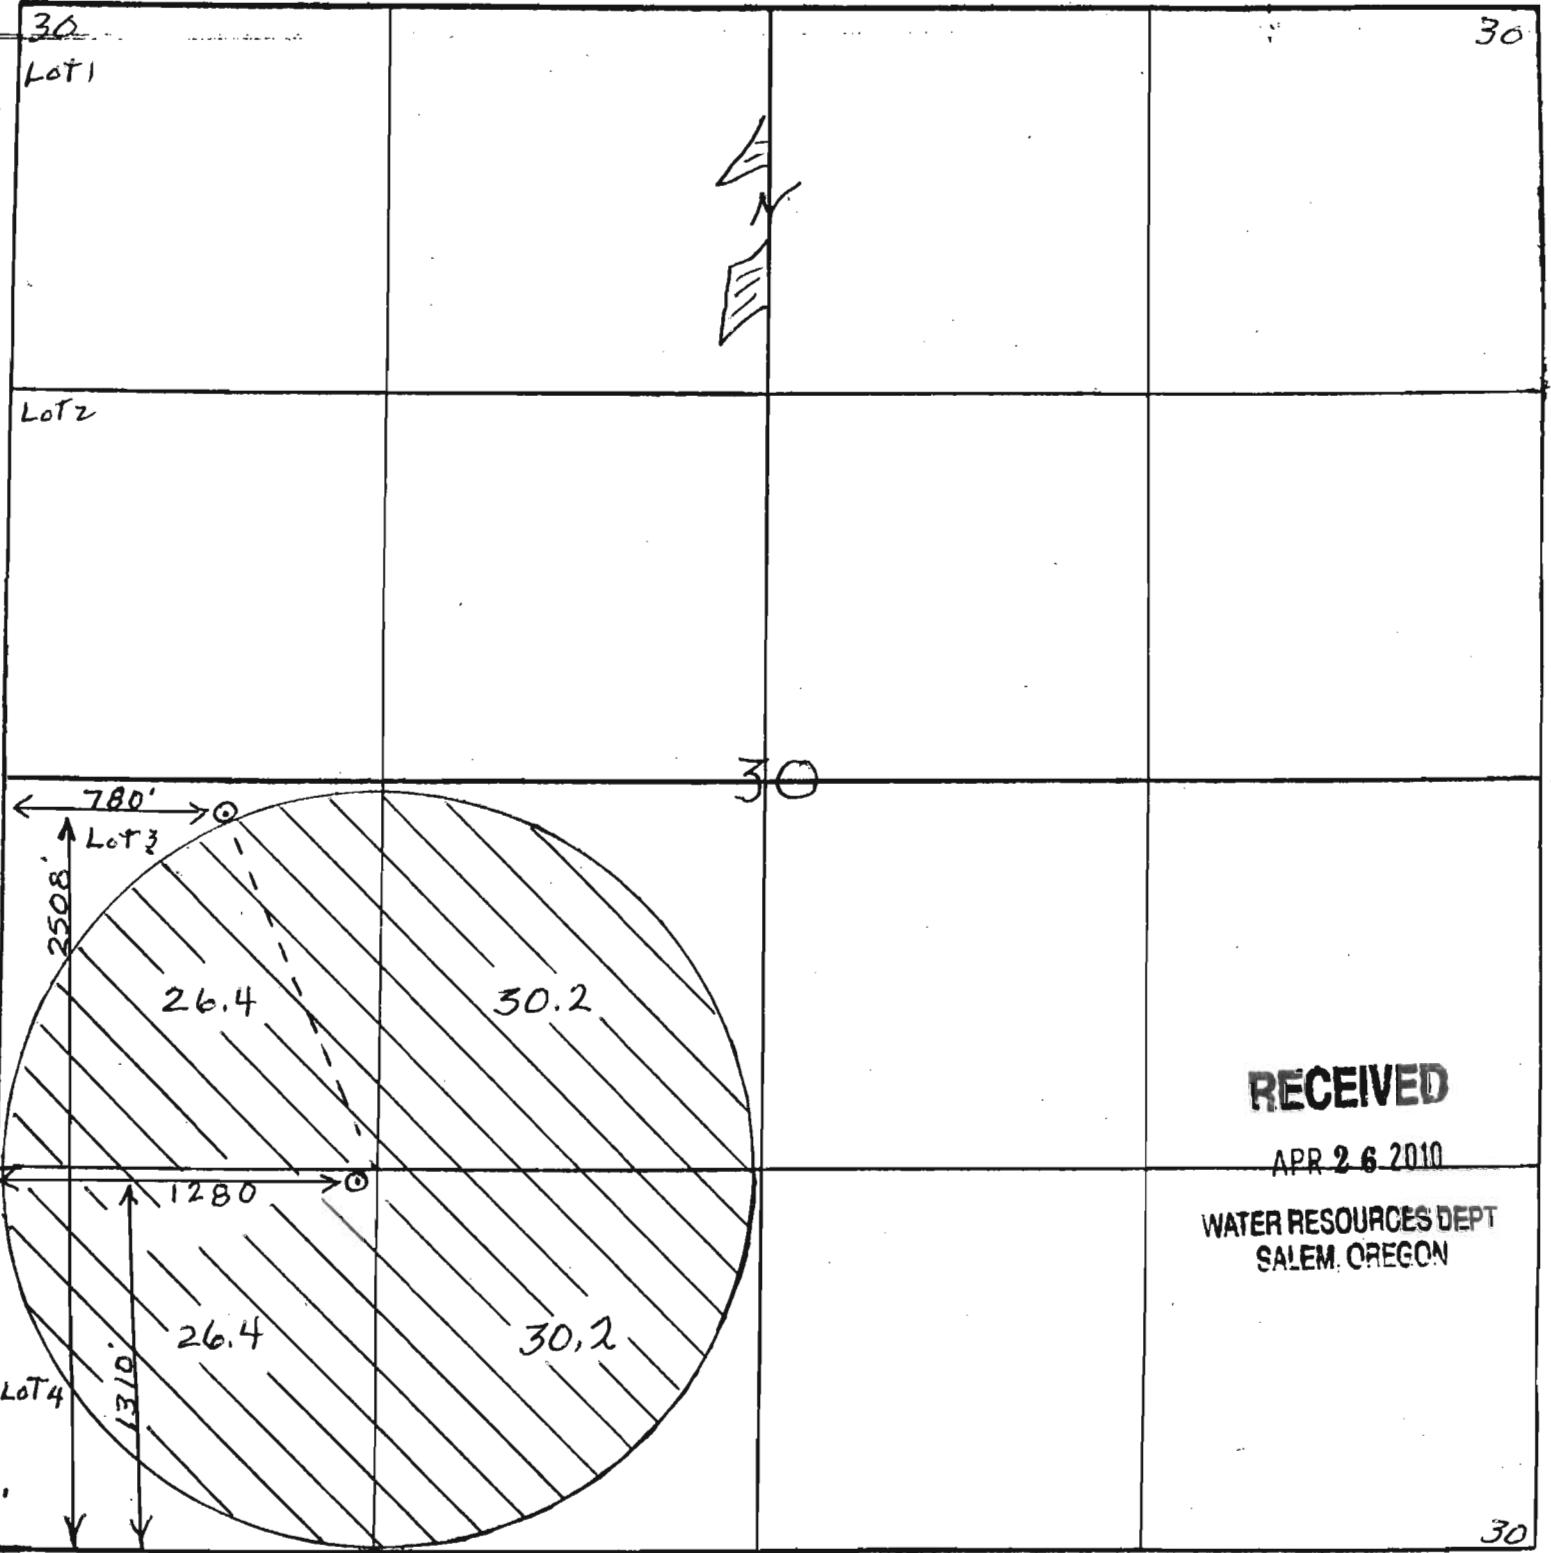

RECEIVED

APR 26 2010

WATER RESOURCES DEPT
SALEM, OREGON

G-17765

30